


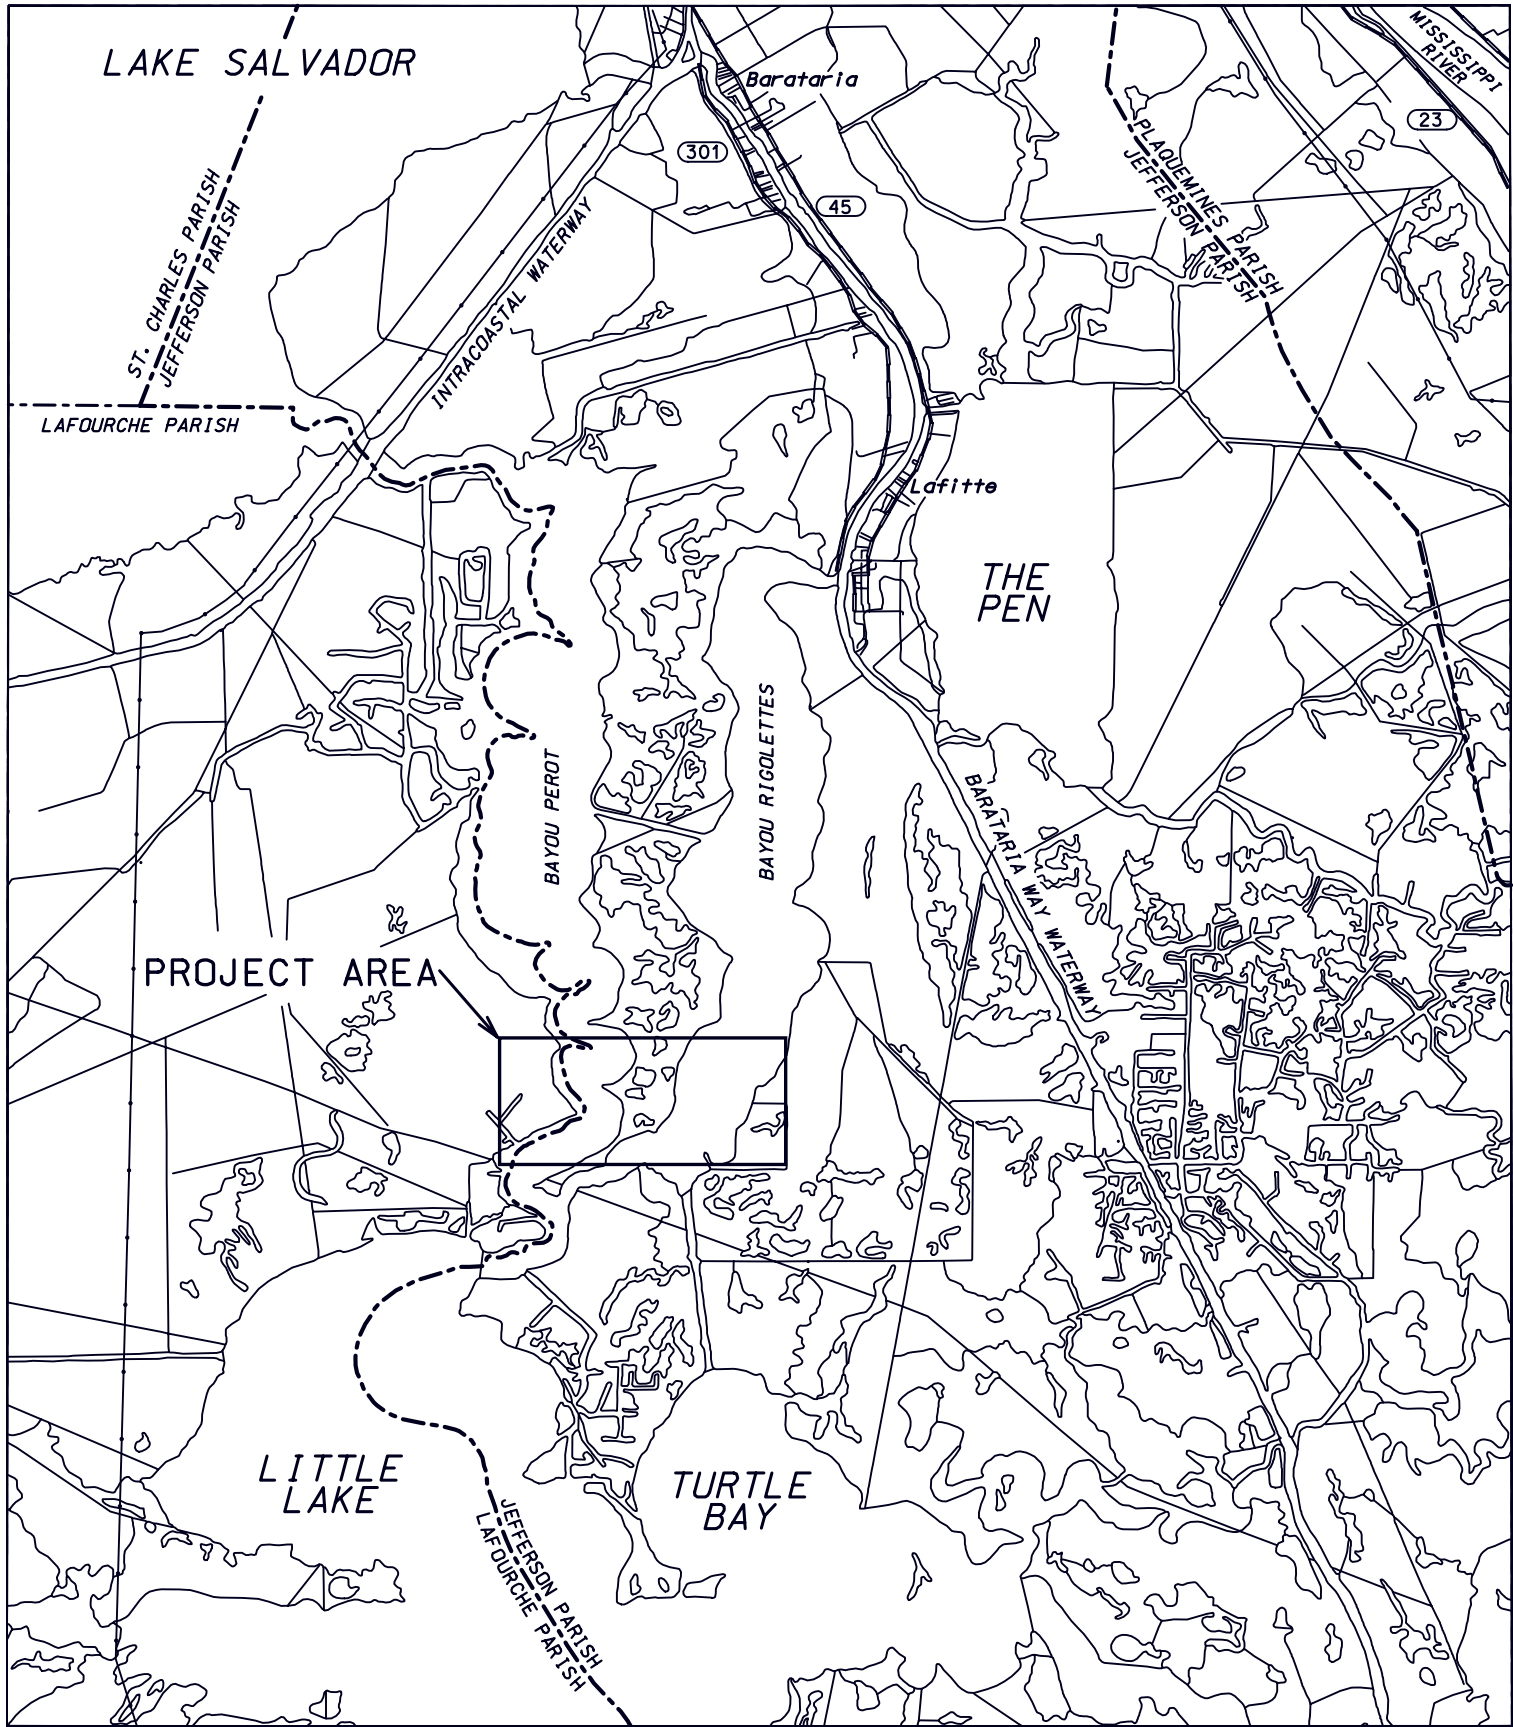

VICINITY MAP




BARATARIA BASIN LANDBRIDGE PROJECT
CONSTRUCTION UNIT 1, (BA-27)

BUILT UNDER THE
COASTAL WETLANDS
PLANNING, PROTECTION, AND
RESTORATION ACT
PUBLIC LAW 101-646

"AS-BUILT"

BY THE
LOUISIANA
DEPARTMENT OF NATURAL RESOURCES

WITH THE ASSISTANCE OF THE
NATURAL RESOURCES CONSERVATION SERVICE
OF THE
UNITED STATES DEPARTMENT OF AGRICULTURE
2000

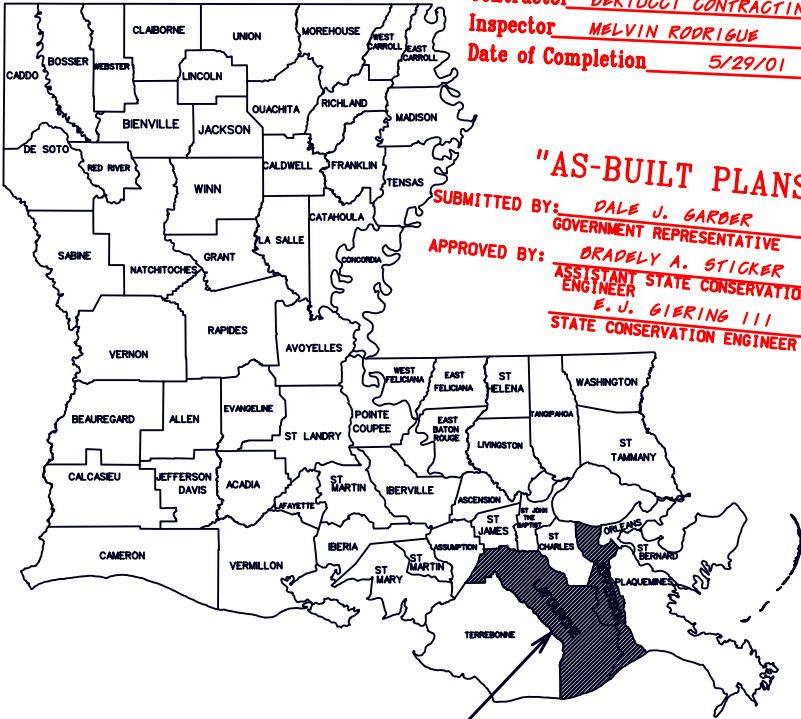

Contract No. 50-7217-1-1 Date 9/27/01
Contractor BERTUGGI CONTRACTING CORP.
Inspector MELVIN RODRIGUE
Date of Completion 5/29/01

"AS-BUILT PLANS"

SUBMITTED BY: DALE J. GARDER 9/27/01
GOVERNMENT REPRESENTATIVE DATE
APPROVED BY: BRADLEY A. STICKER 9/28/01
ASSISTANT STATE CONSERVATION ENGINEER DATE
E. J. GIERING III 9/28/01
STATE CONSERVATION ENGINEER DATE

- INDEX OF DRAWINGS
- 1 COVER SHEET
 - 2 PROJECT LOCATION MAP
 - 3 SOIL BORING LOGS
 - 4 SITE NO. 1 - PLAN LAYOUT
 - 5 SITE NO. 2 - PLAN LAYOUT
 - 6-6A DETAILS - TYPICAL SECTIONS A, A1, B, and C
 - 7-9 DETAILS - TYPICAL SECTION D
 - 10 WARNING SIGN DETAILS
 - 11 SETTLEMENT PLATE DETAILS
 - 12 ACCESS CHANNEL DETAILS



REVISIONS		COVER SHEET	
DATE	APPR.	TITLE	
		BARATARIA BASIN LANDBRIDGE PROJECT	
		BA-27 CONSTRUCTION UNIT 1	
		LAFOURCHE AND JEFFERSON PARISHES	
		LOUISIANA	
		U.S. DEPARTMENT OF AGRICULTURE - NATURAL RESOURCES CONSERVATION SERVICE	
CAD FILE NO.		LA302001	
DRAWING NO.		LA-302	
SHEET NO.		01 OF 12	

Date	Designed	Drawn	Traced	Checked	Title
04/99	L. Steve Garner	A. J. Gremillion		James N. Moore	
04/99					Approved by E. J. GIERING III
05/99					ENGINEER



BARATARIA BASIN LANDBRIDGE PROJECT

PLAN MAP



LEGEND

 T2-38 GEOTECH BORING
(REF. SHT. 3 OF 12)

REVISIONS		DATE	APPR.	TITLE

CAD FILE NO.

LA302002

DRAWING NO.

LA-302


Sht. 02 of 12

PLAN MAP
BARATARIA BASIN LANDBRIDGE PROJECT
BA-27 CONSTRUCTION UNIT 1
LAFOURCHE AND JEFFERSON PARISHES
LOUISIANA

U.S. DEPARTMENT OF AGRICULTURE - NATURAL RESOURCES CONSERVATION SERVICE


Designed by L. Steve Garner	Date 12/97	Approved by State Conservation Engineer Alexander G. Louisiana	Date
Drawn A.J. Gremillion	12/97	Title	
Traced			
Checked James N. Moore	12/97	Title	

AS-BUILT

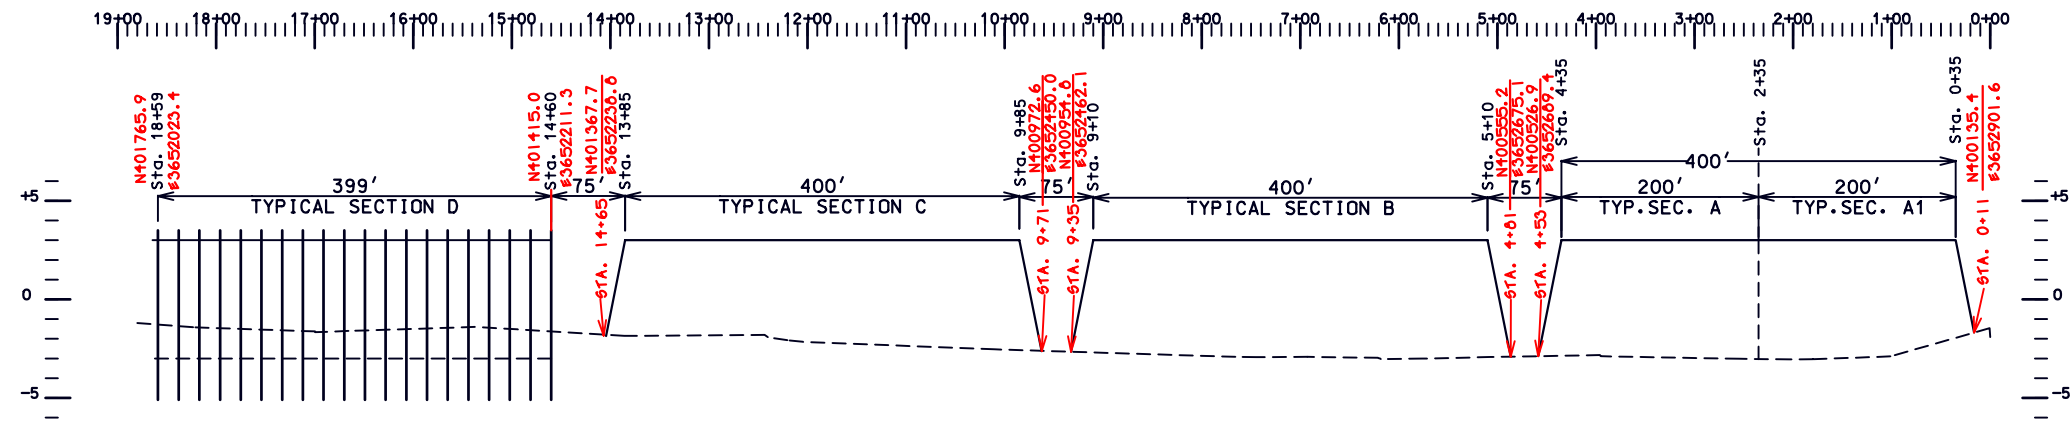

SITE NO.1 – BAYOU PEROT

PROFILE ALONG CENTERLINE

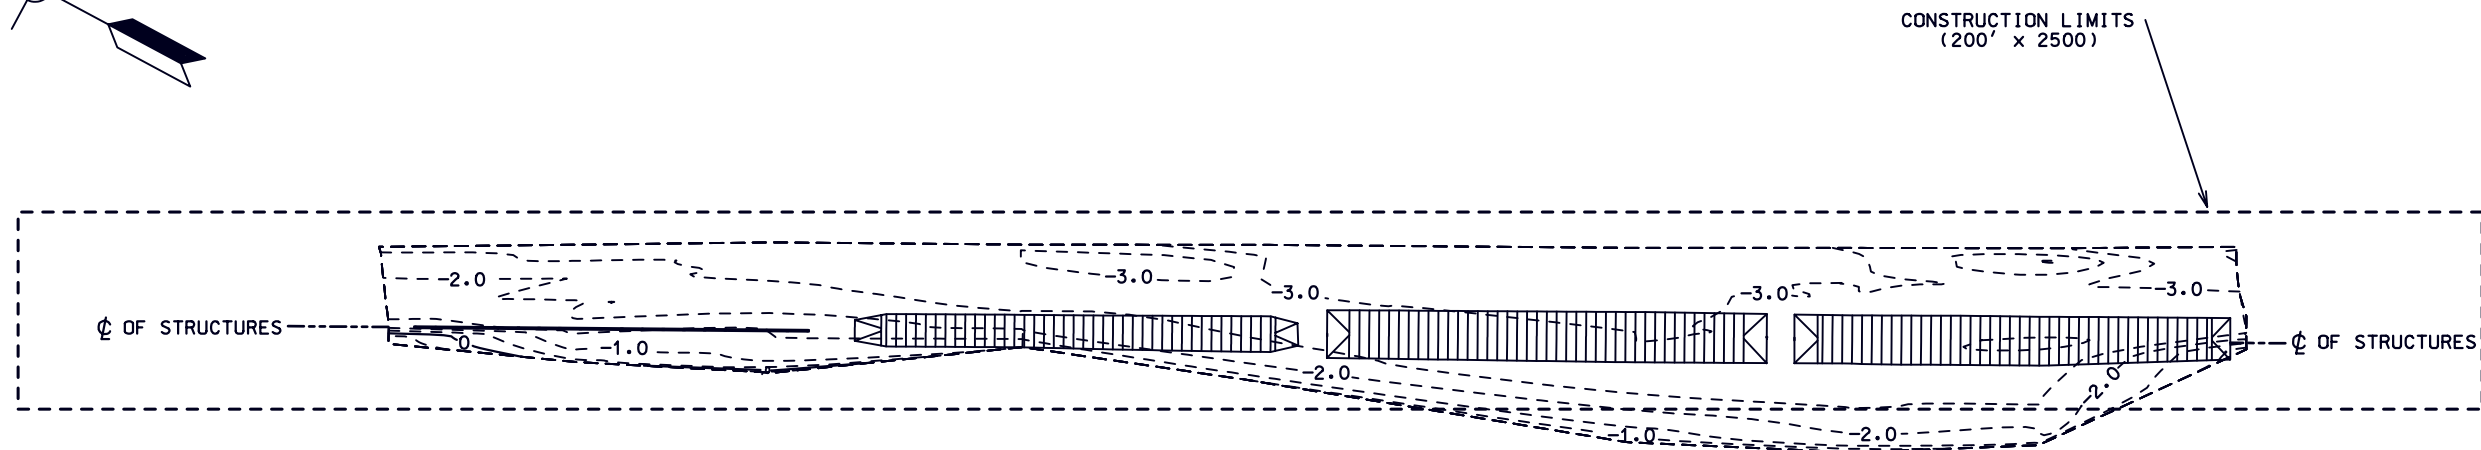

SITE NO.1 – BAYOU PEROT

<u>SITE NO.1 – SECTION "A" ROCK</u>		ACTUAL
ROCK RIPRAP	5055 Tons	5739 TONS
GEOTEXTILE	2810 Sq. Yds.	2812 SQ. YDS.

SITE NO.1 – SECTION "B" COMPOSITE

ROCK RIPRAP	3295 Tons	2400 TONS
LWA	1280 Cy.	1400 CY
GEOTEXTILE	2840 Sq. Yds.	2812 SQ. YDS.

SITE NO.1 – SECTION "C" FURROW




ROCK RIPRAP	2945 Tons	2885 TONS
LWA	530 Cy	552 CY
GEOTEXTILE	1970 Sq. Yds.	2210 SQ. YDS.

CONTOUR LINES AT 0.5' INTERVALS



"AS-BUILT"

CAD FILE NO. LA302004		SITE NO. 1 - PLAN LAYOUT BARATARIA BASIN LANDBRIDGE PROJECT BA-27 CONSTRUCTION UNIT 1 LAFOURCHE AND JEFFERSON PARISHES LOUISIANA		Designed <u>L. Steve Garner</u>		Date 12/97
DRAWING NO. LA-302		U.S. DEPARTMENT OF AGRICULTURE - NATURAL RESOURCES CONSERVATION SERVICE		Drawn <u>A.J. Gremillion</u>		Date 12/97
				Traced _____		
				Checked <u>James N. Moore</u>		12/97
				Title _____		
				Approved by _____		
				Store Conservation Engineer		
				Nacogdoches, Louisiana		

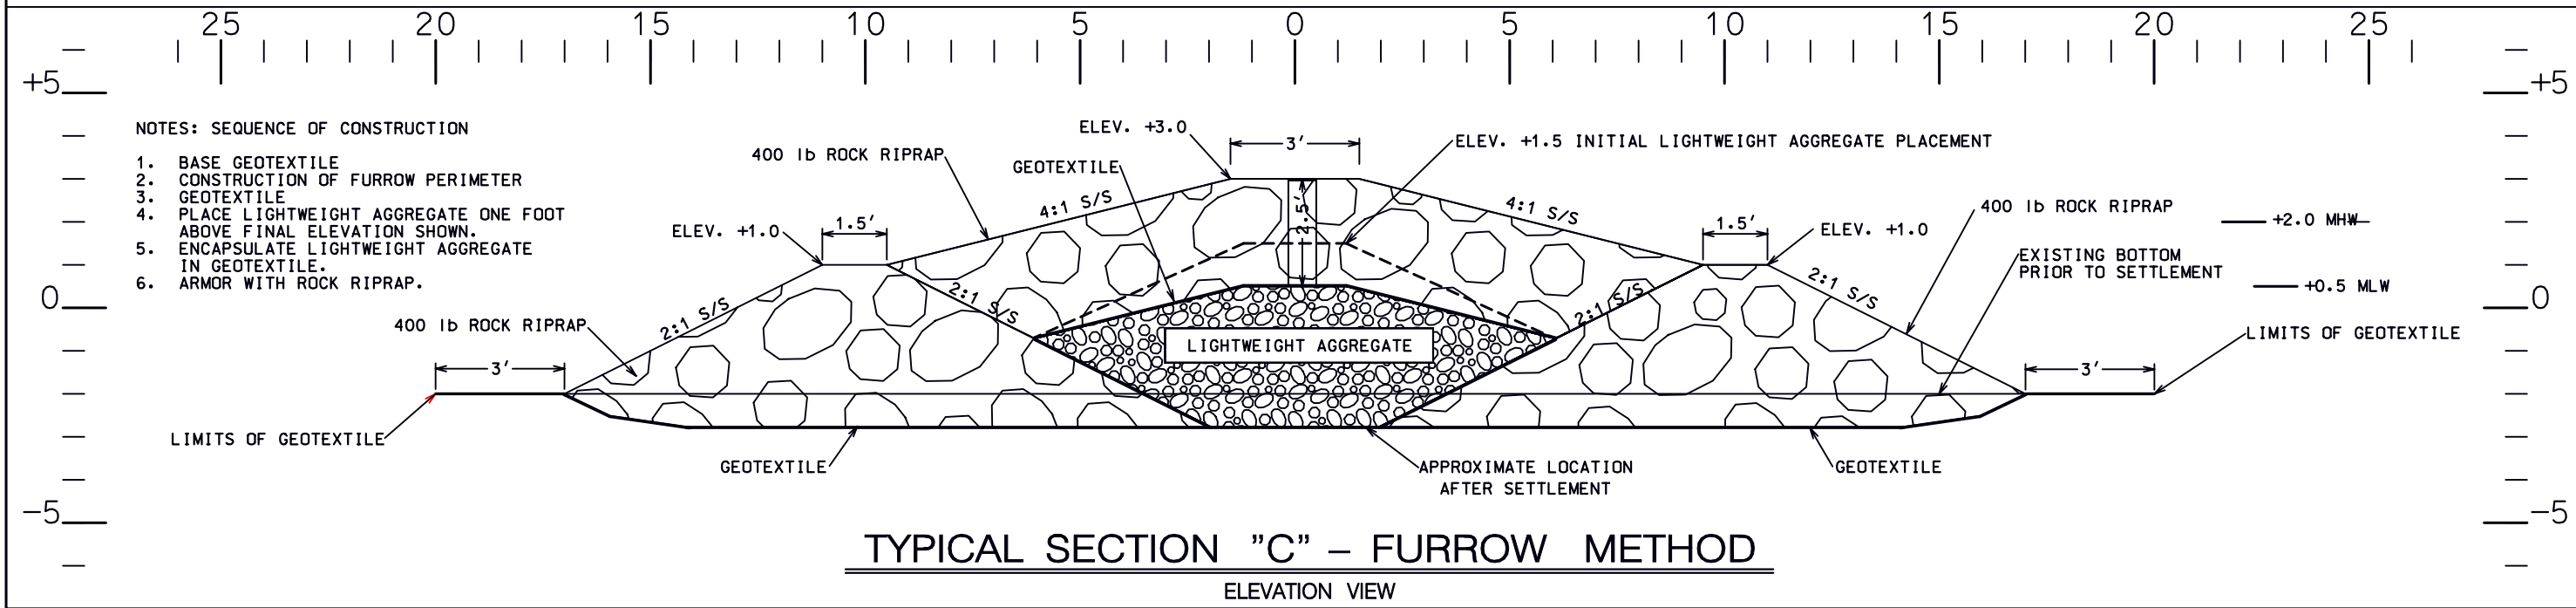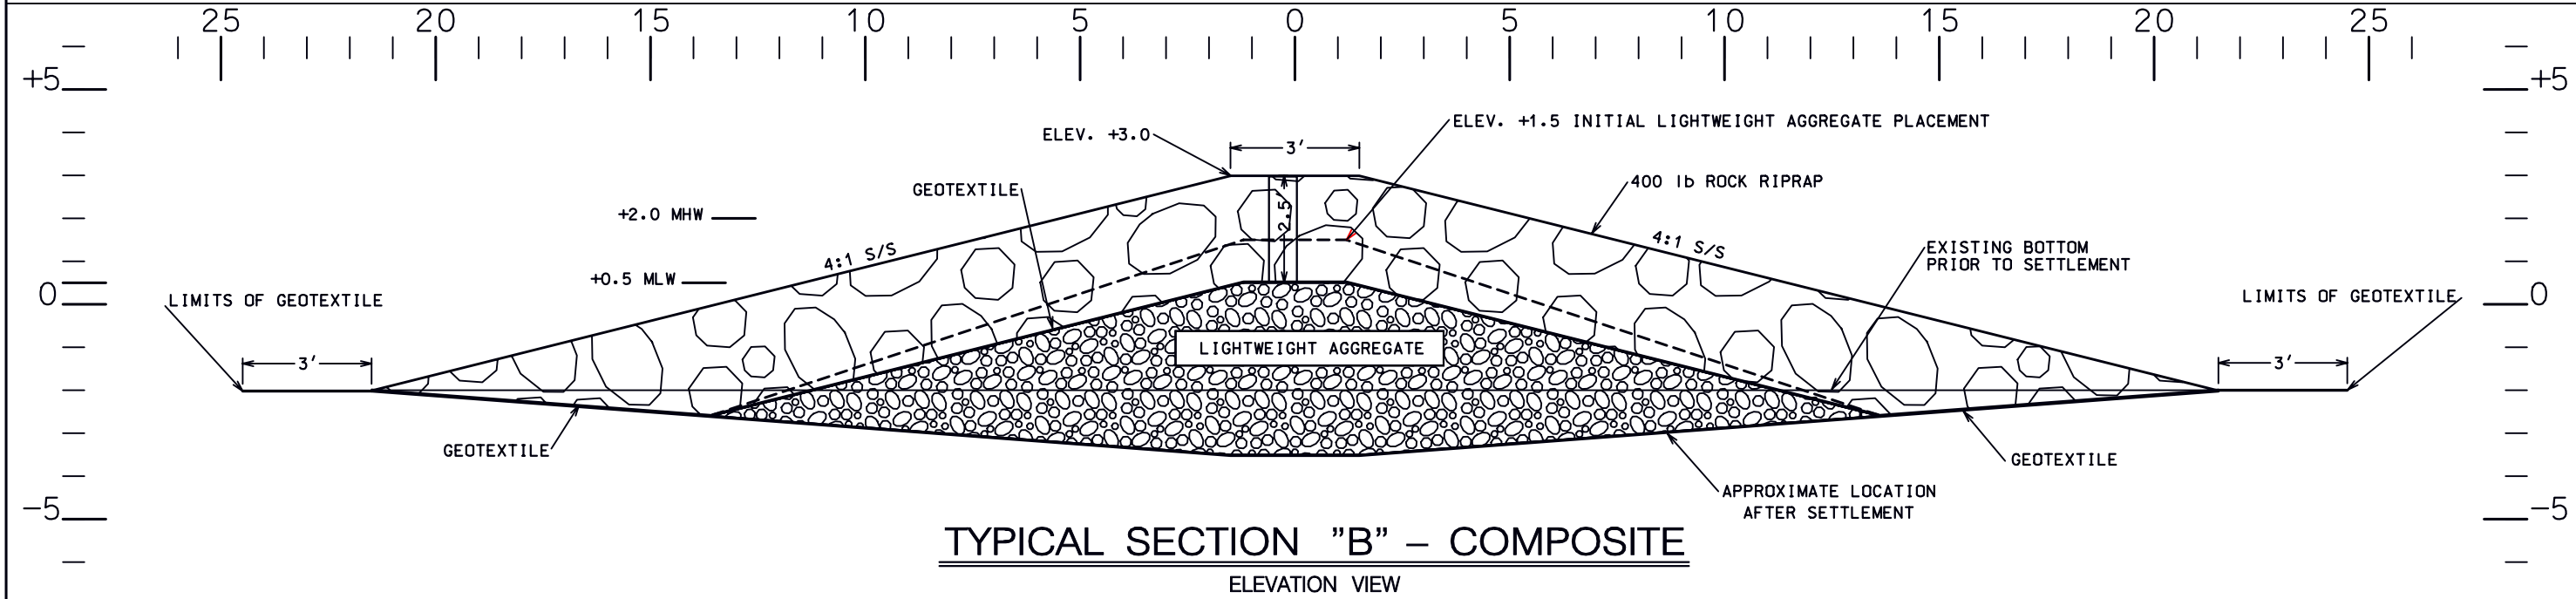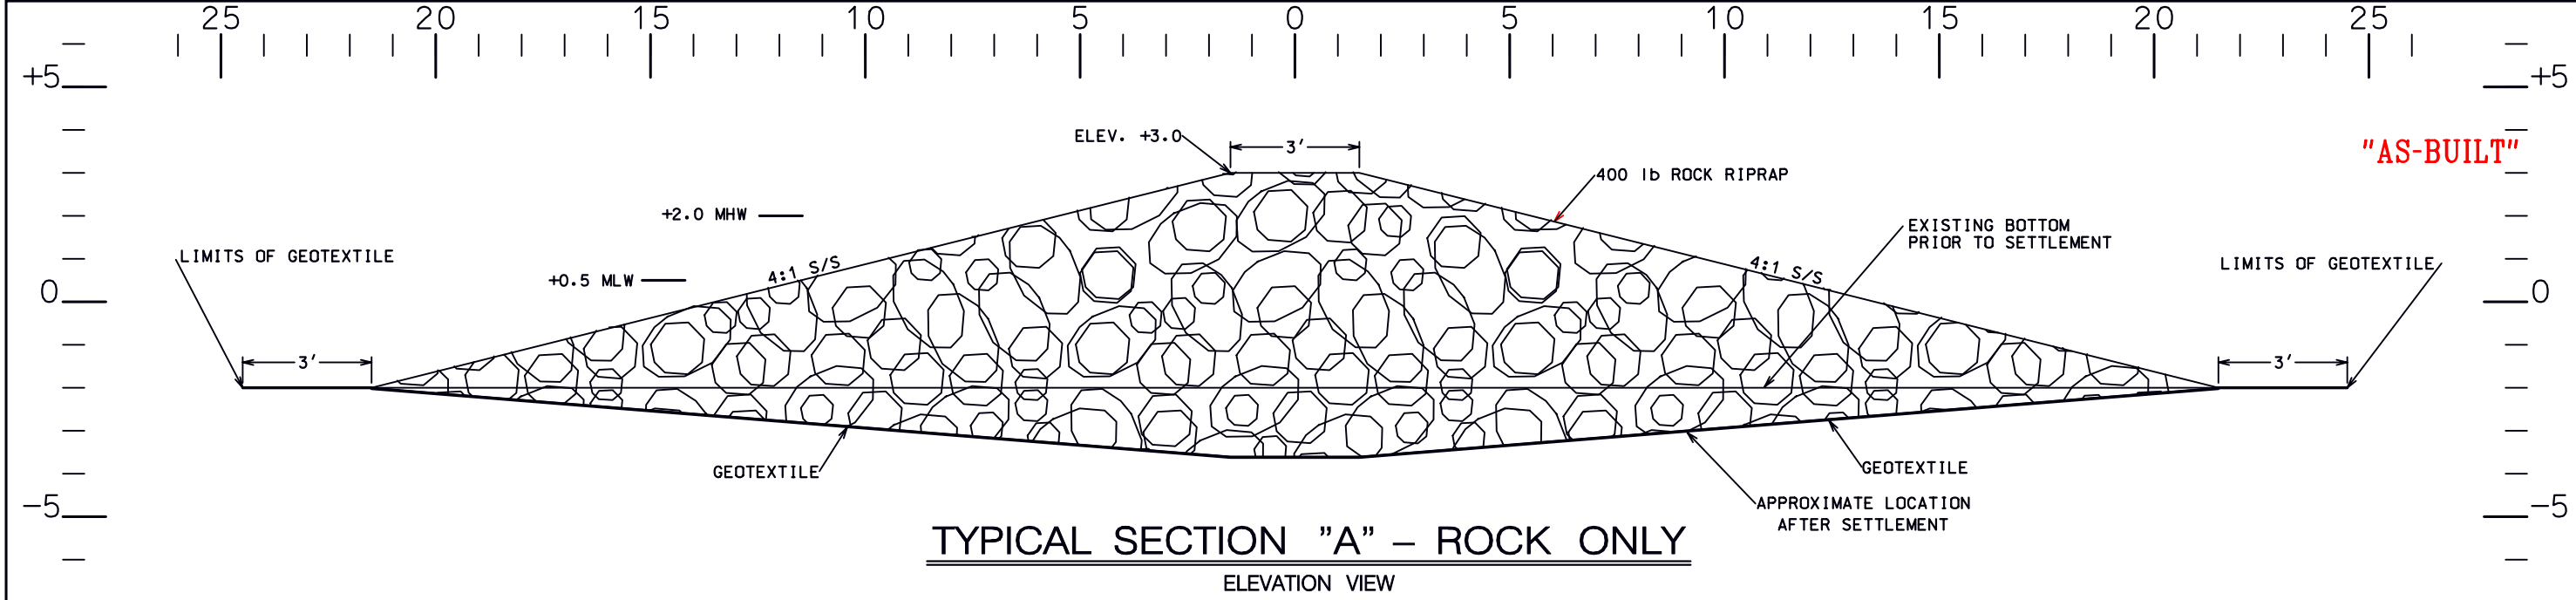

- NOTES: SEQUENCE OF CONSTRUCTION
1. BASE GEOTEXTILE
 2. CONSTRUCTION OF FURROW PERIMETER
 3. GEOTEXTILE
 4. PLACE LIGHTWEIGHT AGGREGATE ONE FOOT ABOVE FINAL ELEVATION SHOWN.
 5. ENCAPSULATE LIGHTWEIGHT AGGREGATE IN GEOTEXTILE.
 6. ARMOR WITH ROCK RIPRAP.

REVISIONS		TITLE	
DATE	APPR.	DATE	APPR.

CAD FILE NO. LA302006
DRAWING NO. LA-302
Sht. 06 of 12

U.S. DEPARTMENT OF AGRICULTURE – NATURAL RESOURCES CONSERVATION SERVICE

TYPICAL SECTIONS "A", "B", "C" DETAILS
BARATARIA BASIN LANDBRIDGE PROJECT
BA-27 CONSTRUCTION UNIT 1
LAFOURCHE AND JEFFERSON PARISHES
LOUISIANA

Designed L. Steve Garner
Drawn A.J. Gremillion
Traced
Checked James N. Moore

Date 4/99
Approved by Ed Gierling III 5/99
State Conservation Engineer
Title
Title






PLAN VIEW



NOTE: CONCRETE REPAIR ON CHIPPED AREAS WAS MADE USING "SIKADUR 33" EPOXY.



TYPICAL SECTION "D" DETAILS
BARATARIA BASIN LANDBRIDGE PROJECT
BA-27 CONSTRUCTION UNIT 1
LAFOURCHE AND JEFFERSON PARISHES
LOUISIANA

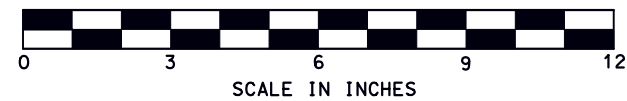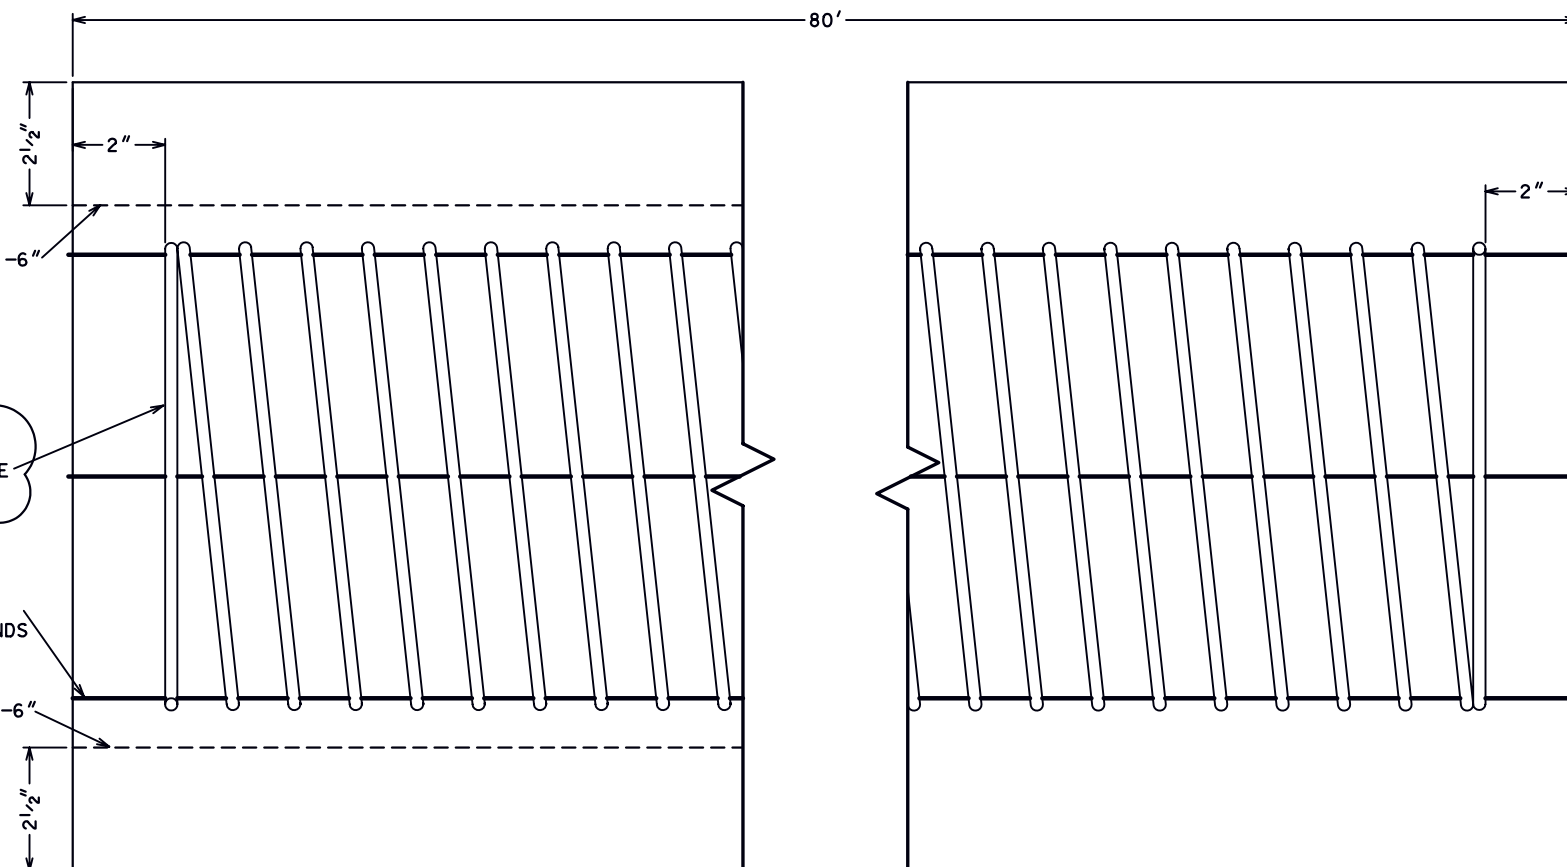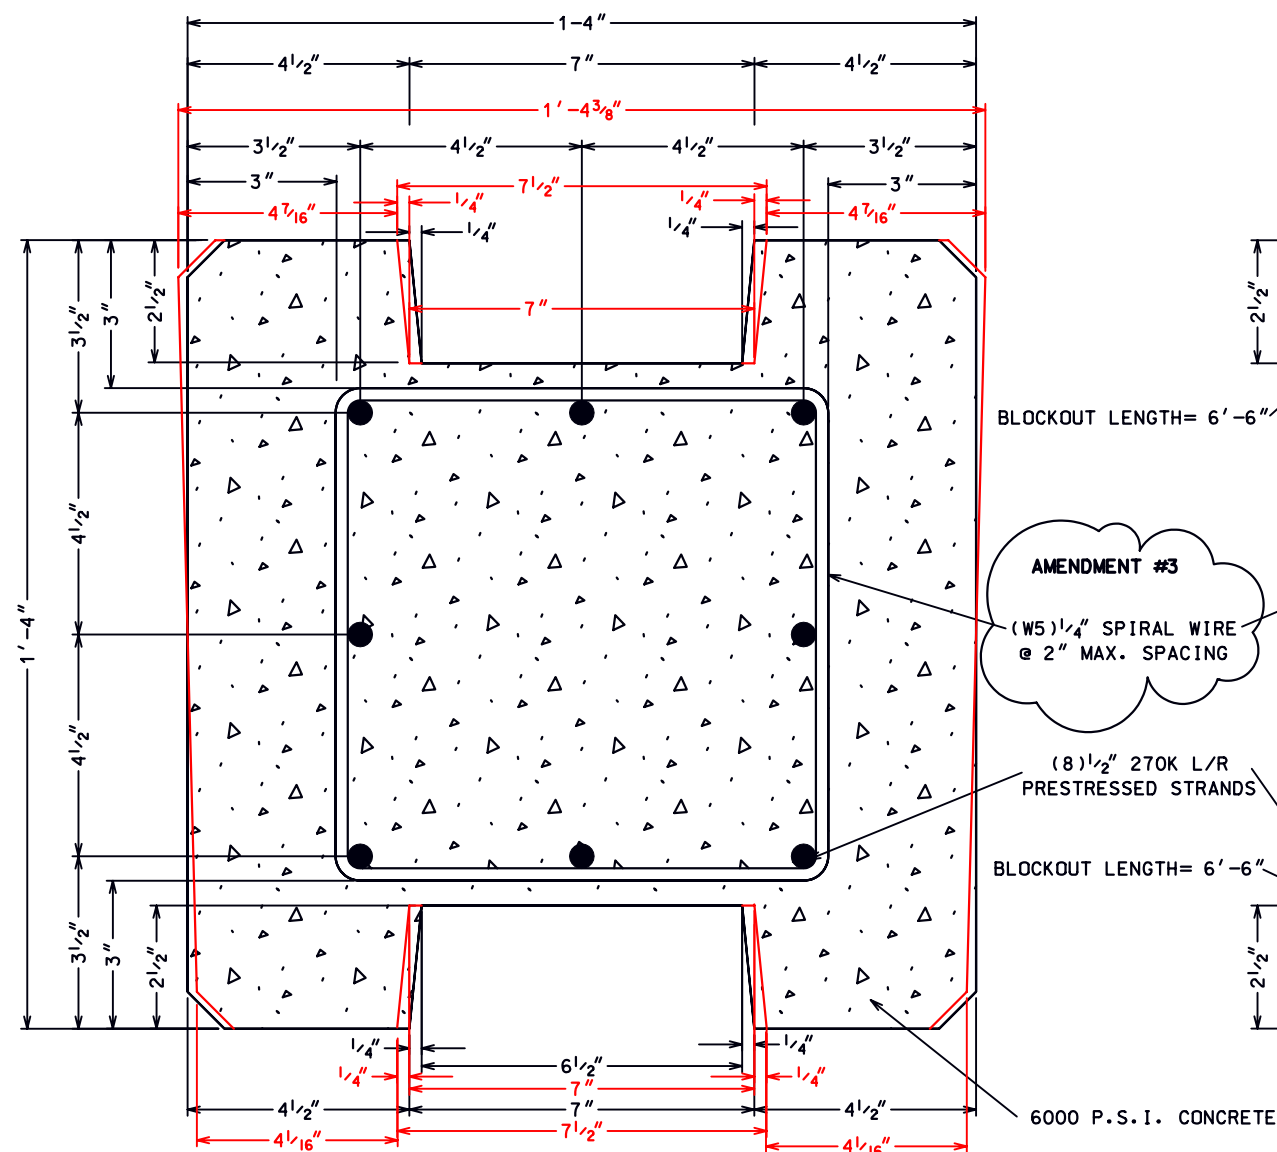

"AS-BUILT"

REVISIONS			
NO.	DATE	APPR.	TITLE
AMEN 3	9/29/00	E.G.	ASTC/ES

CAD FILE NAME
LA30200


DRAWING NO

LA-302
Sht. 08 o


TYPICAL SECTION "D" DETAILS
BARATARIA BASIN LANDBRIDGE PROJECT
BA-27 CONSTRUCTION UNIT 1
LAFOURCHE AND JEFFERSON PARISHES
LOUISIANA

U.S. DEPARTMENT OF AGRICULTURE - NATURAL RESOURCES CONSERVATION SERVICE

Date	Date
Designed L. Steve Garner	4/99
Drawn A. J. Gremillion	4/99
Traced	
Approved by Ed Giering, III	5/99
State Conservation Engineer	
Alexander J. Collins	
Title	

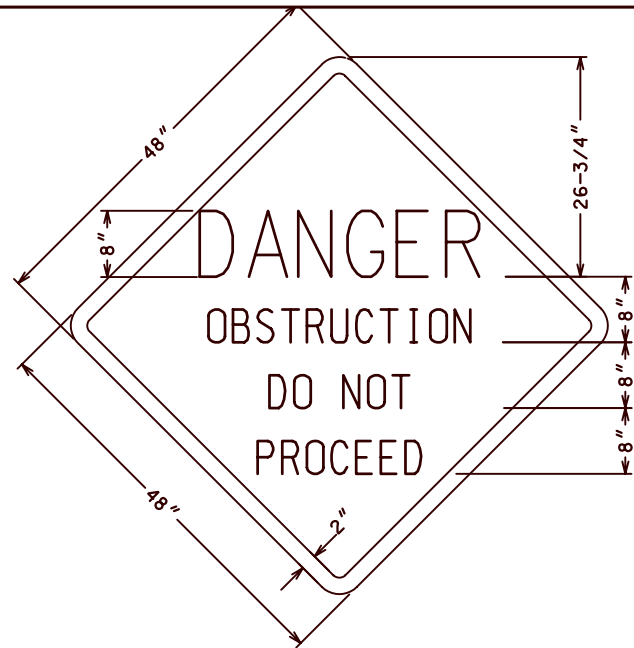


SIGN DETAIL
(NOT TO SCALE)

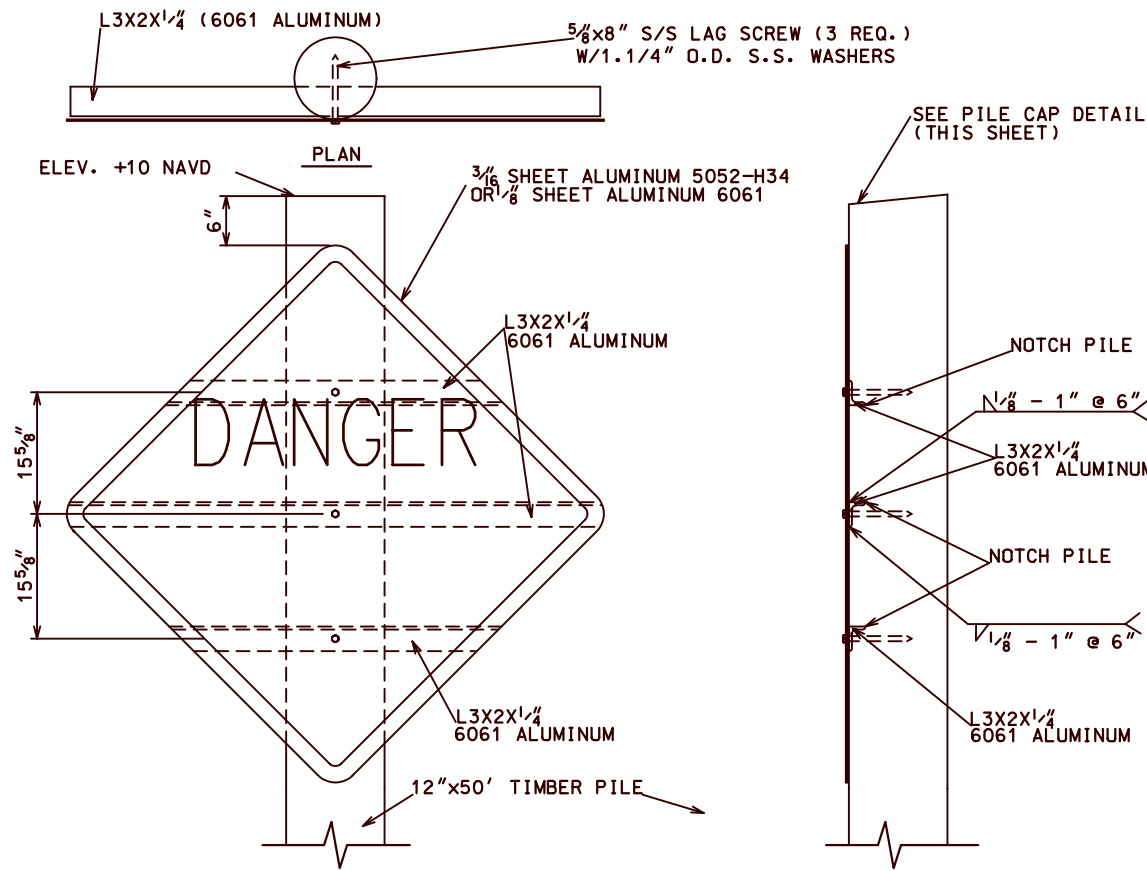


ELEVATION VIEW
(SIGN TYPE A; SUPPORT TYPE I)

SIDE VIEW
(SIGN TYPE A; SUPPORT TYPE I)

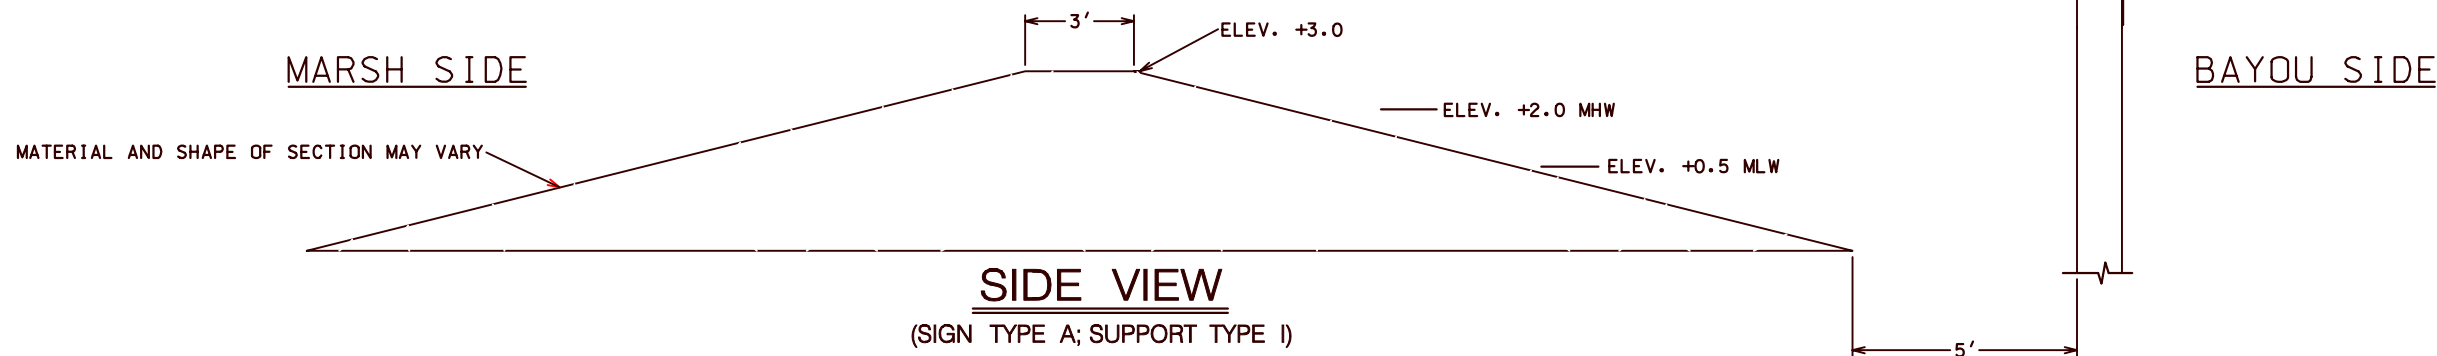

SIDE VIEW
(SIGN TYPE A; SUPPORT TYPE I)

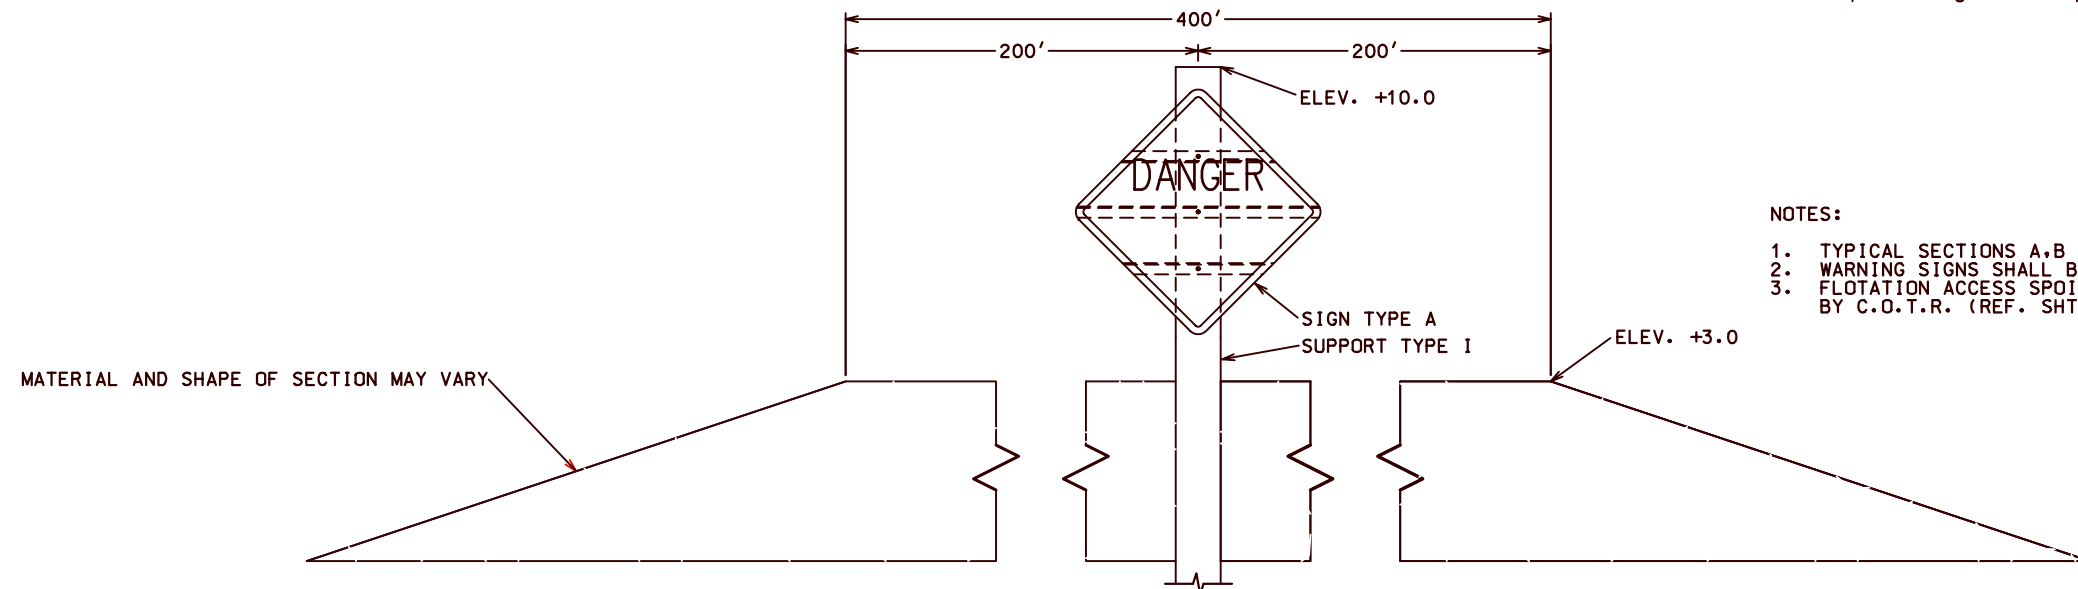


ELEVATION VIEW
(SIGN TYPE A; SUPPORT TYPE I)

1. THE 2" BORDER ON THE TYPE "A" WARNING SIGN SHALL BE A REFLECTIVE MATERIAL OF ORANGE COLOR. THE LETTERING FIELD SHALL BE A RETRO-REFLECTIVE MATERIAL OF WHITE COLOR. THE LETTERING FOR THE WARNING SIGNS SHALL BE BLACK. WARNING SIGNS SHALL BE PLACED ON THE SIDE FACING THE BAYOU.


SITE NO.	SIGN TYPE	SUPPORT TYPE	NO. OF SIGNS
1	A	I	6
2	A	I	6

"AS-BUILT"

COAT TOP OF PILE WITH COAL TAR EPOXY PAINT
PRIOR TO PLACING CAP
24"x24"x.025" ALUMINUM FLASHING
(ATTACH USING ALUMINUM OR STAINLESS STEEL NAILS)

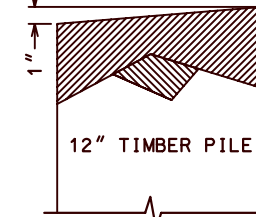

TYPICAL TIMBER PILE CAP
(NOT TO SCALE)

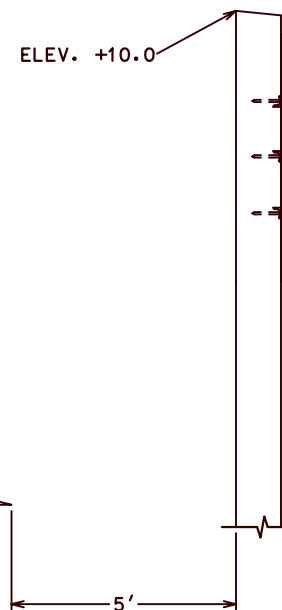

NOTES:

1. TYPICAL SECTIONS A,B & C WARNING SIGNS SHALL BE PLACED AS SHOWN.
2. WARNING SIGNS SHALL BE PLACED 25' IN FRONT OF TYPICAL SECTION D.
3. FLOTATION ACCESS SPOIL WARNING SIGNS SHALL BE PLACED AS DIRECTED BY C.O.T.R. (REF. SHT 12 OF 12)

Date	3/98	Approved by	F. J. GIERING, III
Designed	L. Steve Garner	Title	STATE CONSERVATION ENGINEER
Drawn	A. J. Gremillion	Title	STATE CONSERVATION ENGINEER
Traced	James N. Moore	Title	STATE CONSERVATION ENGINEER
Checked	James N. Moore	Title	STATE CONSERVATION ENGINEER

WARNING SIGN DETAILS
BARATARIA BASIN LANDBRIDGE PROJECT
BA-27 CONSTRUCTION UNIT 1
LAFOURCHE AND JEFFERSON PARISHES
LOUISIANA

U.S. DEPARTMENT OF AGRICULTURE - NATURAL RESOURCES CONSERVATION SERVICE


DATE	APPR.	TITLE

CAD FILE NO. LA302010
DRAWING NO. LA-302
SHEET NO. 10 OF 12


TYPICAL LOCATION – TYPICAL SECTIONS A, B & C

NOT TO SCALE

'AS-BUILT'

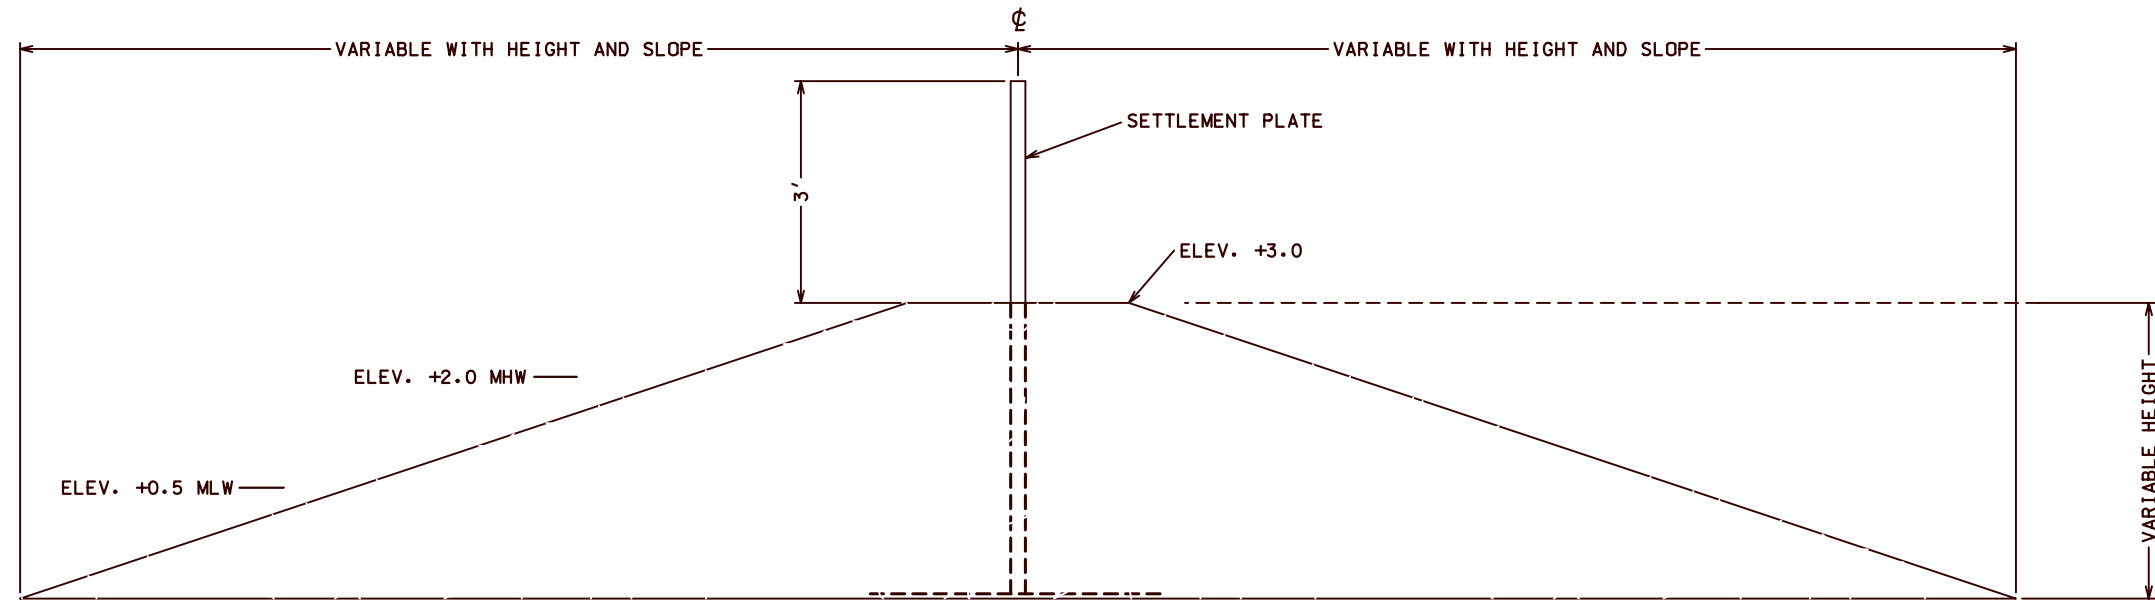


TYPICAL ELEVATION – TYPICAL SECTION A, B & C
NOT TO SCALE

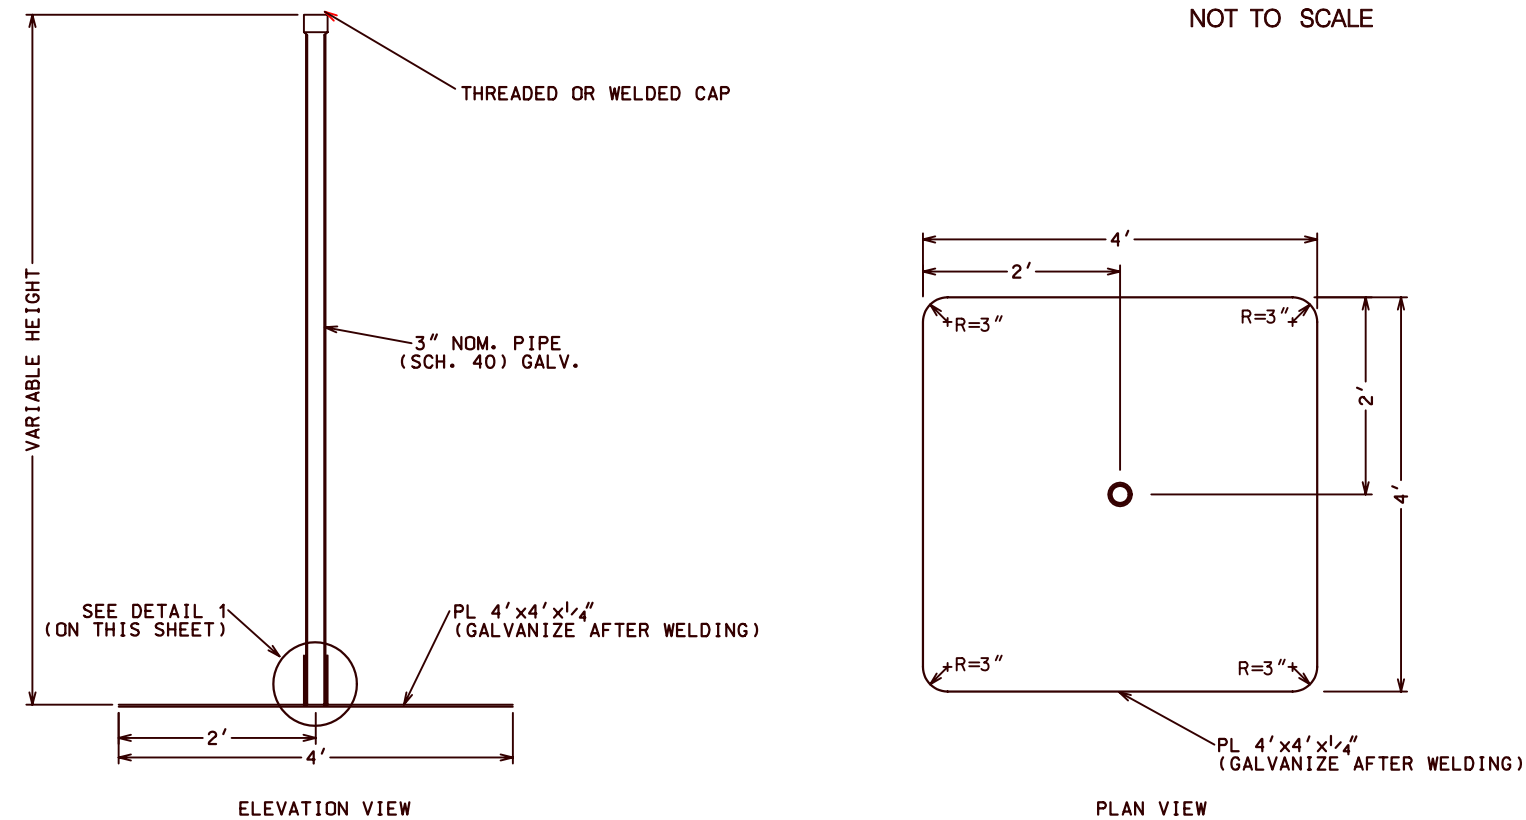

SETTLEMENT PLATE DETAILS

(NOT TO SCALE)

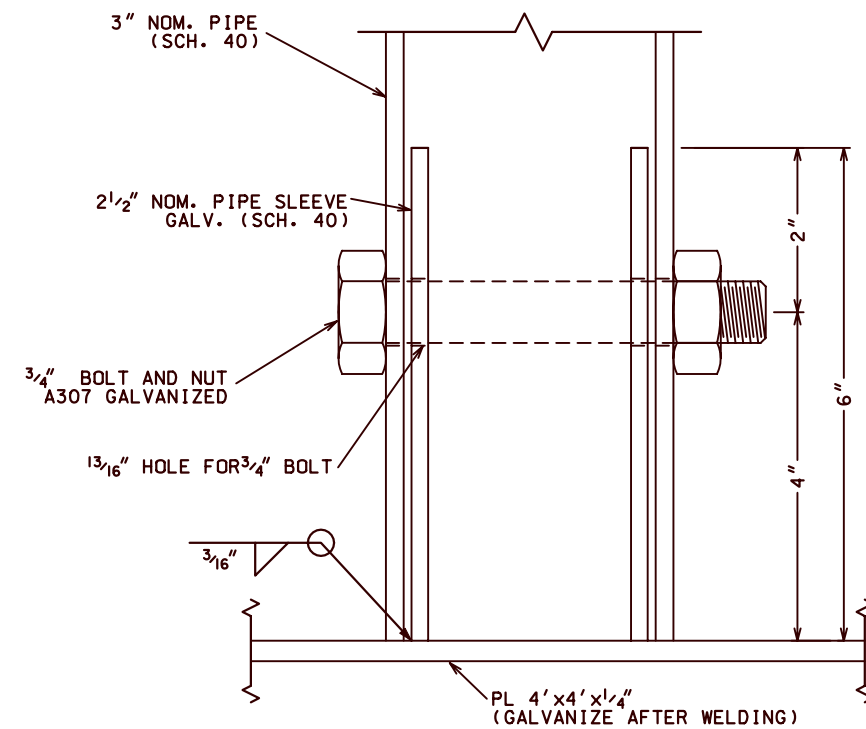

DETAIL 1 – 6"PIPE SLEEVE
(NOT TO SCALE)


[illegible]

SETTLEMENT PLATE DETAILS
BARATARIA BASIN LANDBRIDGE PROJECT
BA-27 CONSTRUCTION UNIT 1
LAFOURCHE AND JEFFERSON PARISHES
LOUISIANA
CUL TURE - NATURAL RESOURCES CONSERVATION SERVICE

U.S. DEPARTMENT OF AGRICULTURE - NATURAL RESOURCES CONSERVATION SERVICE

	Date
Designed <u>L. Steve Garner</u>	3/98
Drawn <u>A. J. Gremillion</u>	3/98
Traced _____	_____
Checked <u>James N. Moore</u>	4/98

Approved by E. J. GIERING, III
 Title STATE CONSERVATION ENGINEER
ALEXANDRIA, LOUISIANA
 Date _____

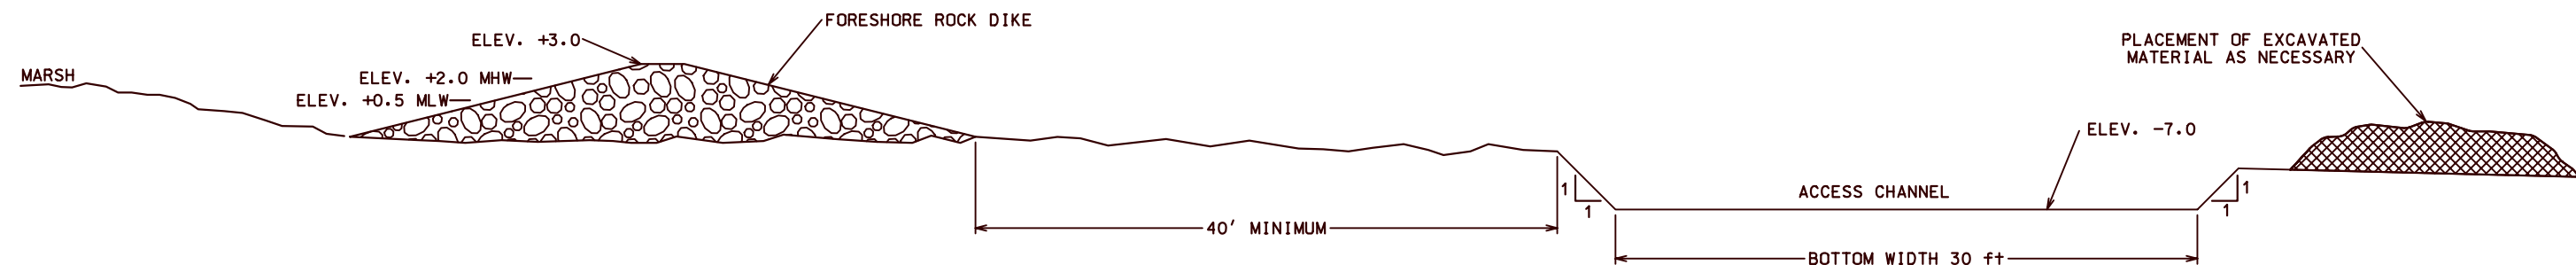

TYPICAL SECTION – ACCESS CHANNEL
(NOT TO SCALE)

NOTES:

1. ALL ELEVATION SHOWN IN NAVD.
2. TOTAL LENGTH TO BE DETERMINED BY CONSTRUCTION LIMITS. (REF. SHT 4 & 5 OF 12)
3. EXCAVATED MATERIAL WILL BE PLACED IN OPEN WATER AREAS (NOT ON EXISTING EMERGENT MARSH).
4. FLOTATION ACCESS CHANNEL SPOIL SHALL BE PULLED BACK INTO THE ACCESS CHANNEL PRIOR TO FINAL INSPECTION.
5. FLOTATION ACCESS SPOIL WARNING SIGNS (REF. SHT. 10 OF 12) SHALL BE EVENLY SPACED APART AND BE PLACED AS DIRECTED BY THE COTR. UPON COMPLETION OF ALL PROJECT FEATURES THESE SIGNS SHALL BE SALVAGED IN THEIR ENTIRETY INCLUDING ROUND TIMBER PILE AND SHALL BE MOVED BY THE CONTRACTOR TO THE SALVAGE SITE AS DIRECTED BY THE COTR.




REVISIONS		TITLE
DATE	APPR.	

ACCESS CHANNEL DETAILS		BARATARIA BASIN LANDBRIDGE PROJECT BA-27 CONSTRUCTION UNIT 1 LAFOURCHE AND JEFFERSON PARISHES LOUISIANA	U.S. DEPARTMENT OF AGRICULTURE – NATURAL RESOURCES CONSERVATION SERVICE		
CAD FILE NO.					
DRAWING NO.					
SHEET NO. 12 OF 12					


Designed	L. Steve Garner	Date	3/98
Drawn	A. J. Gremillion	Date	3/98
Traced		Date	
Checked	James N. Moore	Date	4/98

Approved by	E.J. GIERING, III	Date	
Title	STATE CONSERVATION ENGINEER		
	ALEXANDRIA, LOUISIANA		
Title			

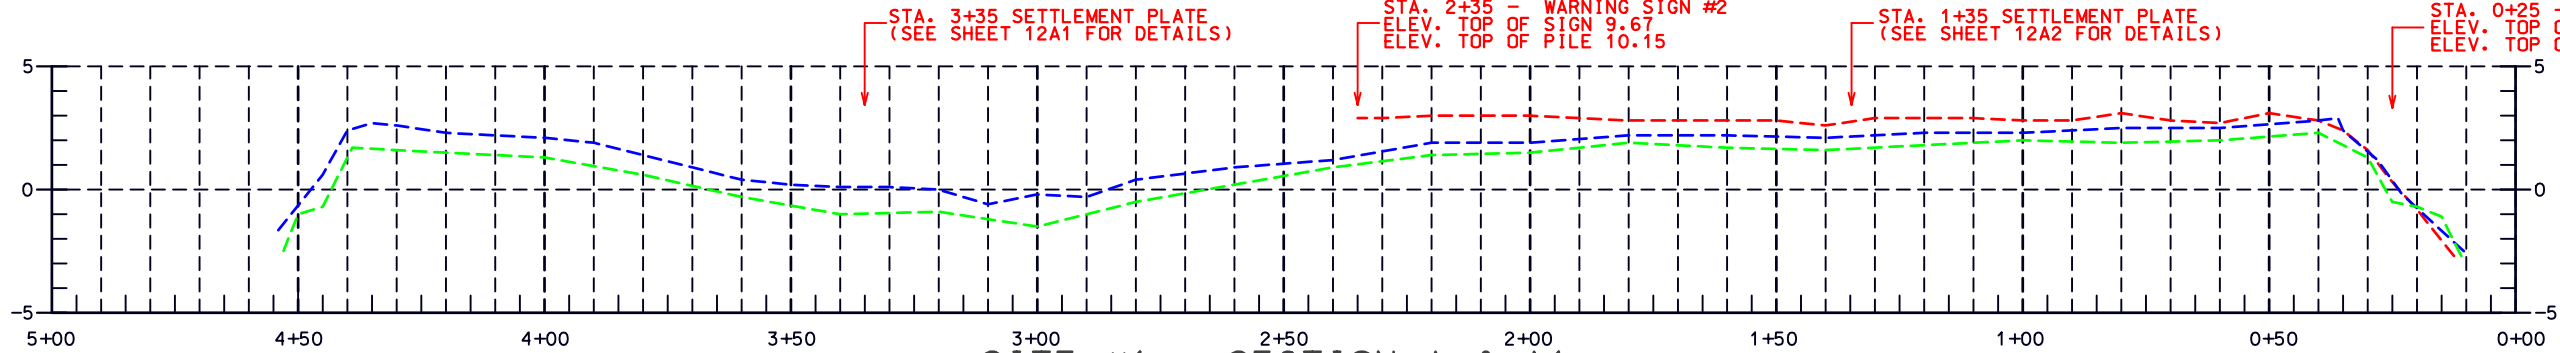


SITE #1 - SECTION A & A1
PROFILE ALONG CENTERLINE

"AS-BUILT"

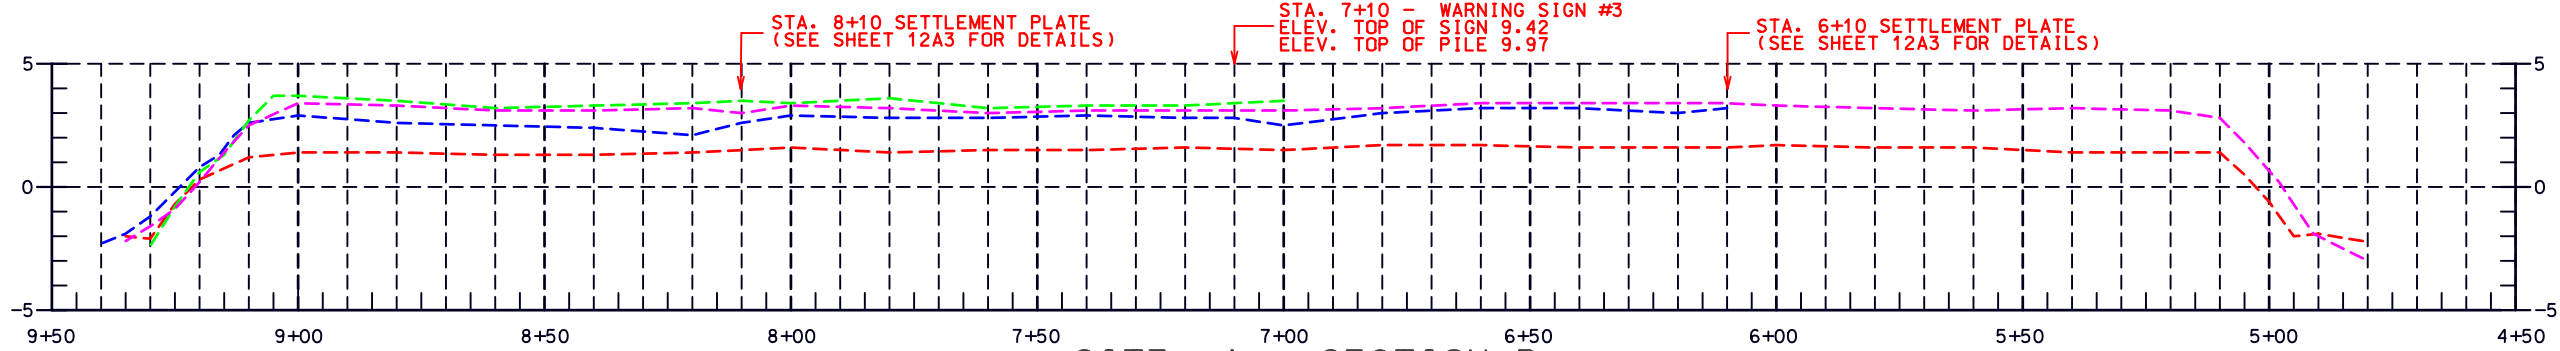


SITE #1 - SECTION B
PROFILE ALONG CENTERLINE

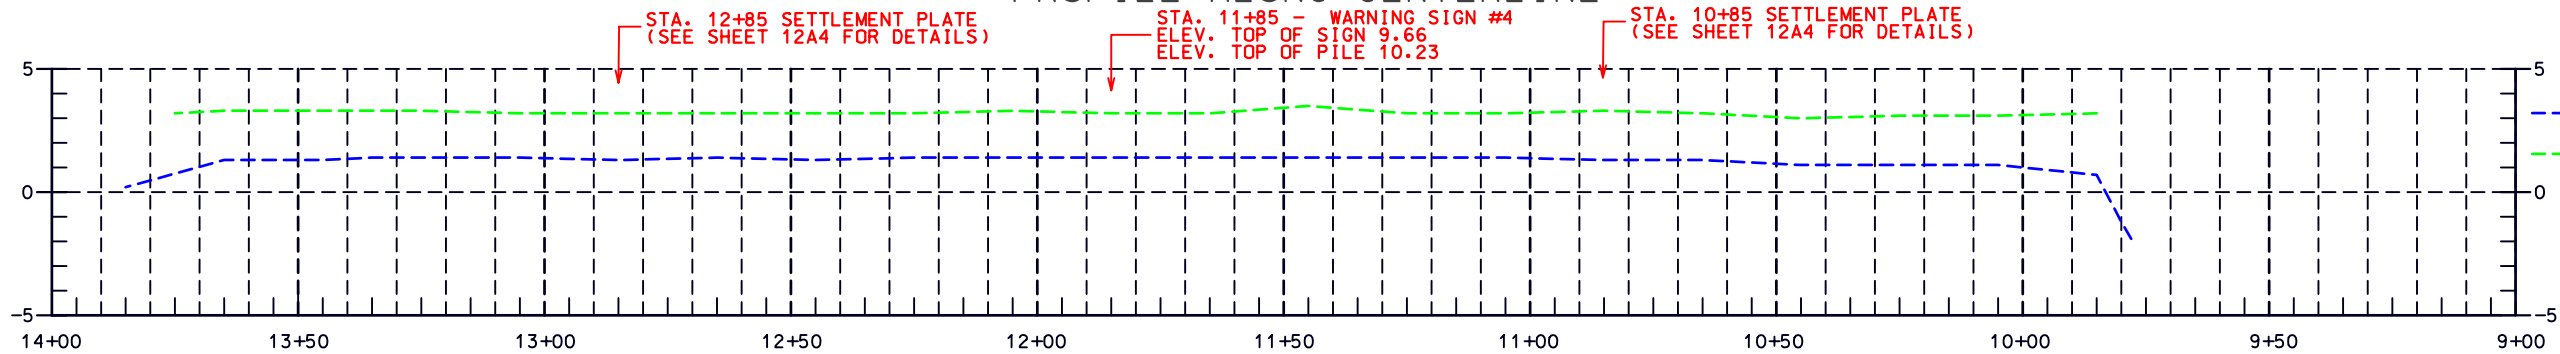

SITE #1 - SECTION C
PROFILE ALONG CENTERLINE

PILE #1	STA. 18+59	ELEV. +3.31
PILE #2	STA. 18+38	ELEV. +3.33
PILE #3	STA. 18+17	ELEV. +3.36
PILE #4	STA. 17+96	ELEV. +3.38
PILE #5	STA. 17+75	ELEV. +3.32
PILE #6	STA. 17+55	ELEV. +3.41
PILE #7	STA. 17+33	ELEV. +3.39
PILE #8	STA. 17+12	ELEV. +3.43
PILE #9	STA. 16+91	ELEV. +3.59
PILE #10	STA. 16+70	ELEV. +3.58
PILE #11	STA. 16+49	ELEV. +3.44
PILE #12	STA. 16+28	ELEV. +3.52
PILE #13	STA. 16+07	ELEV. +3.49
PILE #14	STA. 15+86	ELEV. +3.52
PILE #15	STA. 15+65	ELEV. +3.43
PILE #16	STA. 15+44	ELEV. +3.47
PILE #17	STA. 15+23	ELEV. +3.42
PILE #18	STA. 15+02	ELEV. +3.51
PILE #19	STA. 14+81	ELEV. +3.51
PILE #20	STA. 14+60	ELEV. +3.50

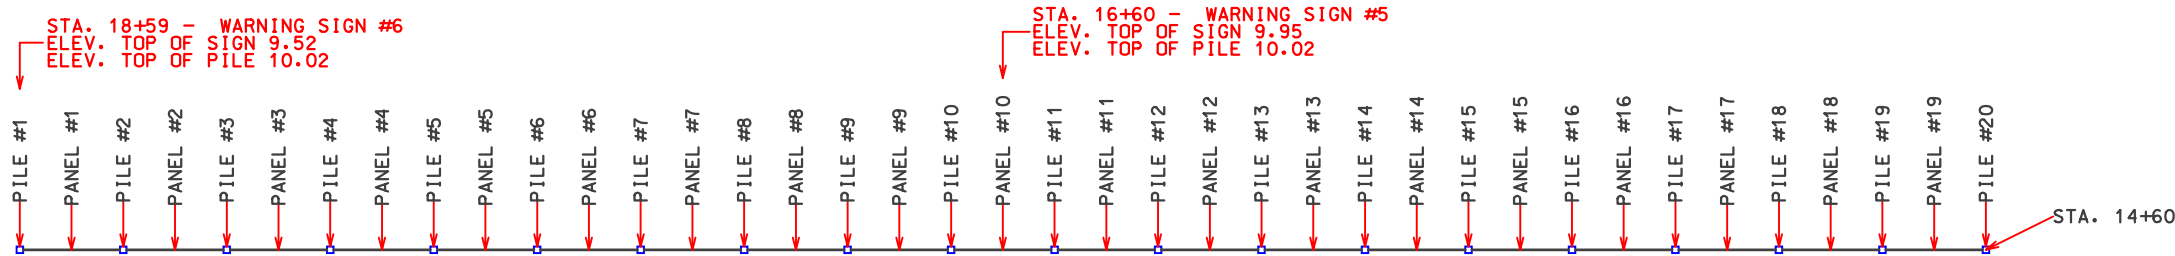


SITE #1 - SECTION D
PLAN VIEW

PANEL #1	STA. 18+48	ELEV. @ PILE #1 = +2.79 ELEV. @ PILE #2 = +2.82 ELEV. @ PILE #2 = +2.84 ELEV. @ PILE #3 = +2.86
PANEL #2	STA. 18+27	ELEV. @ PILE #3 = +2.82 ELEV. @ PILE #4 = +2.85 ELEV. @ PILE #4 = +2.85 ELEV. @ PILE #5 = +2.81
PANEL #3	STA. 18+07	ELEV. @ PILE #5 = +2.83 ELEV. @ PILE #6 = +2.89 ELEV. @ PILE #6 = +2.89 ELEV. @ PILE #7 = +2.88
PANEL #4	STA. 17+85	
PANEL #5	STA. 17+64	
PANEL #6	STA. 17+43	


PANEL #7	STA. 17+22	ELEV. @ PILE #7 = +2.87 ELEV. @ PILE #8 = +2.87 ELEV. @ PILE #8 = +2.92 ELEV. @ PILE #9 = +3.09
PANEL #8	STA. 17+01	ELEV. @ PILE #9 = +3.09 ELEV. @ PILE #10 = +3.09 ELEV. @ PILE #10 = +3.04 ELEV. @ PILE #11 = +2.94
PANEL #9	STA. 16+80	ELEV. @ PILE #11 = +2.96 ELEV. @ PILE #12 = +3.00 ELEV. @ PILE #12 = +3.00 ELEV. @ PILE #13 = +2.97
PANEL #10	STA. 16+59	
PANEL #11	STA. 16+38	
PANEL #12	STA. 16+17	

PANEL #13	STA. 15+96	ELEV. @ PILE #13 = +2.97 ELEV. @ PILE #14 = +2.96 ELEV. @ PILE #14 = +3.00 ELEV. @ PILE #15 = +2.89
PANEL #14	STA. 15+75	ELEV. @ PILE #15 = +2.88 ELEV. @ PILE #16 = +2.96 ELEV. @ PILE #16 = +2.91 ELEV. @ PILE #17 = +2.88
PANEL #15	STA. 15+54	ELEV. @ PILE #17 = +2.90 ELEV. @ PILE #18 = +3.00 ELEV. @ PILE #18 = +3.01 ELEV. @ PILE #19 = +3.00
PANEL #16	STA. 15+33	ELEV. @ PILE #19 = +3.00 ELEV. @ PILE #20 = +3.00
PANEL #17	STA. 15+12	
PANEL #18	STA. 14+91	
PANEL #19	STA. 14+70	


Date	Approved by	Title	Date	Designed	Drawn	Traced	Checked	Title
	E. J. GIERING, III	STATE CONSERVATION ENGINEER	06/00	L. S. GARNER	A. J. GREMILLION	B. STICKER	01/02	01/02
SITE NO. 1 - AS-BUILT BARATARIA BASIN LANDBRIDGE PROJECT BA-27 - CONSTRUCTION UNIT NO. 1 JEFFERSON AND LAFOURCHE PARISHES LOUISIANA								
U.S. DEPARTMENT OF AGRICULTURE - NATURAL RESOURCES CONSERVATION SERVICE								
CAD FILENAME LA302012A1								
PROJECT NO. LA302								
SHEET NO. 12A1 OF 12								

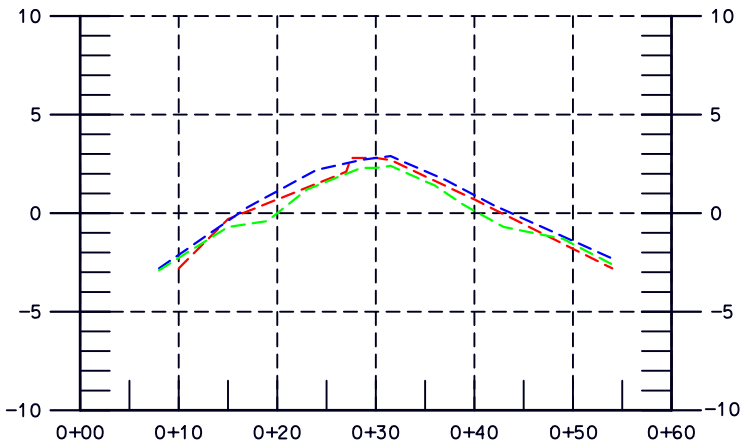


SITE #1 - SECTION A1
STA, 0+40

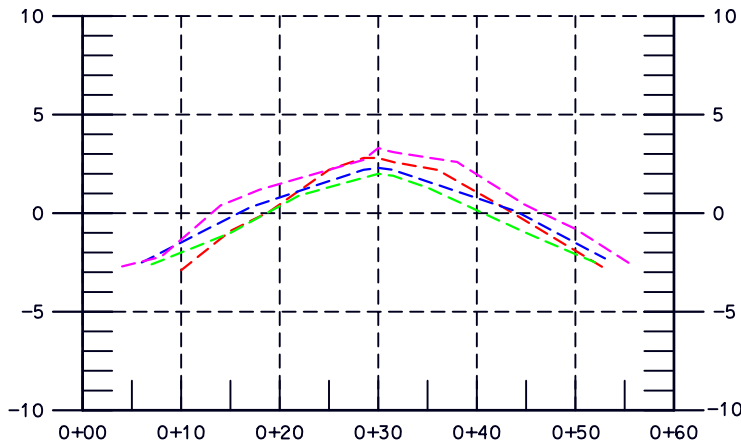


SITE #1 - SECTION A1
STA, 1+00

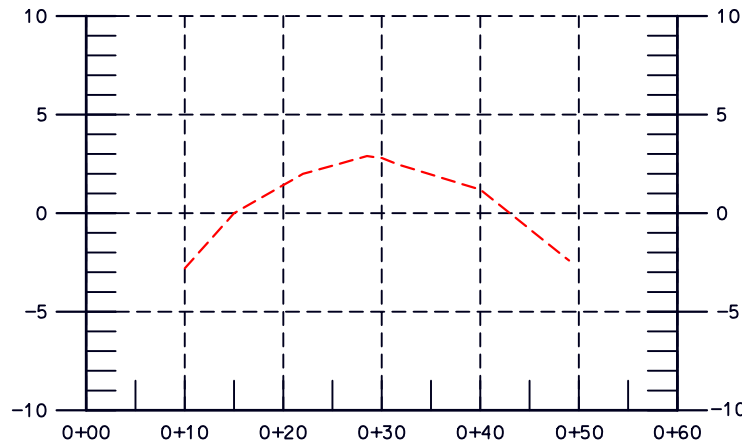


SITE #1 - SECTION A1
STA, 1+50

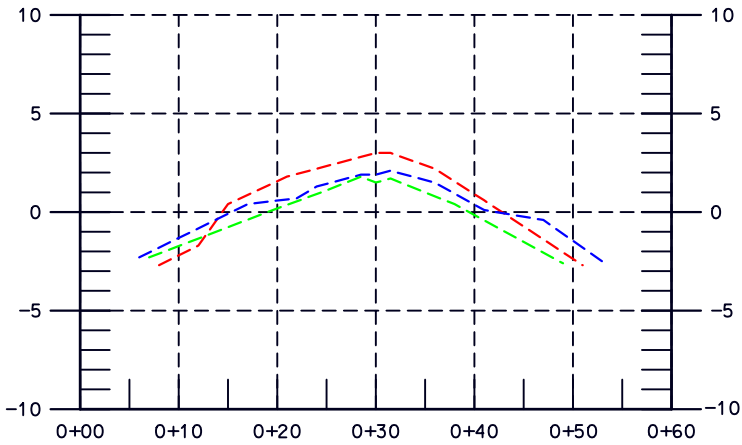


SITE #1 - SECTION A1
STA, 2+00

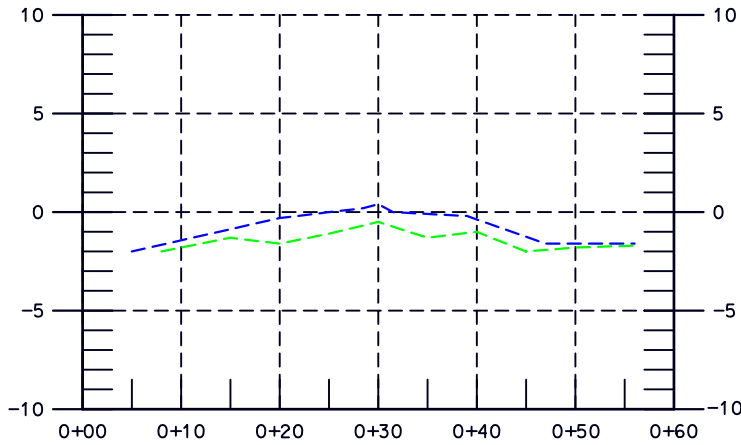


SITE #1 - SECTION A
STA, 2+80

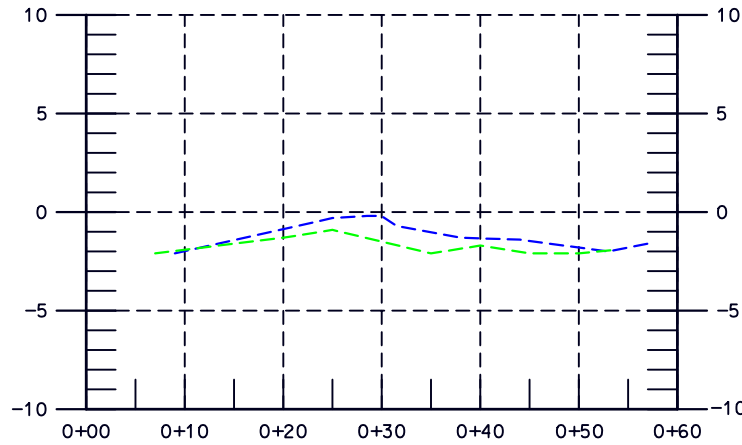

SITE #1 - SECTION A
STA, 3+00

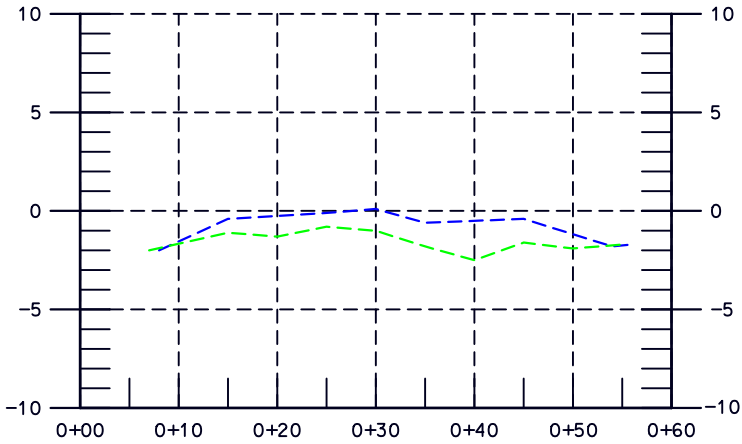

SITE #1 - SECTION A
STA, 3+40

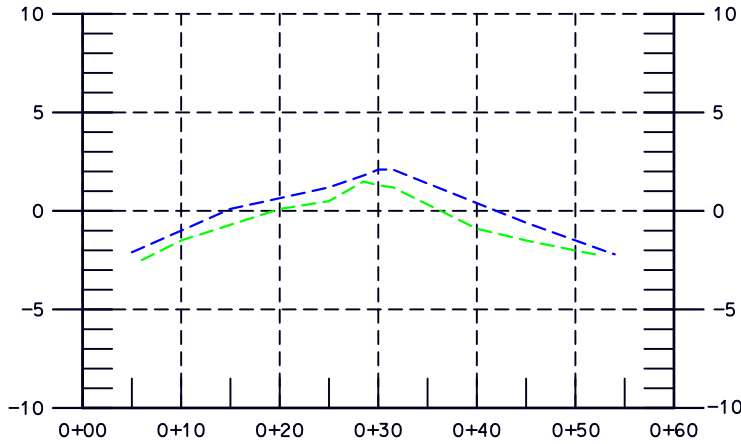

SITE #1 - SECTION A
STA, 4+00

- "AS-BUILT"**
- CROSS SECTIONS TAKEN 1/18/2001
 - CROSS SECTIONS TAKEN 1/24/2001 (AFTER FAILURE)
 - CROSS SECTIONS TAKEN 2/14/2001 (AFTER FAILURE SETTLEMENT)
 - CROSS SECTIONS TAKEN 2/15/2001 (CONSTRUCTION CHECK)

ELEV. ON TOP OF PIPE AT STA. 1+35:
+9.80 DATE: 1/11/2001 (PLATE PLACED ON GEOTEXTILE)
+8.91 DATE: 1/18/2001
+7.36 DATE: 1/24/2001
+6.90 DATE: 2/14/2001

ELEV. ON TOP OF PIPE AT STA. 3+35:
+9.20 DATE: 1/15/2001 (PLATE PLACED ON GEOTEXTILE)
+1.90 DATE: 1/24/2001 ???????
+1.16 DATE: 2/14/2001 ???????

Date	Approved by	E. J. GERING, III	Title	STATE CONSERVATION ENGINEER	Location	ALEXANDRIA, LOUISIANA
Date	Designed	L.S. GARNER	Drawn	A.J. GREMILLION	Traced	B. STICKER
Date	06/00		01/02		01/02	

SITE NO. 1 - AS-BUILT
BARATARIA BASIN LANDBRIDGE PROJECT
BA-27 - CONSTRUCTION UNIT NO. 1
JEFFERSON AND LAFOURCHE PARISHES
LOUISIANA








U.S. DEPARTMENT OF AGRICULTURE - NATURAL RESOURCES CONSERVATION SERVICE

NO.	DATE	APPR.	TITLE

CAD FILENAME
LA302012A2


PROJECT NO.
LA302

SHEET NO 12A2 OF 12

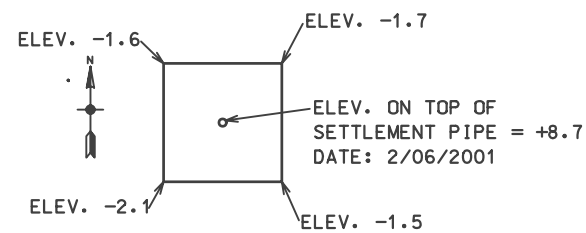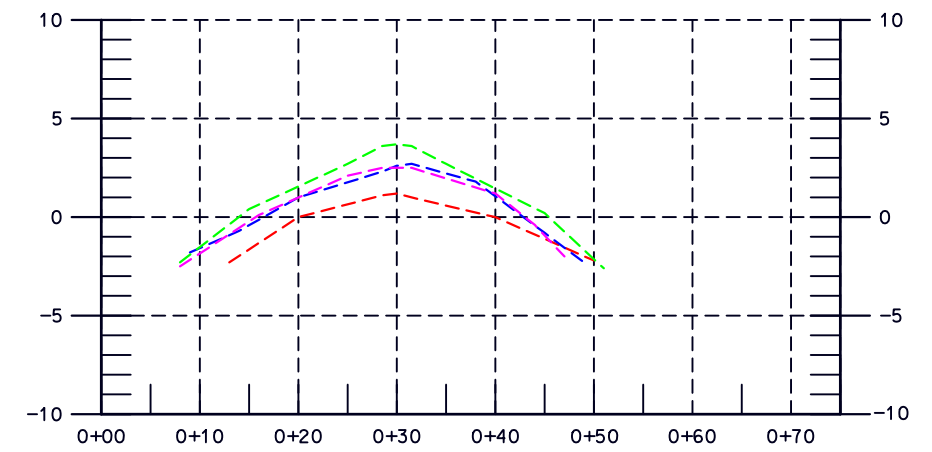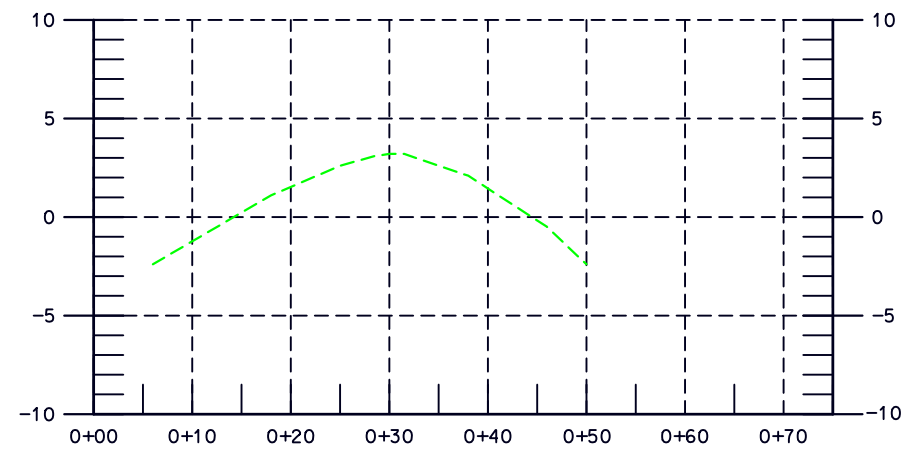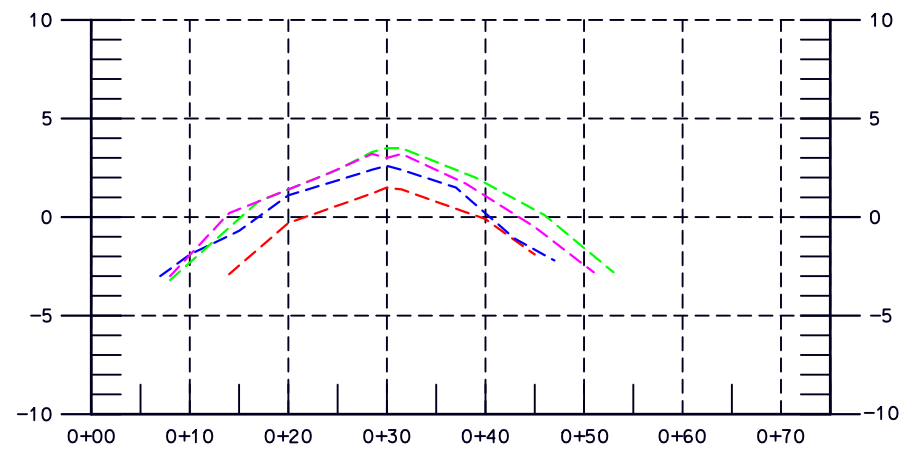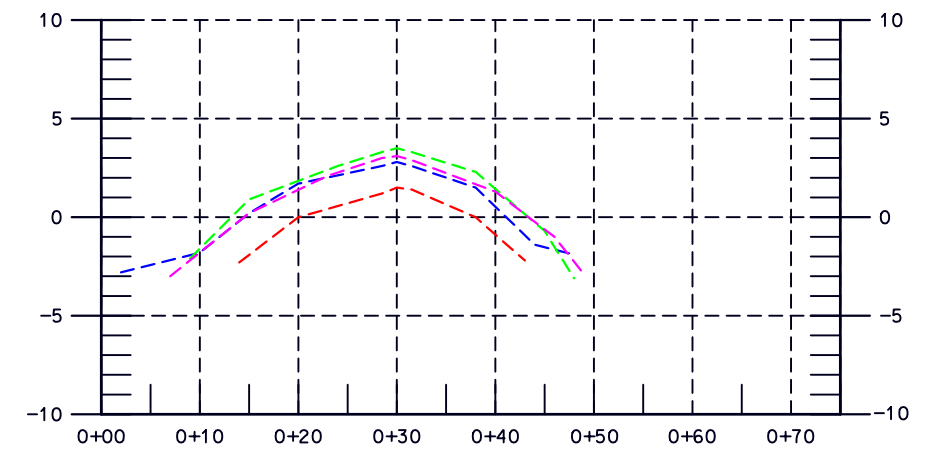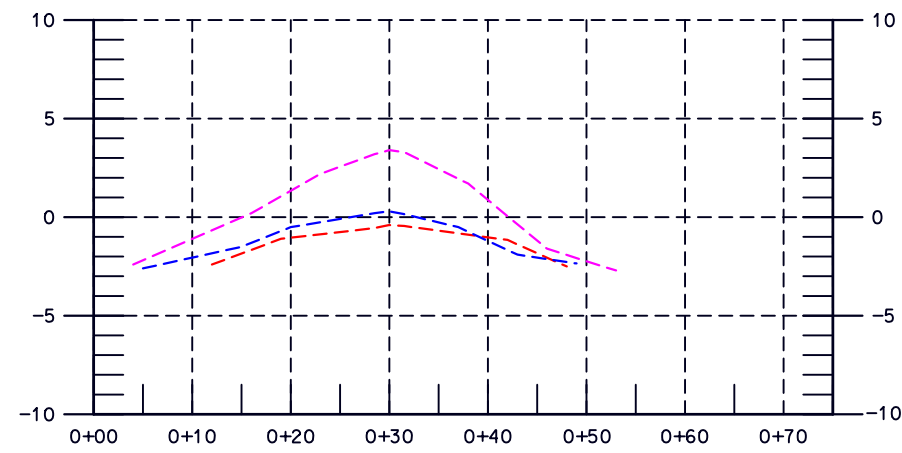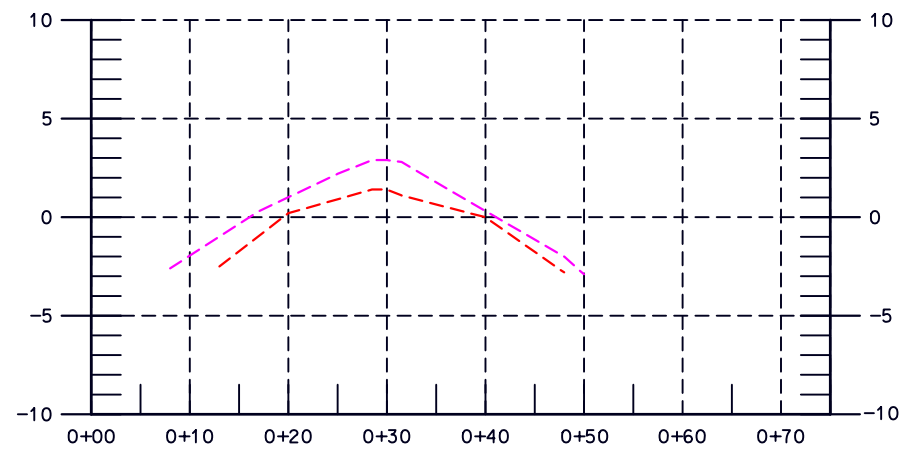

NOTE: ELEVATIONS ARE PRIOR TO PLACING LIGHTWEIGHT AGGREGATE.

ELEV. ON TOP OF PIPE AT STA. 6+10:
+1.60 DATE: 2/08/2001
+7.60 DATE: 2/14/2001
+7.48 DATE: 2/21/2001
+6.68 DATE: 3/29/2001
+6.64 DATE: 4/27/2001

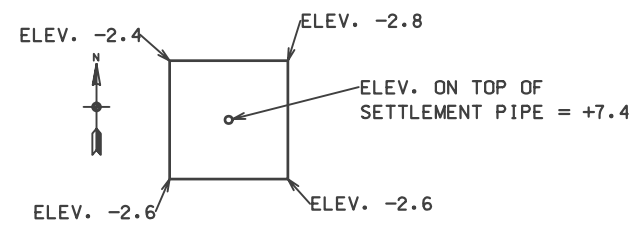

NOTE: ELEVATIONS ARE PRIOR TO PLACING LIGHTWEIGHT AGGREGATE.








ELEV. ON TOP OF PIPE AT STA. 8+10:
+1.50 DATE: 2/08/2001
+6.18 DATE: 2/14/2001
+5.57 DATE: 2/21/2001
+4.85 DATE: 3/29/2001
+4.78 DATE: 4/27/2001

"AS-BUILT"

- - - - - CROSS SECTIONS TAKEN 2/08/2001 (LIGHT WEIGHT AGGREGATE PLACEMENT)
 - - - - - CROSS SECTIONS TAKEN 2/14/2001 (FIRST LIFT OF 400# ROCK)
 - - - - - CROSS SECTIONS TAKEN 2/16/2001 (SECOND LIFT OF 400# ROCK)
 - - - - - CROSS SECTIONS TAKEN 2/21/2001 (FINAL CONSTRUCTION CHECK)

[illegible]

CAD FILENAME
LA302012A3
PROJECT NO.
LA302
SHEET NO 12A3 OF 12

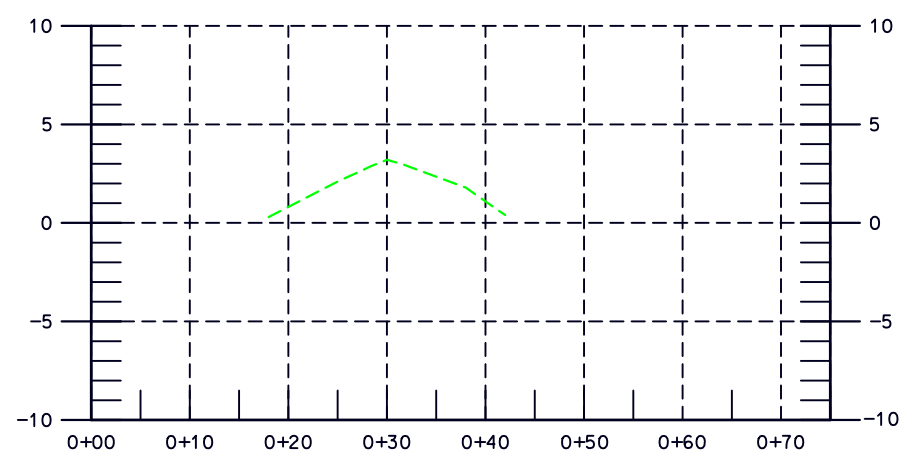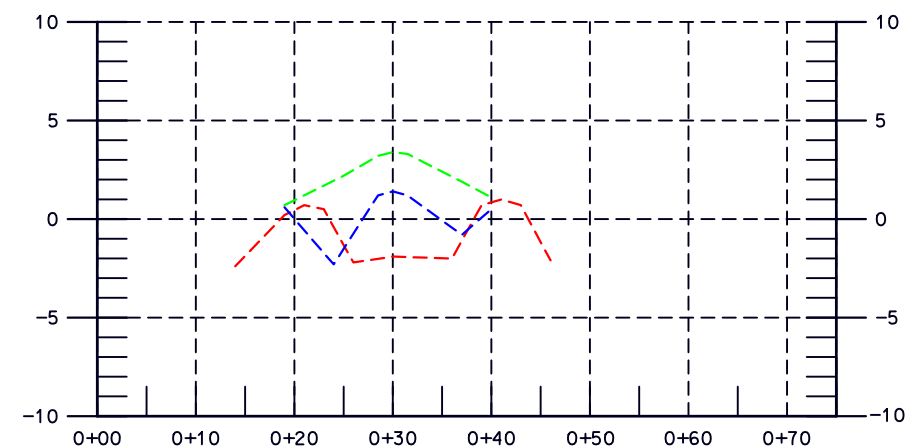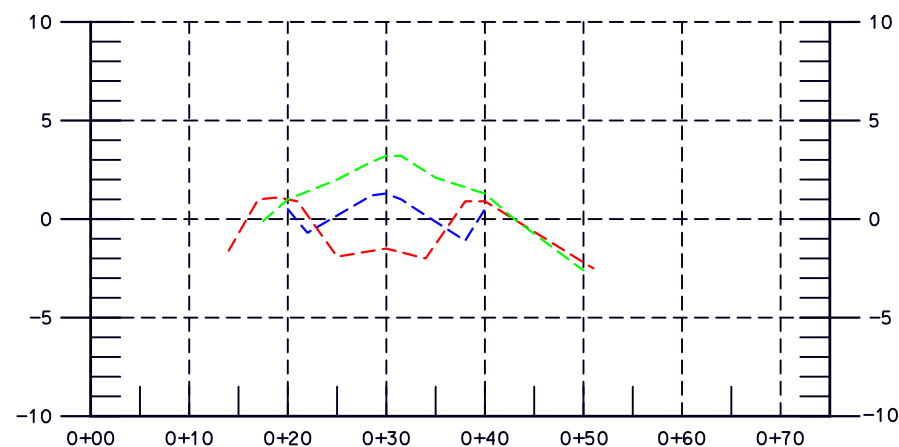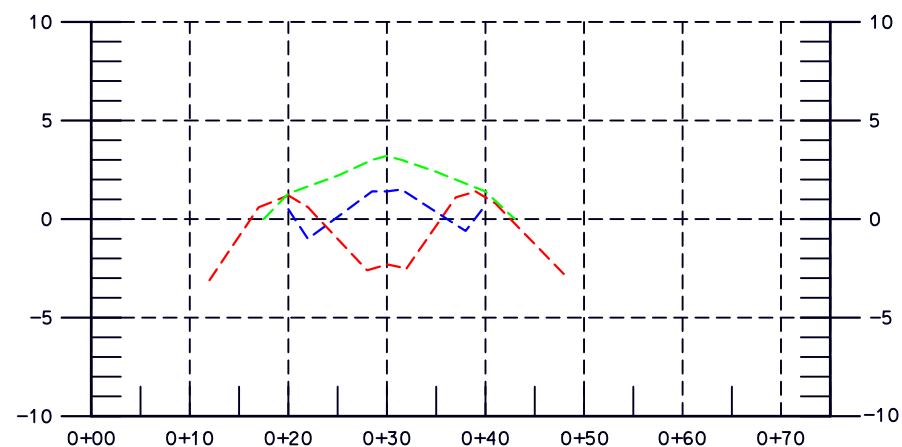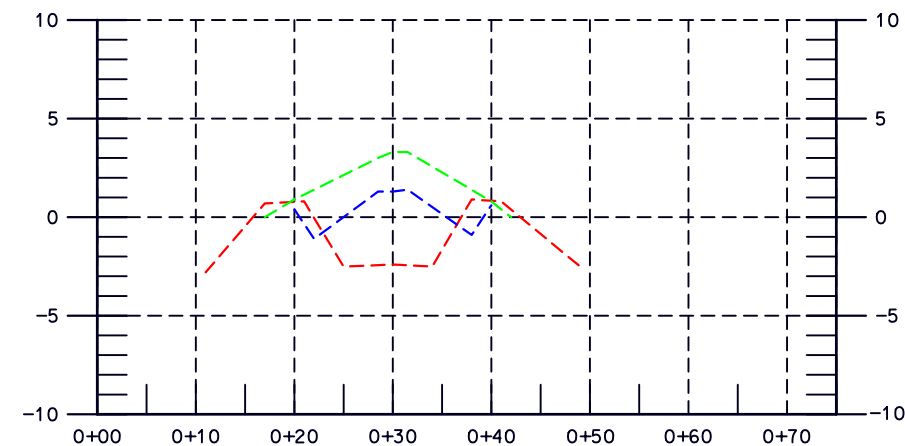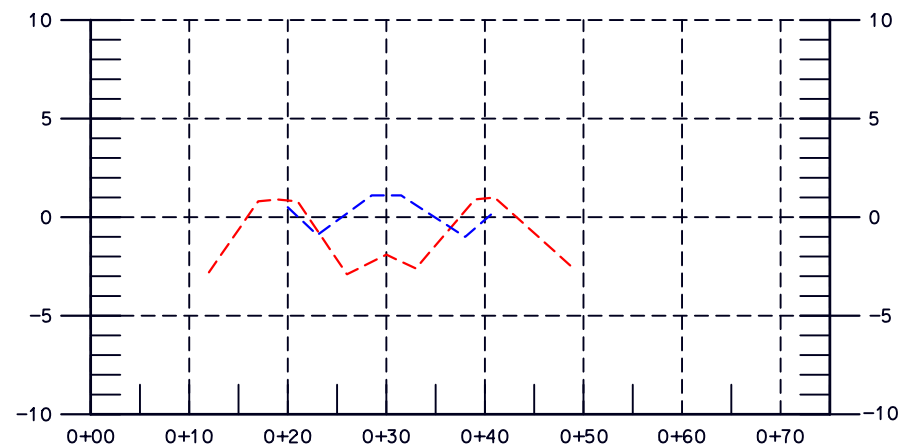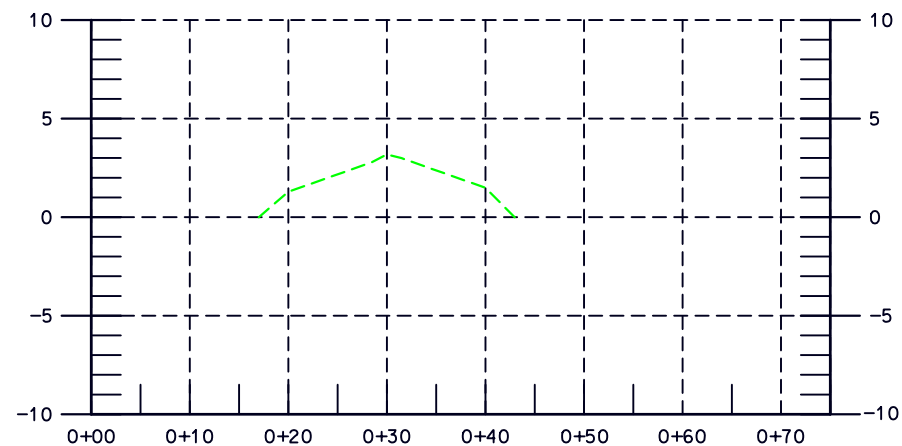

----- CROSS SECTIONS TAKEN 2/01/2001 (ROCK SHOULDERS FORMING FURROW)

----- CROSS SECTIONS TAKEN 3/06/2001 (CONSTRUCTION CHECK ON LIGHT WEIGHT AGGREGATE)

----- CROSS SECTIONS TAKEN 3/07/2001-3/09/2001 (FINAL CHECK ON 400# ROCK FORMING CAP)

NOTE: ELEVATIONS ARE PRIOR TO PLACING LIGHTWEIGHT AGGREGATE.

NOTE: ELEVATIONS ARE PRIOR TO PLACING LIGHTWEIGHT AGGREGATE.

"AS-BUILT"

U.S. DEPARTMENT OF AGRICULTURE - NATURAL RESOURCES CONSERVATION SERVICE

[illegible]

	Date
Designed	L. S. GARNER 06/00
Drawn	A. J. GREMILLION 01/02
Traced	
Checked	B. STICKER 01/02


Date _____

Approved by E. J. GIERING, III

Title STATE CONSERVATION ENGINEER

ALEXANDRIA, LOUISIANA


Title _____

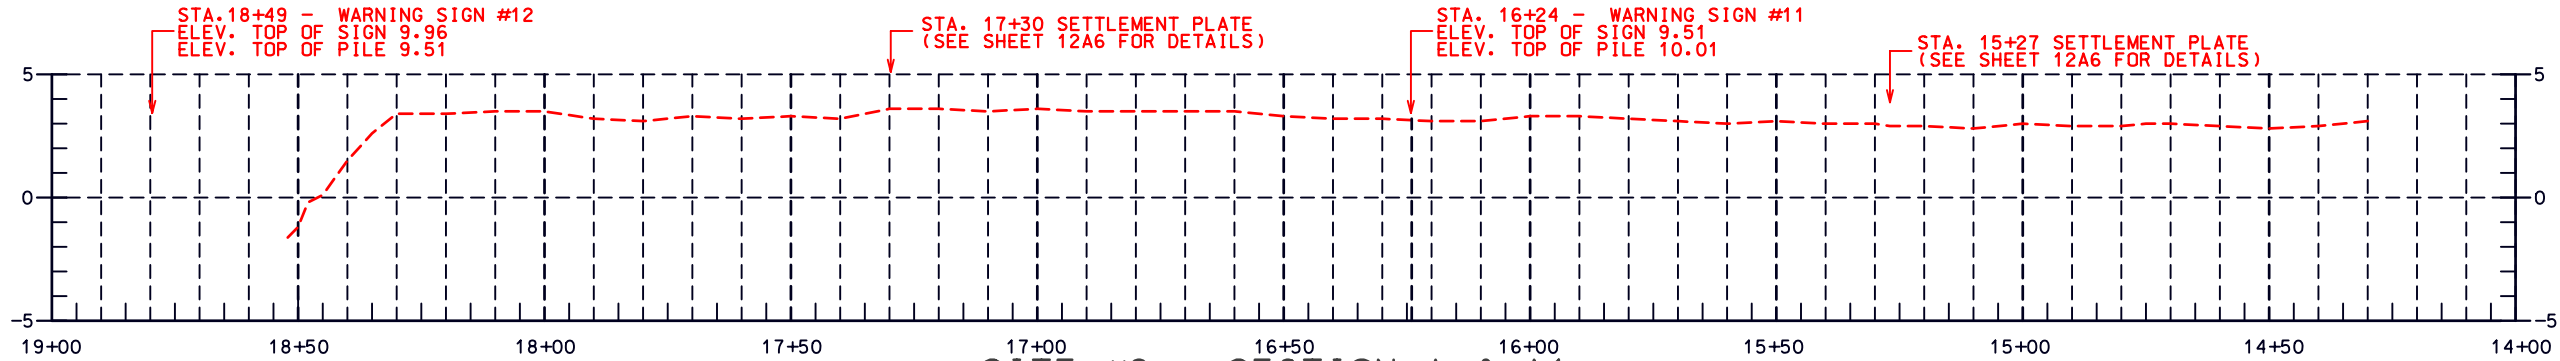

SITE #2 - SECTION A & A1
PROFILE ALONG CENTERLINE


--- PROFILE TAKEN 3/02/2001
(FINAL CHECK)

"AS-BUILT"

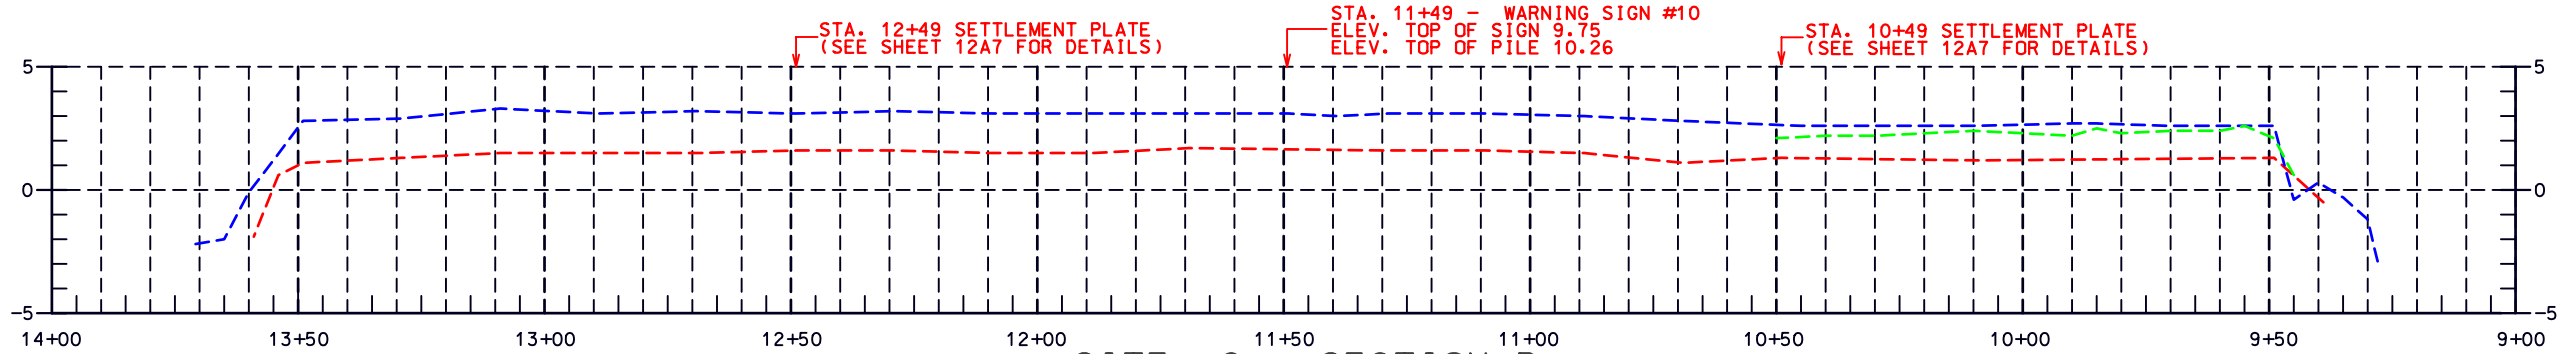

SITE #2 - SECTION B
PROFILE ALONG CENTERLINE


--- PROFILE TAKEN 3/16/2001
(LIGHTWEIGHT AGGREGATE)
--- PROFILE TAKEN 3/22/2001
(FINAL CHECK 400# RIPRAP)
--- PROFILE TAKEN 3/30/2001
(FINAL CHECK 400# RIPRAP)

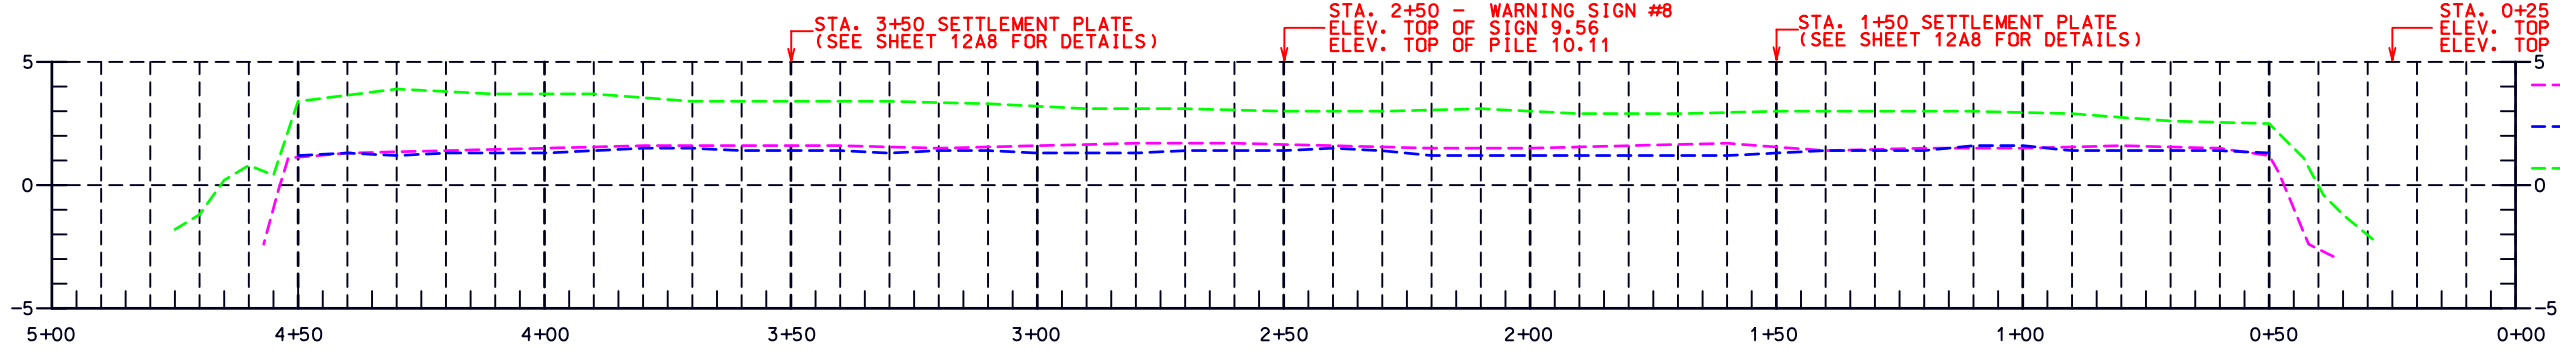

SITE #2 - SECTION C
PROFILE ALONG CENTERLINE

--- PROFILE TAKEN 3/02/2001
(RIPRAP FURROW)
--- PROFILE TAKEN 3/09/2001
(LIGHTWEIGHT AGGREGATE)
--- PROFILE TAKEN 3/15/2001
(FINAL CHECK)

PILE #21	STA. 5+00	ELEV. +3.32
PILE #22	STA. 5+21	ELEV. +3.38
PILE #23	STA. 5+42	ELEV. +3.39
PILE #24	STA. 5+63	ELEV. +3.36
PILE #25	STA. 5+84	ELEV. +3.42
PILE #26	STA. 6+05	ELEV. +3.41
PILE #27	STA. 6+26	ELEV. +3.40
PILE #28	STA. 6+47	ELEV. +3.40
PILE #29	STA. 6+68	ELEV. +3.41
PILE #30	STA. 6+89	ELEV. +3.47
PILE #31	STA. 7+10	ELEV. +3.45
PILE #32	STA. 7+31	ELEV. +3.44
PILE #33	STA. 7+52	ELEV. +3.37
PILE #34	STA. 7+73	ELEV. +3.38
PILE #35	STA. 7+94	ELEV. +3.36
PILE #36	STA. 8+15	ELEV. +3.37
PILE #37	STA. 8+36	ELEV. +3.37
PILE #38	STA. 8+57	ELEV. +3.36
PILE #39	STA. 8+78	ELEV. +3.37
PILE #40	STA. 8+99	ELEV. +3.36

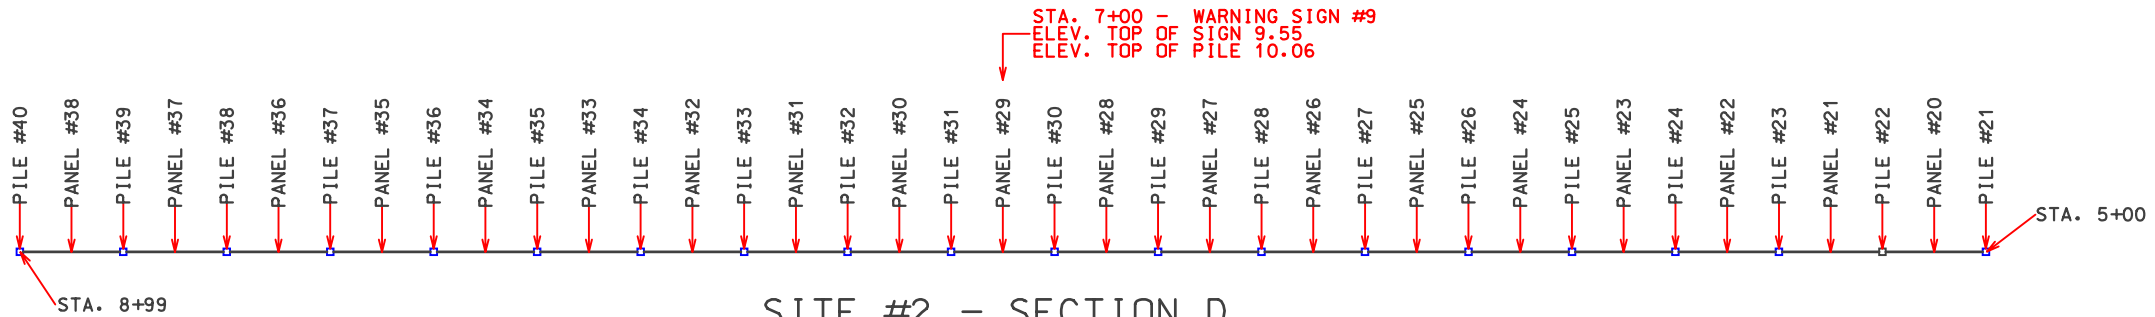

SITE #2 - SECTION D
PLAN VIEW

PANEL #20	STA. 5+11	ELEV. @ PILE #1 = +2.78 ELEV. @ PILE #2 = +2.84 ELEV. @ PILE #2 = +2.87 ELEV. @ PILE #3 = +2.88
PANEL #21	STA. 5+32	ELEV. @ PILE #3 = +2.81 ELEV. @ PILE #4 = +2.87 ELEV. @ PILE #4 = +2.86 ELEV. @ PILE #5 = +2.87
PANEL #22	STA. 5+53	ELEV. @ PILE #5 = +2.91 ELEV. @ PILE #6 = +2.87 ELEV. @ PILE #6 = +2.94 ELEV. @ PILE #7 = +2.91
PANEL #23	STA. 5+74	
PANEL #24	STA. 5+95	
PANEL #25	STA. 6+16	

PANEL #26	STA. 6+37	ELEV. @ PILE #7 = +2.81 ELEV. @ PILE #8 = +2.91 ELEV. @ PILE #8 = +2.86 ELEV. @ PILE #9 = +2.86
PANEL #27	STA. 6+58	ELEV. @ PILE #9 = +2.92 ELEV. @ PILE #10 = +3.00 ELEV. @ PILE #10 = +2.95 ELEV. @ PILE #11 = +2.94
PANEL #28	STA. 6+79	ELEV. @ PILE #11 = +2.96 ELEV. @ PILE #12 = +2.92 ELEV. @ PILE #12 = +2.96 ELEV. @ PILE #13 = +2.89
PANEL #29	STA. 7+00	
PANEL #30	STA. 7+21	
PANEL #31	STA. 7+42	

PANEL #32	STA. 7+63	ELEV. @ PILE #13 = +2.85 ELEV. @ PILE #14 = +2.87 ELEV. @ PILE #14 = +2.85 ELEV. @ PILE #15 = +2.83
PANEL #33	STA. 7+84	ELEV. @ PILE #15 = +2.84 ELEV. @ PILE #16 = +2.85 ELEV. @ PILE #16 = +2.89 ELEV. @ PILE #17 = +2.89
PANEL #34	STA. 8+05	ELEV. @ PILE #17 = +2.86 ELEV. @ PILE #18 = +2.87 ELEV. @ PILE #18 = +2.86 ELEV. @ PILE #19 = +2.81
PANEL #35	STA. 8+26	ELEV. @ PILE #19 = +2.86 ELEV. @ PILE #20 = +2.86
PANEL #36	STA. 8+47	
PANEL #37	STA. 8+68	
PANEL #38	STA. 8+89	

Date	Approved by	Title
	E. J. GIERING, III	STATE CONSERVATION ENGINEER
		ALEXANDRIA, LOUISIANA






Date	Designed	Drawn	Traced	Checked
06/00	L. S. GARNER	A. J. GREMILLION	B. STICKER	
		01/02	01/02	

SITE NO. 2 - AS-BUILT
BARATARIA BASIN LANDBRIDGE PROJECT
BA-27 - CONSTRUCTION UNIT NO. 1
JEFFERSON AND LAFOURCHE PARISHES
LOUISIANA

REVISIONS	NO.	DATE	APPR.	TITLE


CAD FILENAME	LA302012A5
PROJECT NO.	LA302
SHEET NO	12A5 OF 12

U.S. DEPARTMENT OF AGRICULTURE - NATURAL RESOURCES CONSERVATION SERVICE

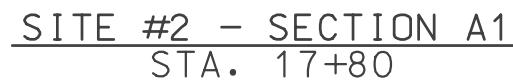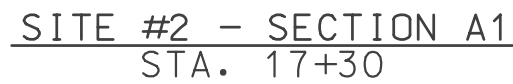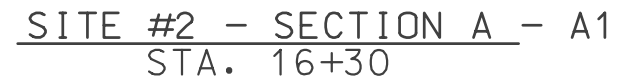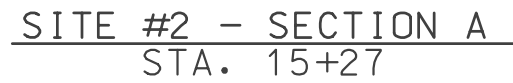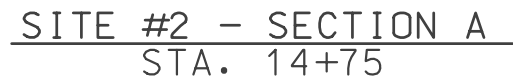


"AS-BUILT"

----- CROSS SECTIONS TAKEN 3/02/2001 (CONSTRUCTION CHECK)

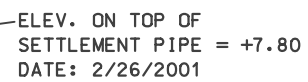

SITE 2 - SECTION A (SETTLEMENT PLATE)
STATION 15+27

ELEV. ON TOP OF PIPE AT STA. 15+27:
+6.16 DATE: 3/02/2001
+5.78 DATE: 3/05/2001
+5.60 DATE: 3/09/2001

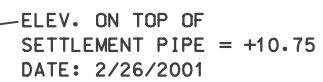

SITE 2 - SECTION A1 (SETTLEMENT PLATE)
STATION 17+30

ELEV. ON TOP OF PIPE AT STA. 17+30:
+9.96 DATE: 3/02/2001
+9.52 DATE: 3/05/2001
+9.30 DATE: 3/09/2001

[illegible]

CAD FILENAME
LA302012A6

PROJECT NO.
LA302

SHEET NO 12A6 OF 12









BARATARIA BASIN LAMPBRIDGE PROJECT
BA-27 - CONSTRUCTION UNIT NO. 1
JEFFERSON AND LAFOURCHE PARISHES
LOUISIANA

U.S. DEPARTMENT OF AGRICULTURE - NATURAL RESOURCES CONSERVATION SERVICE

Designed L.S. GARNER 06/00
 Drawn A.J. GREWILLION 01/02
 Traced _____
 Checked B. STICKER 01/02

Approved by E. J. GERING, III
STATE CONSERVATION ENGINEER
ALEXANDRIA, LOUISIANA
 Title _____

 Title _____

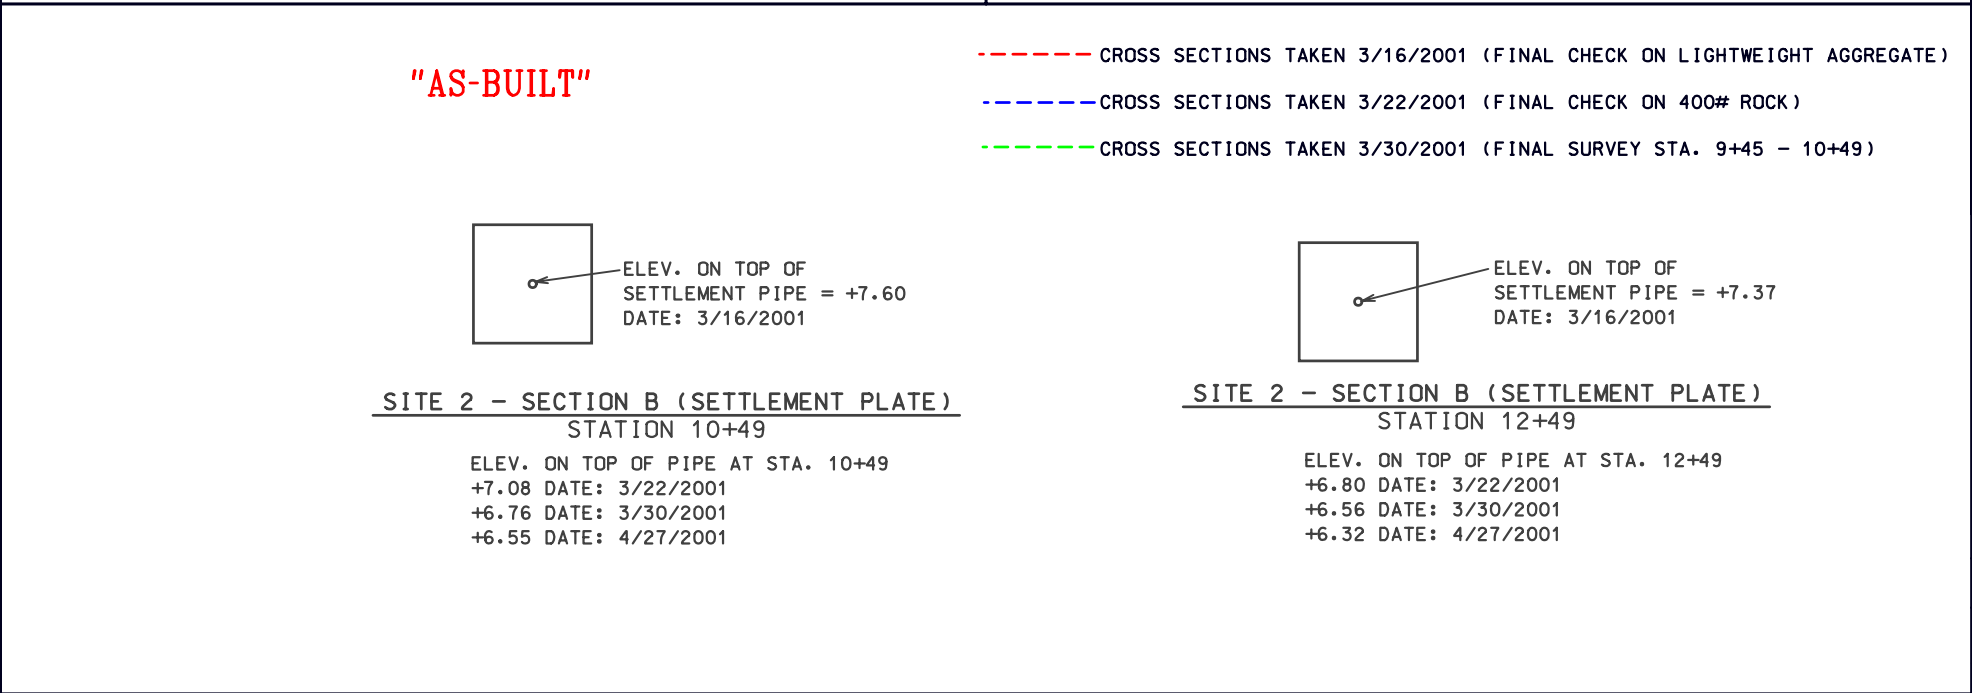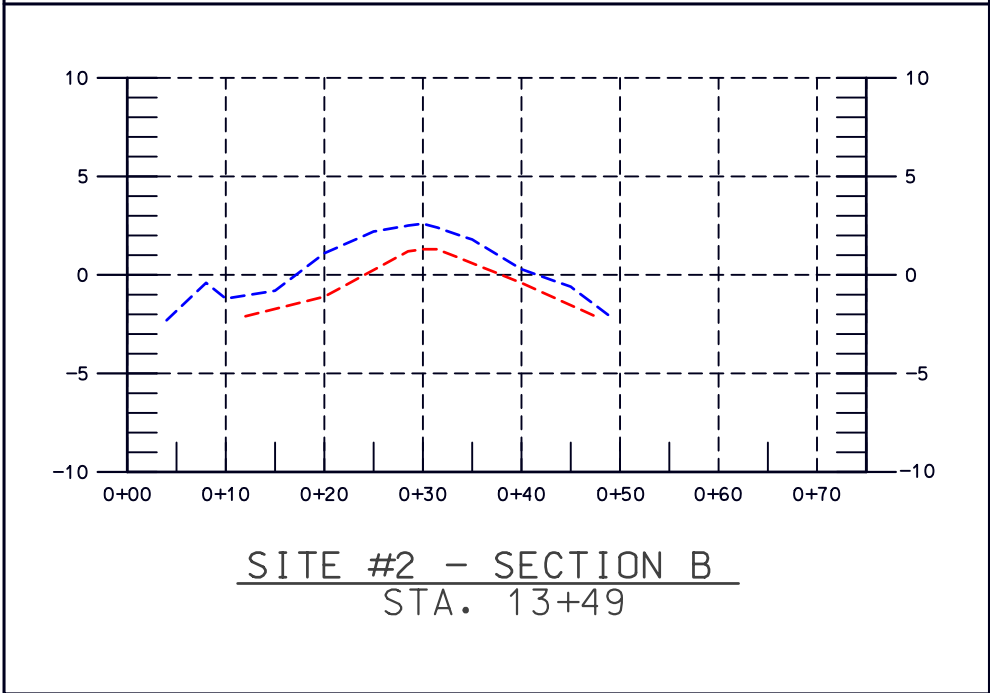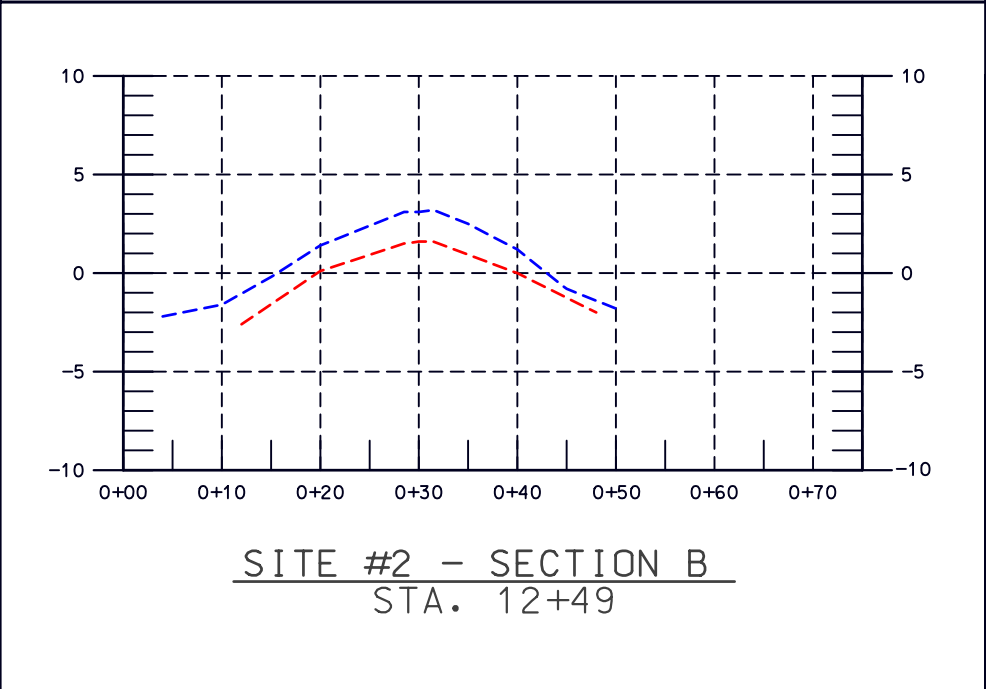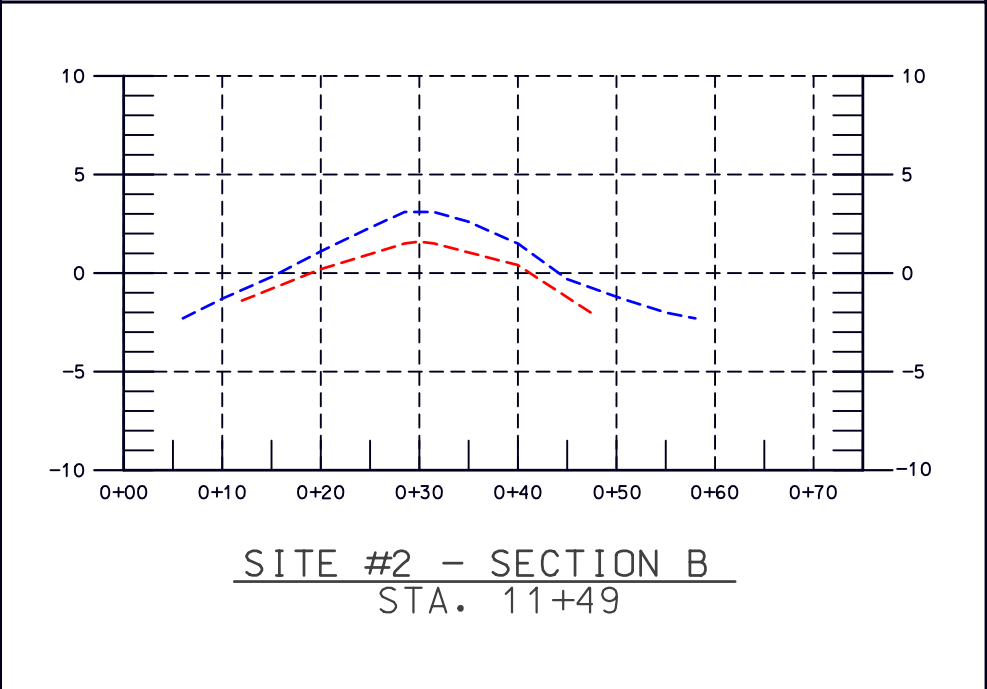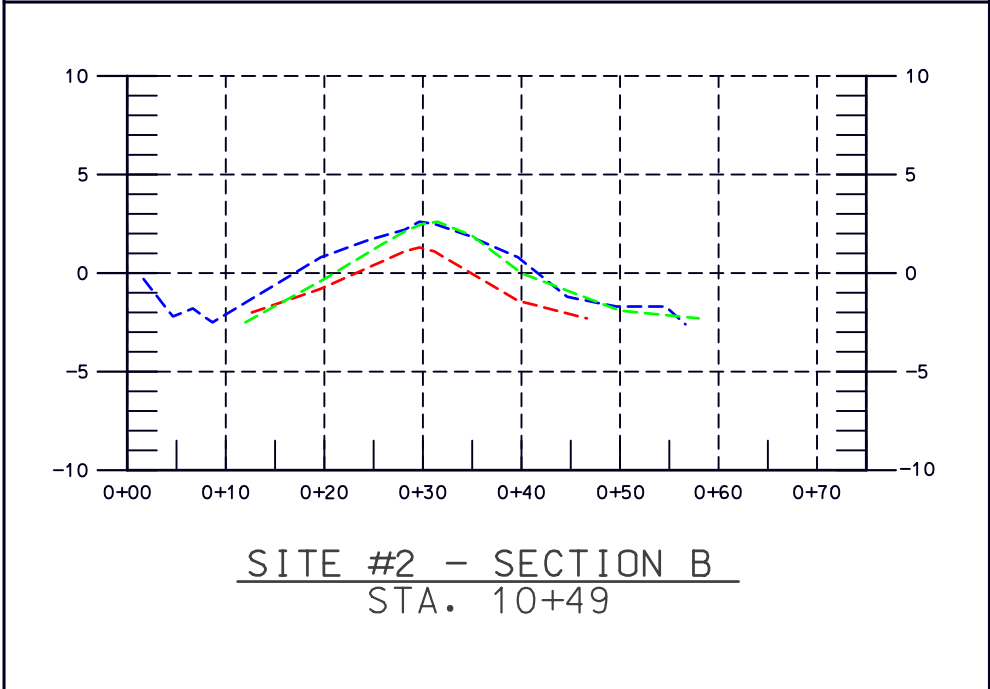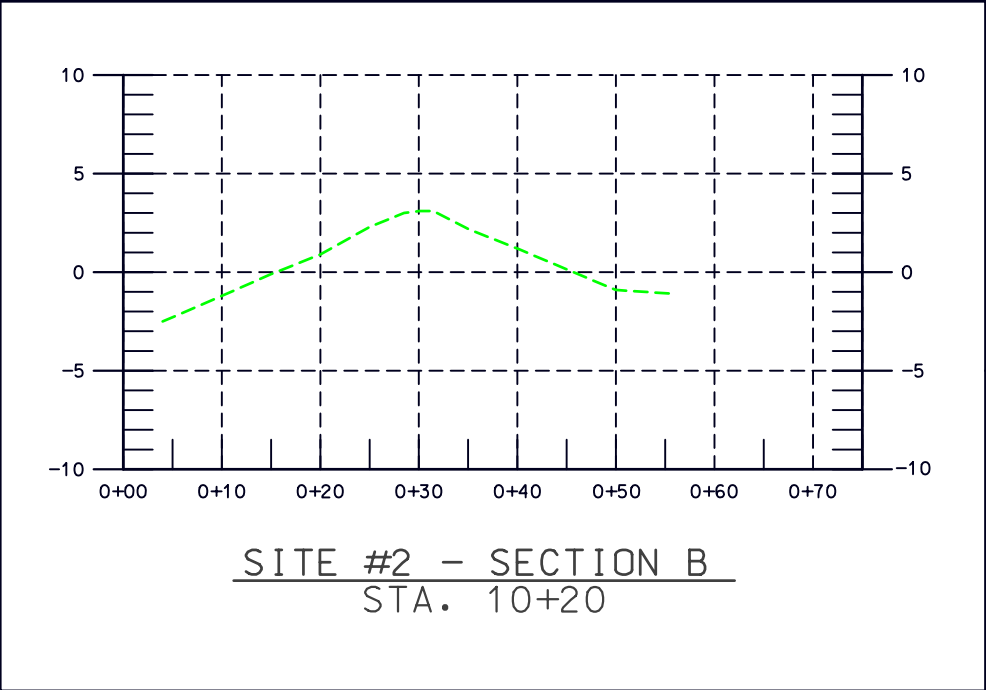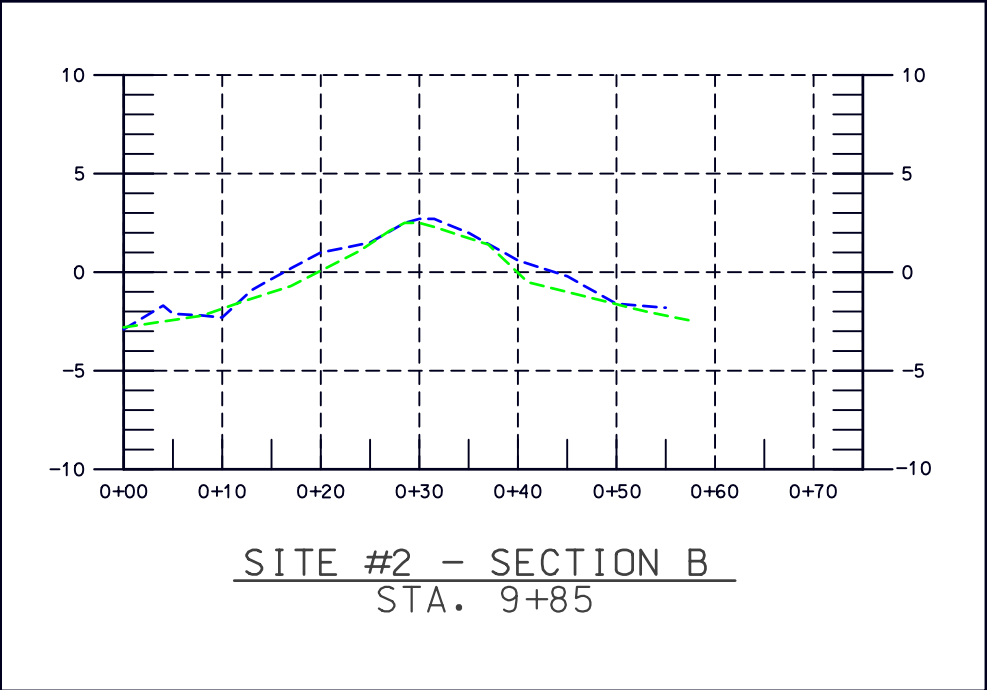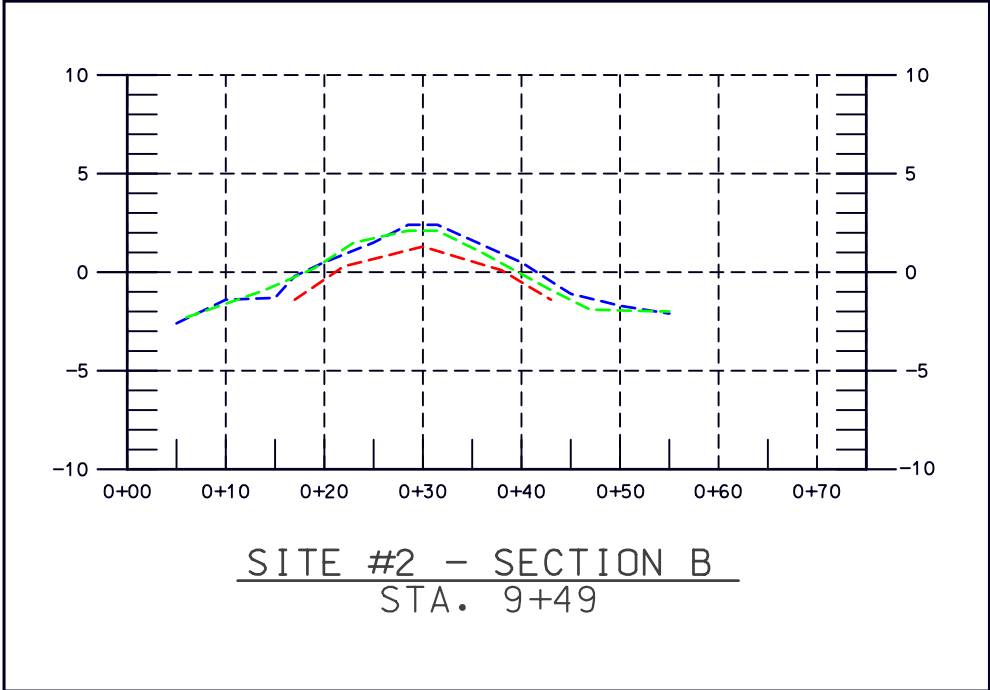

Date				Date			
Approved by				Approved by			
E. J. GIERING, III				L. S. GARNER			
Title				Title			
STATE CONSERVATION ENGINEER				A. J. GREMILLION			
ALEXANDRIA, LOUISIANA				Traced			
Title				Checked			
01/02				B. STICKER			
01/02				01/02			

SITE NO. 2 - AS-BUILT

BARATARIA BASIN LANDBRIDGE PROJECT

BA-27 - CONSTRUCTION UNIT NO. 1

JEFFERSON AND LAFOURCHE PARISHES

LOUISIANA









NO.	DATE	APPR.	TITLE

CAD FILENAME
LA302012A7

PROJECT NO.
LA312

SHEET NO 12A7 OF 12

U.S. DEPARTMENT OF AGRICULTURE - NATURAL RESOURCES CONSERVATION SERVICE

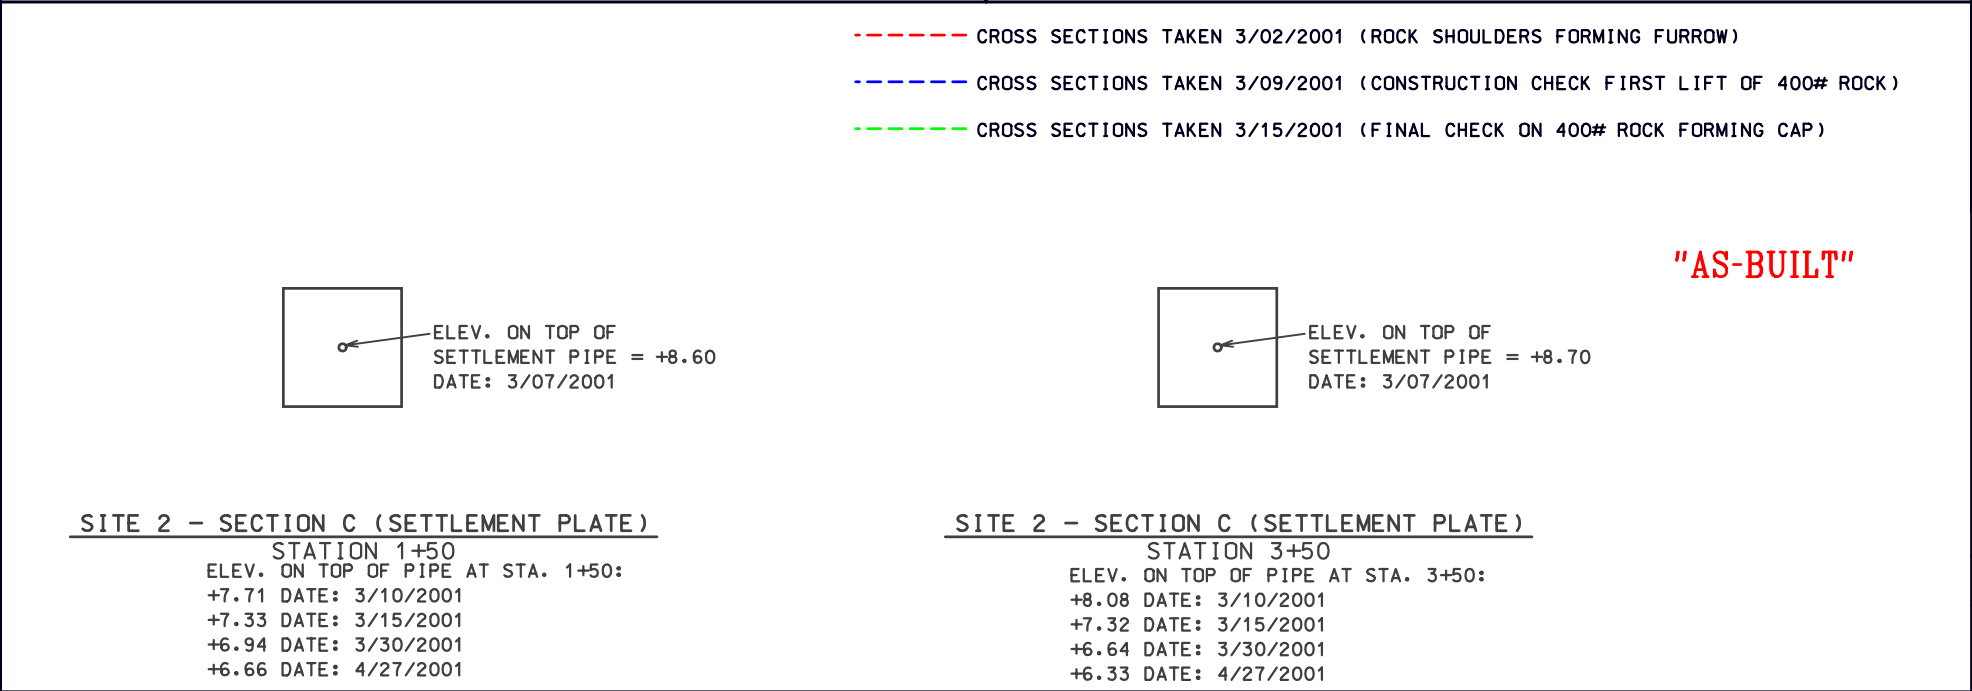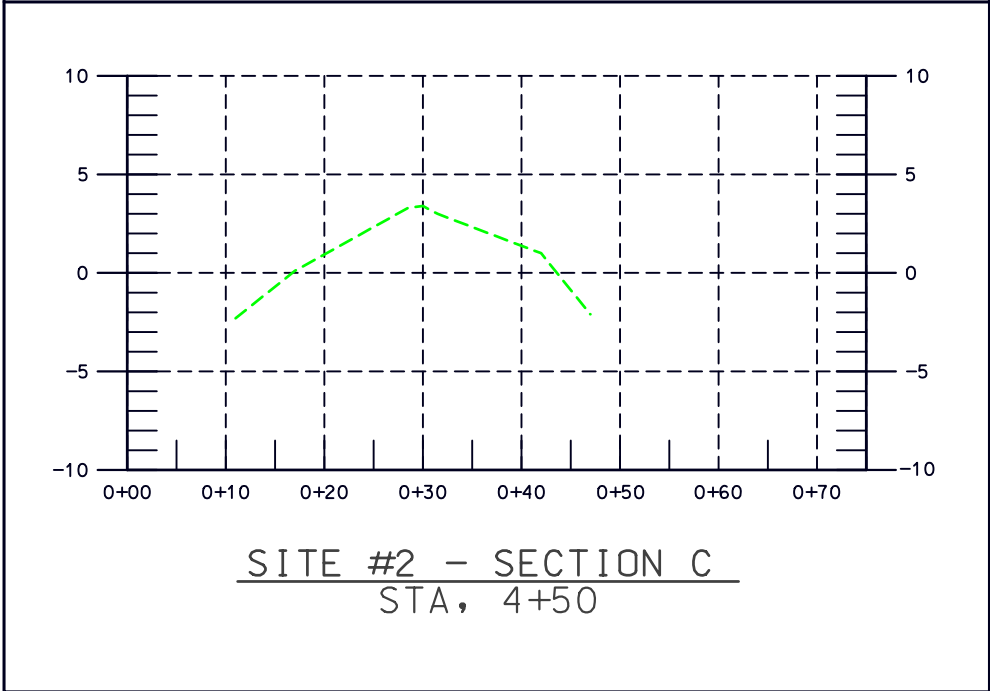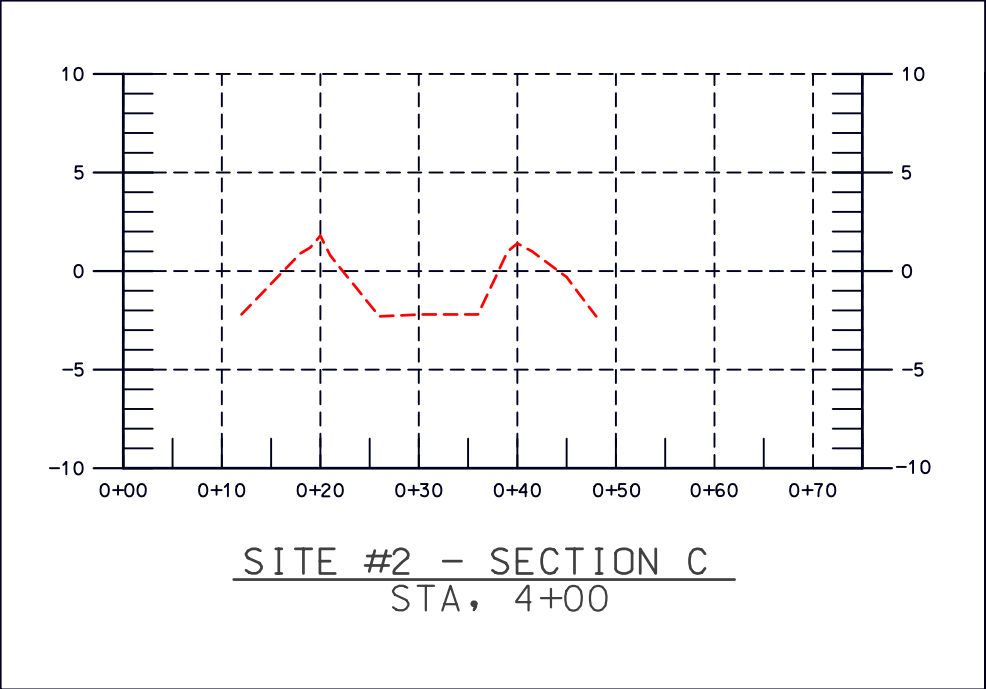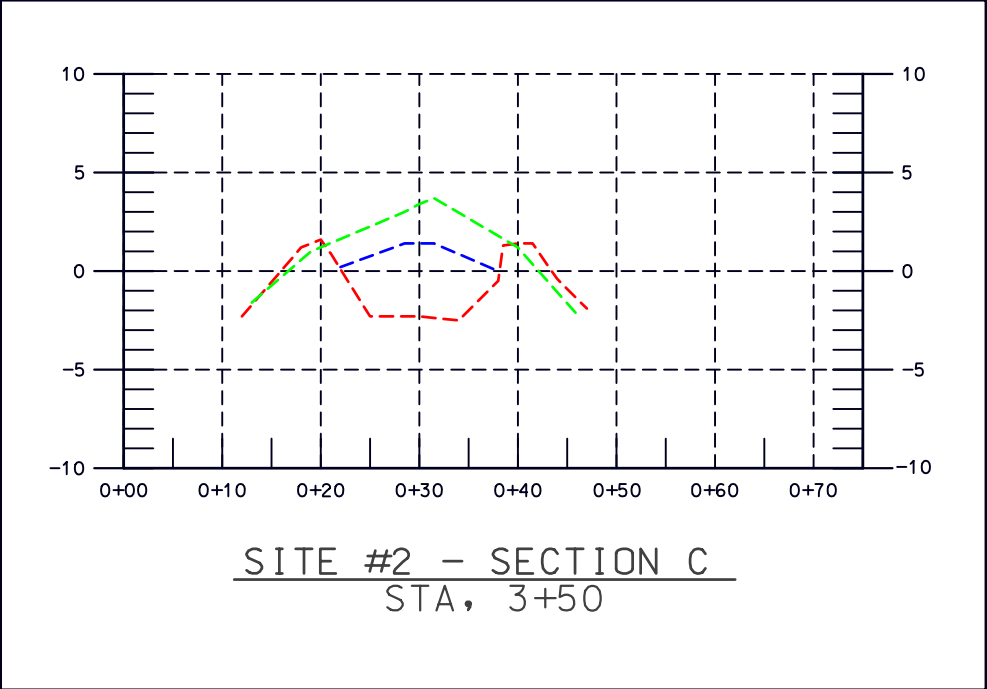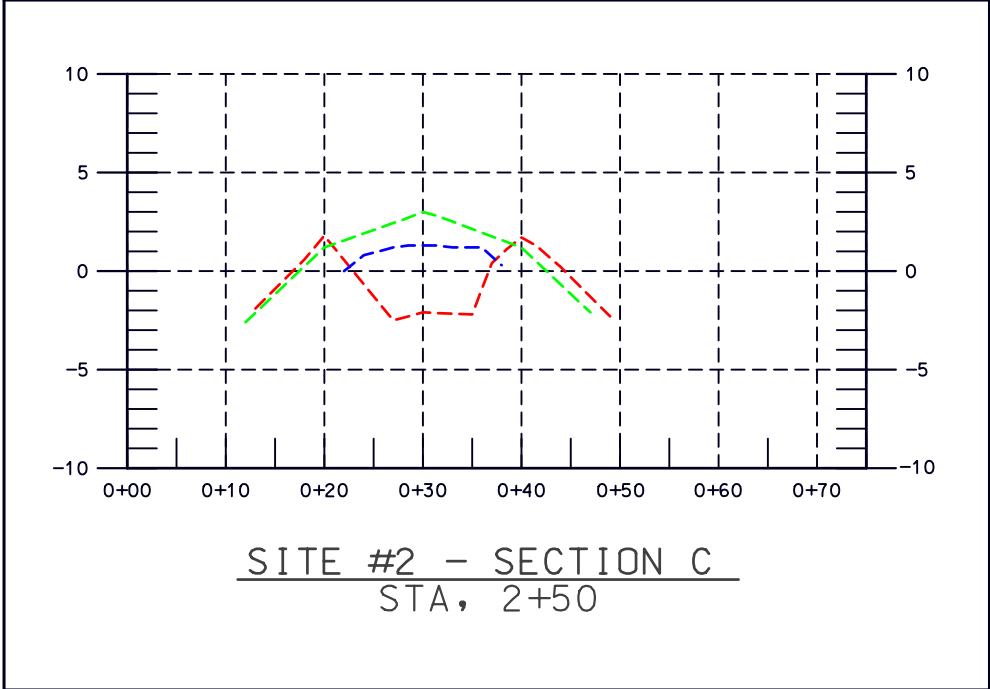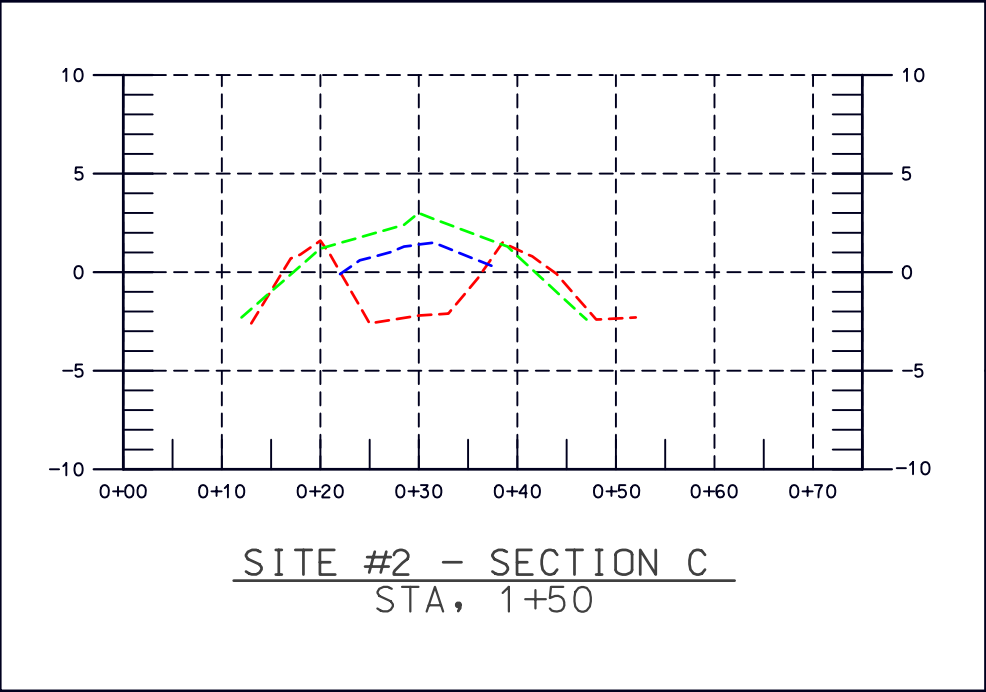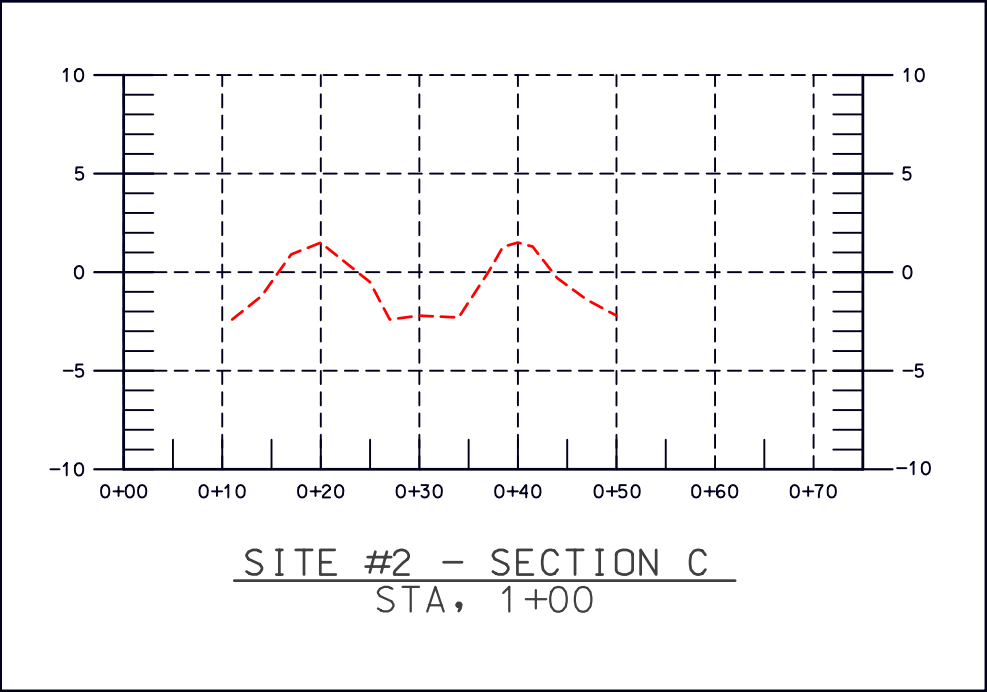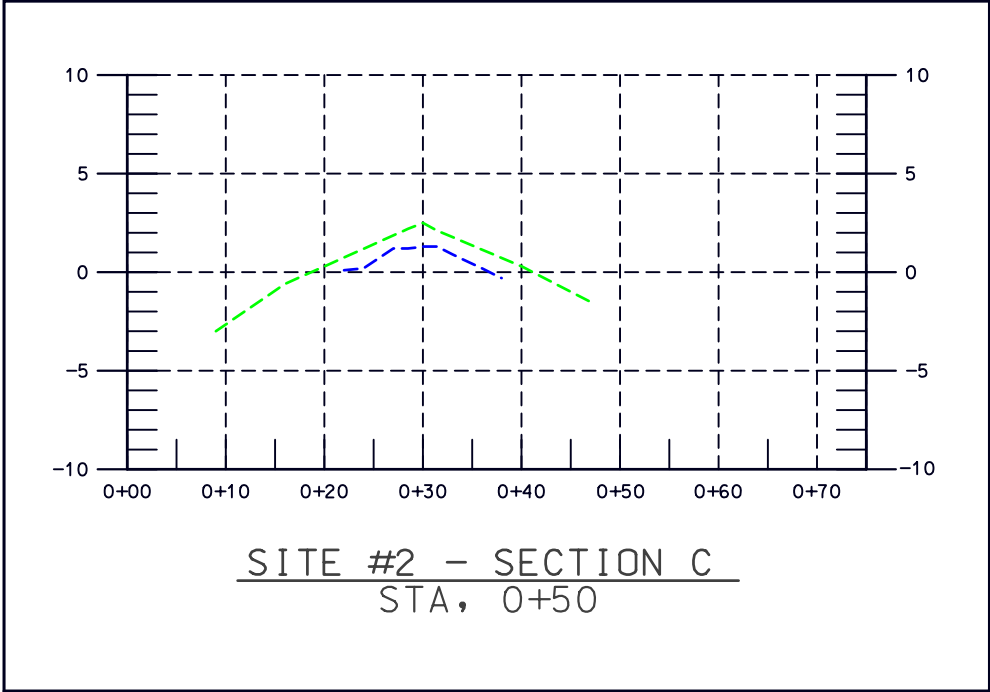

NO.		REVISIONS		SITE NO. 2 - AS-BUILT		Date	
	DATE		APPR.	BARATARIA BASIN LANDBRIDGE PROJECT		Designed	L. S. GARNER
				BA-27 - CONSTRUCTION UNIT NO. 1		Drawn	A. J. GREMILLION
				JEFFERSON AND LAFOURCHE PARISHES		Traced	
				LOUISIANA		Checked	B. STICKER
U.S. DEPARTMENT OF AGRICULTURE - NATURAL RESOURCES CONSERVATION SERVICE				Date			
CAD FILENAME				Approved by			
LA302012A8				E. J. GIERING, III			
PROJECT NO.				Title			
LA302				STATE CONSERVATION ENGINEER			
SHEET NO 12A8 OF 12				ALEXANDRIA, LOUISIANA			