

RACCOON ISLAND SHORELINE PROTECTION/ MARSH CREATION (TE-48) PROJECT TERREBONNE PARISH, LOUISIANA

SURVEY REPORT

PREPARED FOR:



Coastal Protection and
Restoration Authority of Louisiana

MAY 5, 2015



SUBMITTED BY:



RACCOON ISLAND SHORELINE PROTECTION/ MARSH CREATION (TE-48) PROJECT SURVEY REPORT

Prepared for: C.P.R.A.
Coastal Protection and Restoration Authority
450 Laurel Street
Baton Rouge, LA 70801

Submitted By: T. Baker Smith, LLC
412 S. Van Ave.
Houma, LA 70363

RACCOON ISLAND SHORELINE PROTECTON/ MARSH CREATION PROJECT NO. TE-48

TABLE OF CONTENTS

1.0	INTRODUCTION.....	1
2.0	PROJECT OVERVIEW	1
3.0	DATA COLLECTION SUMMARY	2
3.1	GPS STATIC SURVEY	2
3.2	MARSH CREATION PLATFORM TRANSECTS.....	2
3.3	ROCK STRUCTURES TRANSECTS AND PROFILES.....	2
3.4	SETTLEMENT PLATE ELEVATIONS	3
4.0	METHODOLOGY	3
4.1	SURVEY CONTROL AND DATUM INFORMATION.....	3
4.2	STATIC GPS NETWORK PLANNING	3
4.3	GPS STATIC SURVEY	4
4.4	DATA PROCESSING AND NETWORK ADJUSTMENT.....	4
4.5	TOPOGRAPHIC SURVEYS	5
5.0	CHRONOLOGICAL SUMMARY OF WORK	5

LIST OF APPENDICES

- APPENDIX 1 --- Survey Benchmark Datasheet: (TE48-SM-01)**
- APPENDIX 2 --- GPS Network Map**
- APPENDIX 3 --- GPS Session Schedule**
- APPENDIX 4 --- GPS Field Log Sheets**
- APPENDIX 5 --- Network Adjustment and OPUS Summary**
- APPENDIX 6 --- Initial and Weighted Free Network Report**
- APPENDIX 7 --- Fully Constrained Network Adjustment Report**
- APPENDIX 8 --- Loop Closures Report**
- APPENDIX 9 ---Survey Field Notes**

LIST OF DRAWINGS

- PACKAGE 1 --- Topographic Survey Set (22 Sheets)**

SURVEY REPORT

RACCOON ISLAND SHORELINE PROTECTION/ MARSH CREATION (TE-48) PROJECT TERREBONNE PARISH, LOUISIANA

1.0 INTRODUCTION

The purpose of the data collection tasks summarized in this report is to provide critical support information for monitoring orthometric heights, which are used to determine project success and ecosystem sustainability for the Raccoon Island Shoreline Protection/Marsh Creation (TE-48) Project. This task order is sponsored by the Operations Division of the Louisiana Coastal Protection and Restoration Authority (CPRA). The work performed by T. Baker Smith, LLC (TBS) and described in this report was outlined in *Scope of Services for Topographic and Bathymetric Surveys for Raccoon Island Shoreline Protection/Marsh Creation (TE-48) Project, Terrebonne Parish, Louisiana* dated November 1, 2014.

2.0 PROJECT OVERVIEW

Raccoon Island is the western most island of a twenty mile chain of islands named Isle Dernieres, which is located approximately 50 miles south of Houma, Louisiana. 17 rock structures (16 breakwaters and 1 groin) are currently present on the southeast portion of Raccoon Island. 8 of the breakwaters were constructed in 1997 for the Raccoon Island Breakwaters Demonstration (TE-29) Project, and the remaining 8 breakwaters and the east groin were constructed in 2007 for the Raccoon Island Shoreline Protection/Marsh Creation (TE-48) Project.

The primary objective of this project is to analyze geomorphic alterations in Raccoon Island caused by erosion and longshore sediment transportation. This analysis is performed by resurveying previously established and observed cross sectional transects. The locations and coordinates of the specific survey transects can be seen in Drawing Package 1.

3.0 DATA COLLECTION SUMMARY

Field data was collected by TBS utilizing a three-man survey crew during the period of February 6, 2015 through February 26, 2015. A 24' survey vessel with dual outboards was used for marine transportation. The field crew launched the boat at Jug's Marina located in Theriot, Louisiana on Bayou Dularge approximately 20 miles south of the TBS corporate office in Houma, Louisiana. The field crew performed the necessary GPS static surveys to establish the horizontal and vertical control on the monument "TE48-SM-01" (COON). The crew completed a topographic survey of the 17 rock structures and marsh creation platform and also established elevations for the 36 settlement plates located in the breakwaters and groin.

3.1 GPS STATIC SURVEY

A GPS static survey was completed for the existing survey monument "TE48-SM-01" (COON). This survey was done to update the survey data for the monument "TE48-SM-01". These surveys were performed on February 10 - 12, 2015 by collecting static GPS (GNSS) data during three (3) five-hour sessions.

3.2 MARSH CREATION PLATFORM TRANSECTS

Topographic surveys were performed along 10 transects located on the marsh creation platform. The transects run perpendicular to the island at approximately 500 foot intervals.

3.3 ROCK STRUCTURES TRANSECTS AND PROFILES

Topographic surveys were performed along 60 transects and 17 profiles over the breakwaters and groin rock structures. Each breakwater has 3 transects which run perpendicular to the structure and 1 profile along the length of the structure. The breakwaters are typically 300' in length. The 3 transects for each breakwater were spaced evenly at approximately 120' – 140' and are categorized by a west section, a mid section, and an east section. The groin contains 12 transects which run perpendicular to the structure and 1 profile along the length of the structure. The transects are spaced

approximately 100' apart. Stationing and transect placement for the east groin were taken from the Raccoon Island Shore Protection/ Marsh Creation Project Phase A (TE-48) "As-Built" Drawings dated 06/05.

An overall survey layout plan view showing the breakwater transect locations and a coordinate table can be seen in Drawing Package 1 (pages 1 - 2).

3.4 SETTLEMENT PLATES ELEVATIONS

Elevations were established at each of the 36 settlement plates installed in the rock breakwaters and groin. GPS shots of a duration of 10 seconds were taken to insure accuracy. A table showing the elevations of the settlement plates can be seen in Drawing Package 1 (page 2).

4.0 METHODOLOGY

4.1 SURVEY CONTROL AND DATUM INFORMATION

The horizontal datum for all survey data collected is Louisiana State Plane, South Zone (1702), NAD 83, in U.S. Survey feet. The vertical datum for all data collected is NAVD 88, Geoid 12A in U.S. Survey feet. The secondary GPS network monument "TE48-SM-01" (COON) was used as control for the survey.

4.2 STATIC GPS NETWORK PLANNING

The Static GPS Network was designed to incorporate four (4) CORS "Continuously Operating Reference Station" from the Center for GeoInformatics at LSU. The four CORS used for this survey were "DEV1", "FSHS", "GRIS", and "HOUM". They are located in Eugene Island 337, Franklin, Grand Isle, and Houma respectively. Since these stations are continuously collecting data, simultaneous data was collected for all four CORS during the time of the static survey of the monument. This schedule allowed the Static GPS Survey to be completed over a period of three days, which included redundant observations for each baseline. The GPS Session Schedule can be seen in Appendix 3. A map of the project area can be seen in Appendix 2.

4.3 GPS STATIC SURVEY

The GPS Static Survey was performed using a Trimble© R8 Model 3 GNSS receiver equipped with a Geodetic Antenna and fixed height tripod. The GPS receiver was set to collect L1 and L2 data at a 15 second epoch rate with a 10 degree elevation mask. Static GPS data was collected at the benchmark for a minimum of 5 hours per session. A total of three data collection sessions were performed on different days and at different times of the day. Field personnel documented each data collection setup on GPS field log sheets. These log sheets contain the date, start time, stop time, station name, GPS receiver serial number, weather conditions, etc. A copy of the field log sheets can be seen in Appendix 4.

4.4 DATA PROCESSING AND NETWORK ADJUSTMENT

The static GPS data was downloaded from the receiver and imported into Trimble© Business Center (TBC) for processing and QA/QC. Each setup was checked to verify that the antenna height and station name matched the corresponding field log sheet. GPS data files were also sent to OPUS to determine approximate position. These OPUS positions were checked against the log sheet to determine any setup errors.

The final (precise) ephemeris for the static GPS data was downloaded 18 days after the last field session was completed. The precise ephemeris data was then imported into TBC for final baseline processing and adjustment. Each baseline was processed using a 15 degree elevation mask and all baselines achieved a fixed solution with no editing. Next, a 3-D minimally constrained least squares (free) adjustment was performed holding monument “HOUM” fixed in latitude, longitude, and ellipsoid height. This adjustment used GEOID12A as the basis for determining orthometric heights of adjusted ellipsoid heights. The network was found to fit existing control within acceptable limits, and all primary control was found to be consistent with respect to differences in published and computed elevation values. The Initial and Weighted Free Adjustment Report can be seen in Appendix 6. Once the Free Adjustment passed the Chi Square Test, a fully constrained least squares adjustment was performed holding all

CORS fixed in latitude, longitude, and ellipsoid height. The Fully Constrained Network Adjustment report and final adjusted positions can be seen in Appendix 7. A summary of the residuals of adjusted positions versus OPUS positions can be seen in Appendix 5.

4.5 TOPOGRAPHIC SURVEYS

A Trimble© model R8 GNSS GPS RTK unit was used to collect the topographic field data. The manufacturer's stated accuracy of this unit is 2-3 cm horizontal, and 3-4 cm vertical. All RTK GPS Survey information was stored digitally using a Trimble TSC-3 Data Collector.

Topographic survey data was downloaded from the Trimble TSC-3 Data Collector into the Trimble Business Center software for processing. This software allows for QA/QC of GPS data, and was used to check for instrument setup errors, antenna height errors, and other discrepancies. This data was exported to digital point files and then entered into AutoCAD Civil 3D for further processing.

Manual soundings were taken with a level rod where collection of topography points using the RTK GPS were not obtainable due to high water depths or unsafe conditions. Easting, Northing and elevations (X, Y and Z) of the sounding points were calculated using a Microsoft Excel spreadsheet program. Beginning and ending point numbers for the sounding transects, stationing and top of water elevations were recorded in the field notes. The top of water elevations were taken using RTK GPS.

5.0 CHRONOLOGICAL SUMMARY OF WORK

Below is a table detailing the order in which the field data was collected. Because the project area is located within the Louisiana Department of Wildlife and Fisheries (LDWF) administered Isle Dernieres Barrier Islands Refuge, great effort was made to finish all of the field tasks by the end of February in order to avoid the 2015 waterbird nesting season which occurs approximately from March until July. Due to the location of this project on a barrier island in the Gulf of Mexico, accessibility to the site was highly weather dependent.

Survey Timeline			
DATE	SURVEY TYPE	PARTY CHIEF	DESCRIPTION
02/06/2015	Topo	Jeremy Stevens	Marsh Creation
02/10/2015	Static/ Topo	Jeremy Stevens	Static & Marsh Creation
02/11/2015	Static/ Topo	Jeremy Stevens	Static & Breakwater
02/12/2015	Static/ Topo	Jeremy Stevens	Static & Breakwater
02/13/2015	Static/ Topo	Jeremy Stevens	Static & Breakwater
02/19/2015	Topo	Jeremy Stevens	Breakwater
02/26/2015	Topo	Jeremy Stevens	Breakwater

APPENDIX 1

New Survey Benchmark Data Sheet:

TE48-SM-01



VICINITY MAP Scale: 1" = 2,000'

Reproduced from 2013 GOOGLE Earth Aerial Image

Station Name: "TE48-SM-01"

Monument Location: Located in Terrebonne Parish, Louisiana, on the north side of Raccoon Island in Isles Dernieres, and is approximately 24 miles southwesterly of Cocodrie, Louisiana.

Monument Description: NGS style floating sleeve monument; datum point set on 9/16" stainless steel sectional rods driven 88 feet to refusal, set in sand filled 6" PVC pipe with access cover set flush with the ground.

Stamping: "COON"

Installation Date: January 2005

Monument Established By: John Chance Land Surveys, Inc.

For: La. Dept. of Natural Resources, CRD

Date of Survey Update: March 10-12, 2015

Monument Updated By: T. Baker Smith, LLC

Adjusted NAD 83 (2011-Epoch 2010) Geodetic Position

Lat. 29° 03' 14.79114" N

Long. 90° 55' 59.37394" W

Adjusted NAD 83 Datum LSZ (1702) Feet

N= 201,740.531

E= 3,408,702.132

Adjusted NAVD88 (2011-Epoch 2010.0) Height

Elevation = 1.488 feet (0.454 mtrs.) (Geoid12A)

Ellipsoid Height = -23.624 mtrs.

Geoid12A Height = -24.078 mtrs.



APPENDIX 2

GPS Network Map



3/19/2015 - P:\Y-2015\2015.0072\DWG\GPS NETWORK\GPS NETWORK1.DWG



Coastal Protection and
Restoration Authority of Louisiana



T. BAKER SMITH
SOLUTIONS START HERE
412 South Van Ave., Houma, LA 70363
(985)868-1050 - tbsmith.com

SCALE: 1" = 14 MILES				DRAWN BY: A.W.S.	APPROVED BY: J.C.M.
				DATE: 3/17/2015	JOB NO: 2015.007
14 MILES	7 MILES	0'	14 MILES	DRAWING NAME: GPS NETWORK1.DWG	
REV. NO: 00	REV. DATE: --/-/-	REV. BY: ---	PROJECTION: LA 83-SF-MOD GEO. DATUM: NAD83 VERT. DATUM: NAVD88 Gd 12 GRID UNITS: US SURVEY FEET		
REVISION DESCRIPTION: --				SHEET NO: 1	OF 1

GPS NETWORK

**TE48 RACCOON ISLAND SHORELINE
PROTECTION/MARSH CREATION
TE48-SM-01 MONUMENT INSTALLATION
C.P.R.A.
COASTAL PROTECTION AND RESTORATION
TERREBONNE PARISH, LOUISIANA**

APPENDIX 3

Session Schedule

C.P.R.A. - Coastal Protection and Restoration Authority

*"TE48-SM-01" (Coon) Monument Resurvey
For
TE-48 Raccoon Island Shoreline Protection/Marsh Creation*



GPS SESSION SCHEDULE

Date	Monument	Operator / Crew	Session #	Start Time	End Time	Length
2/10/2015	TE48-SM-01	Jeremy Stevens	1	9:06	2:12	5:06
2/11/2015	TE48-SM-01	Jeremy Stevens	2	7:56	3:20	7:24
2/12/2015	TE48-SM-01	Jeremy Stevens	3	8:29	1:40	5:11

APPENDIX 4

GPS Field Log Sheets

USE THIS FORM IF USING FIXED HEIGHT TRIPODS TO DOCUMENT STATIC SURVEYS ON BASE POINTS FOR ALL RTK SURVEYS

GPS LOG SHEET

Job No. 2015_0072

Date 2-10-15

Observer J. STEVENS

Client TETRA-TECH

Job Description BREAKWATER SURVEY

Location RACCOON ISLAND

Proj. Mgr. J. MATTINGLY

SESSION INFO

4 Characters

File Name 1301

3 Characters

Julian Date 041

1 Character

Session No. 1

Long Name TG48-Sm-01 (Coon)

Mon. Description 9/16" SS Rod IN SAND-FILLED 6" PVC

Rec. Base Type R8 GNSS

Rec Serial # 5203481301

Base Ant Type

Base Ant Ser #

Rover Ant Type R8 GNSS

Rover Ant Ser # 5130469159

Antenna Height Measurement is **TRUE VERTICAL** to the Bottom of Antenna Mount if Using Fixed Hgt Tripod

Fixed Hgt 2 Meter Tripod

2.25 m

Mtrs or Ft

Tripod Number

1

Actual Start Time 0907

Actual Stop Time 1413

Session Time (Min 2:01 Hr) 5:06

BASE STATION INFORMATION

WGS84, NAD83 or NAD27

Example: LA South Zone or TX South Central Zone

DATUM NAD 83

ZONE LA SOUTH 1702

Northing/Lat 201740.571

Coordinate Origin-Where did you get your positions?

Easting/Long. 3408702.089

DATA SHEET

Elevation 2459

Note any power problems, obstructions, weather issues, etc.

ALL WHITE BOXES MUST BE FILLED IN WITH INFORMATION. A MINIMUM OBSERVATION OF 2 HOURS IS REQUIRED TO DETERMINE THE 3-D POSITION OF AN UNKNOWN POINT USING NGS-OPUS

USE BACK OF THIS SHEET TO MAKE STATION SKETCH, REFERENCE TIES & DESCRIPTION

USE THIS FORM IF USING FIXED HEIGHT TRIPODS TO DOCUMENT STATIC SURVEYS ON BASE POINTS FOR ALL RTK SURVEYS

GPS LOG SHEET

Job No.	2015_0072	Date	2-11-15	Observer	J. STEVENS
---------	-----------	------	---------	----------	------------

Client	TETRA - TECH	Job Description	BREAKWATER SURVEY
--------	--------------	-----------------	-------------------

Location	RACCOON ISLAND	Proj. Mgr.	J. MATTINGLY
----------	----------------	------------	--------------

SESSION INFO

4 Characters

File Name

1301

3 Characters

Julian Date

042

1 Character

Session No.

0

Long Name

T648-SM-01 (Coon)

Mon. Description

9/16" SS Rod in SAND-FILLED 6" PVC

Rec. Base Type

R8 GNSS

Rec Serial #

5203481301

Base Ant Type

Base Ant Ser #

Rover Ant Type

R8 GNSS

Rover Ant Ser #

513046 9159

Antenna Height Measurement is TRUE VERTICAL to the Bottom of Antenna Mount if Using Fixed Hgt Tripod

Fixed Hgt 2 Meter Tripod

2.25 m

Mtrs or Ft

Tripod Number

1

Actual Start Time

0756

Actual Stop Time

1520

Session Time
(Min 2:01 Hr)

7:24

BASE STATION INFORMATION

WGS84, NAD83 or NAD27

Example : LA South Zone or TX South Central Zone

DATUM

NAD 83

ZONE

LA SOUTH 1702

Northing/Lat

201740,571

Coordinate Origin-Where did you get your positions?

Easting/Long.

3408702.089

DATA SHEET

Elevation

2,459

Note any power problems, obstructions, weather issues, etc.

ALL WHITE BOXES MUST BE FILLED IN WITH INFORMATION. A MINIMUM OBSERVATION OF 2 HOURS IS REQUIRED TO DETERMINE THE 3-D POSITION OF AN UNKNOWN POINT USING NGS-OPUS

USE BACK OF THIS SHEET TO MAKE STATION SKETCH, REFERENCE TIES & DESCRIPTION

USE THIS FORM IF USING FIXED HEIGHT TRIPODS TO DOCUMENT STATIC SURVEYS ON BASE POINTS FOR ALL RTK SURVEYS

GPS LOG SHEET

Job No.	2015.0072	Date	2-12-15	Observer	J. STEVENS
Client	TETRA-TECH	Job Description			BREAKWATER SURVEY
Location	RACCOON ISLAND	Proj. Mgr.			J. MATTINGLY

SESSION INFO

File Name	4 Characters 1301	Julian Date	3 Characters 043	Session No.	1 Character 0
Long Name	TE48-SM-01 (Coon)				
Mon. Description	9/16" SS ROD IN SAND-FILLED 6" PVC				
Rec. Base Type	R8 GNSS		Rec Serial #	5203481301	
Base Ant Type			Base Ant Ser #		
Rover Ant Type	R8 GNSS		Rover Ant Ser #	513046 9159	

Antenna Height Measurement is **TRUE VERTICAL** to the Bottom of Antenna Mount if Using Fixed Hgt Tripod

Fixed Hgt 2 Meter Tripod 2.25 m Mtrs or Ft

Tripod Number 1

Actual Start Time 0829 Actual Stop Time 1340 Session Time (Min 2:01 Hr) 5:12

BASE STATION INFORMATION

WGS84, NAD83 or NAD27

Example: LA South Zone or TX South Central Zone

DATUM	NAD 83	ZONE	LA SOUTH 1702
Northing/Lat		201740.571	
Easting/Long.		3408702.089	
Elevation		2.459	
Coordinate Origin-Where did you get your positions? DATA SHEET			

Note any power problems, obstructions, weather issues, etc.

ALL WHITE BOXES MUST BE FILLED IN WITH INFORMATION. A MINIMUM OBSERVATION OF 2 HOURS IS REQUIRED TO DETERMINE THE 3-D POSITION OF AN UNKNOWN POINT USING NGS-OPUS

USE BACK OF THIS SHEET TO MAKE STATION SKETCH, REFERENCE TIES & DESCRIPTION

GPS STATION OBSERVATION SHEET

SHEET of

PROJECT: 2015.0072

STATION NAME: TE48-SM-01 (Coon)

STATION ID: TE48-SM-01 (Coon)

DATE FOUND/SET: _____

STATION DESCRIPTION: 9/16" SS ROD IN SAND-FILLED
6" PVC

STATION STAMPING: Coon

STATION ACCESS: _____

ACCESS SKETCH

OBSERVER: J. STEVENS

RECEIVER TYPE: PSP GNSS ANTENNA TYPE: _____

SESSION #: 13010411 FILE NAME: 13010411.T02

LOCAL DATE: 2-10-15 START: 0907 END: 1413

UTC DATE: _____ JULIAN DAY: 041
UTC START: _____ UTC END: _____


ANTENNA DETAILS:

MEASUREMENT TYPE (TRUE/UNCORRECTED): 2.25m

START (1st) _____ (2nd) _____ (3rd) _____ (AVG) _____

STOP (1st) _____ (2nd) _____ (3rd) _____ (AVG) _____

OBSTRUCTION CHART

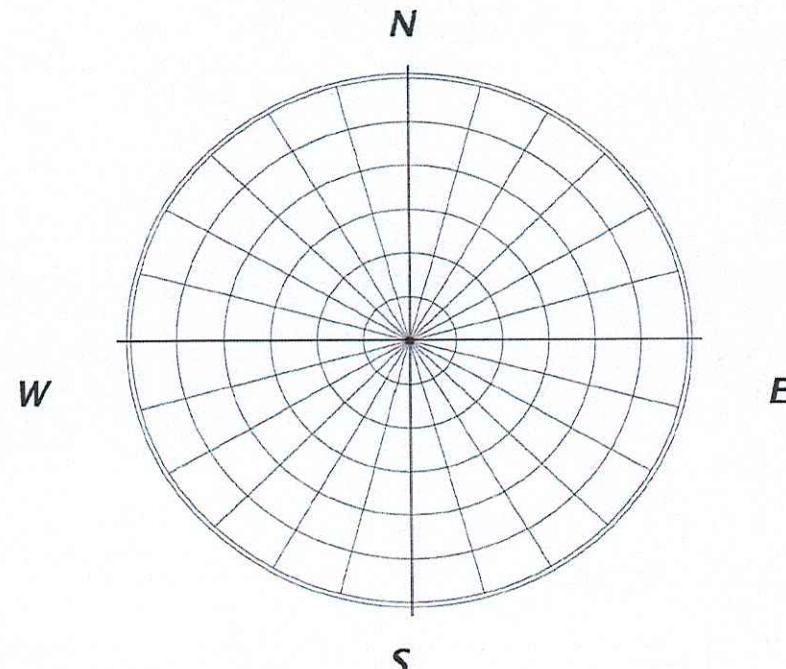

LAT: _____ LONG: _____ HEIGHT: _____

GPS STATION OBSERVATION SHEET

SHEET of

PROJECT: 2015.0072

STATION NAME: TE 48-Sm-01 (Coon)

STATION ID: TE 48-Sm-01 (Coon)

DATE FOUND/SET: _____

STATION DESCRIPTION: 9/16" SS Rod IN SAND-FILLED
6" PVC

STATION STAMPING: Coon

STATION ACCESS: _____

ACCESS SKETCH

OBSERVER: J. STEVENS

RECEIVER TYPE: R8 GNSS ANTENNA TYPE: _____

SESSION #: 13010420 FILE NAME: 13010420.T02

LOCAL DATE: 2-11-15 START: 0756 END: 1520

UTC DATE: _____ JULIAN DAY: 042

UTC START: _____ UTC END: _____


ANTENNA DETAILS:

MEASUREMENT TYPE (TRUE/UNCORRECTED): 2,25 m

START (1st) (2nd) (3rd) (AVG)

STOP (1st) (2nd) (3rd) (AVG)

OBSTRUCTION CHART

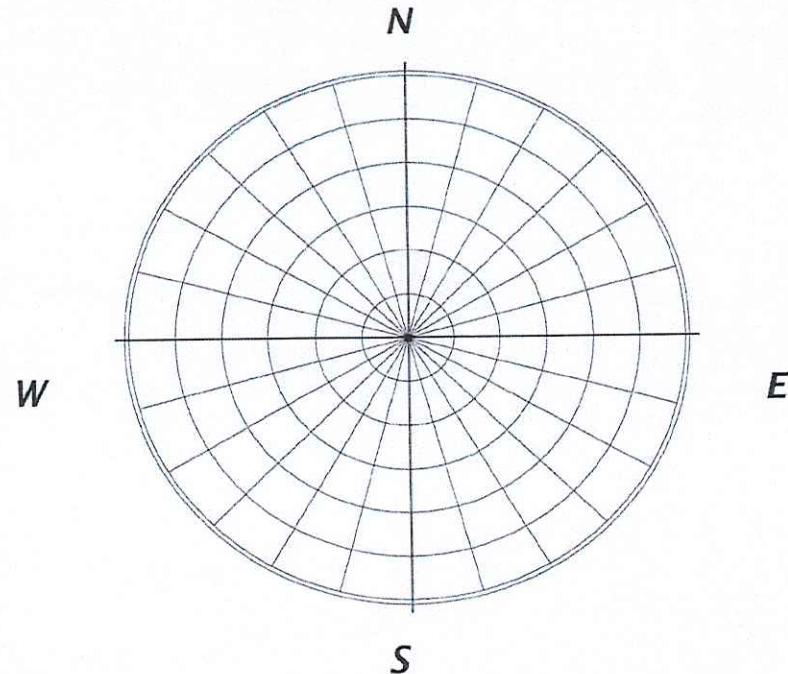

LAT: _____ LONG: _____ HEIGHT: _____

GPS STATION OBSERVATION SHEET

SHEET of

PROJECT: 2015.0072

STATION NAME: TE48-SM-01 (Coon)

STATION ID: TE48-SM-01 (Coon)

DATE FOUND/SET: _____

STATION DESCRIPTION: 9/16" SS Rod in Sand-filled
6" PVC

STATION STAMPING: Coon

STATION ACCESS: _____

ACCESS SKETCH

OBSERVER: J. STEVENS

RECEIVER TYPE: R8 GNSS ANTENNA TYPE: _____

SESSION #: 13010430 FILE NAME: 13010430.T02

LOCAL DATE: 2-12-15 START: 0829 END: 1340

UTC DATE: _____ JULIAN DAY: 043

UTC START: _____ UTC END: _____


ANTENNA DETAILS:

MEASUREMENT TYPE (TRUE/UNCORRECTED): 2.25m

START (1st) _____ (2nd) _____ (3rd) _____ (AVG) _____

STOP (1st) _____ (2nd) _____ (3rd) _____ (AVG) _____

OBSTRUCTION CHART

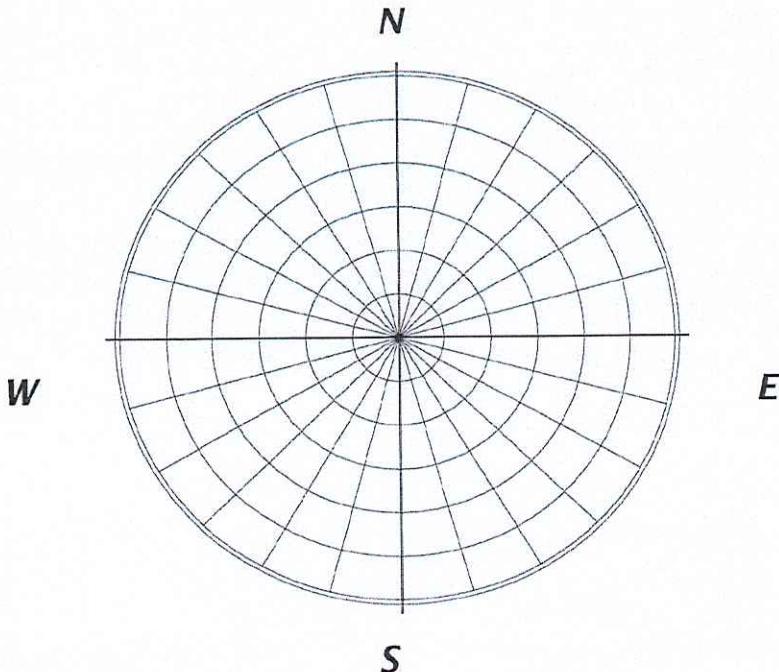

LAT: _____ LONG: _____ HEIGHT: _____

APPENDIX 5

Network Adjustment and OPUS Summary

C.P.R.A. - Coastal Protection and Restoration Authority

Elevation Survey Update of "TE48-SM-01"
For
TE-48 Raccoon Island Shoreline Protection/Marsh Creation



MINIMALLY CONSTRAINED NETWORK ADJUSTMENT SUMMARY

Station	TBC Adjusted Values			Published Control Values			Residuals		
	Northing (ft)	Easting (ft)	Ht. (ft)	Northing (ft)	Easting (ft)	Ht. (ft)	Δ Northing (ft)	Δ Easting (ft)	Δ Ht. (ft)
DEV1	-117001.382	3152130.399	112.969	-117001.388	3152130.360	112.994	0.023	0.023	0.024
FSHS	474730.211	3227265.780	37.464	474730.254	3227265.765	37.424	0.023	0.023	0.025
GRIS	281033.491	3719590.181	27.348	281033.474	3719590.183	27.375	0.023	0.023	0.024
HOUN	Fixed	Fixed	Fixed	397729.333	3474618.955	45.350	Fixed	Fixed	Fixed
TE48-SM-01(COON)	201740.531	3408702.147	1.477	-	-	-	0.023	0.023	0.025

FULLY CONSTRAINED NETWORK ADJUSTMENT SUMMARY

Station	TBC Adjusted Values			Published Control Values			Precision (95% Confidence Level)		
	Northing (ft)	Easting (ft)	El. (ft)*	Northing (ft)	Easting (ft)	Ht. (ft)	Northing (ft)	Easting (ft)	El. (ft)*
DEV1	Fixed	Fixed	Fixed	-117001.388	3152130.36	112.994	Fixed	Fixed	Fixed
FSHS	Fixed	Fixed	Fixed	474730.254	3227265.765	37.424	Fixed	Fixed	Fixed
GRIS	Fixed	Fixed	Fixed	281033.474	3719590.183	27.375	Fixed	Fixed	Fixed
HOUN	Fixed	Fixed	Fixed	397729.333	3474618.955	45.350	Fixed	Fixed	Fixed
TE48-SM-01(COON)	201740.531	3408702.132	1.488	-	-	-	0.018	0.018	0.021

OPUS ELEVATION SUMMARY

Station	Final OPUS Values			Notes	TBC Adjusted Elevation (ft)	Δ Elev (ft)*
	Elevation (m)	Elevation (ft)	RMS			
TE112-SM-01	0.429	1.407	0.013		1.488	0.081
	0.449	1.473	0.015		1.488	0.015
	0.427	1.401	0.012		1.488	0.087
Average	0.435	1.427			1.488	0.046

* - Elevations expressed in NAVD88 computed using GEOID 12A

APPENDIX 6

Initial and Weighted Free Network Adjustment Report

Project File Data		Coordinate System
Name:	P:\Y-2015\2015.0072\FieldData\TBC_Files\2015.0072_cp.vce	Name: US State Plane 1983
Size:	1 MB	Datum: NAD 1983 (Conus)
Modified:	3/18/2015 4:01:22 PM (UTC:-5)	Zone: Louisiana South
Time zone:	Central Standard Time	Geoid: 1702
Reference number:		Vertical datum: GEOID12A (Conus)
Description:		NAVD88 (2011)

Network Adjustment Report

Adjustment Settings

Set-Up Errors

GNSS

Error in Height of Antenna: 0.003 ft

Centering Error: 0.010 ft

Covariance Display

Horizontal:

Propagated Linear Error [E]: U.S.

Constant Term [C]: 0.000 ft

Scale on Linear Error [S]: 1.960

Three-Dimensional

Propagated Linear Error [E]: U.S.

Constant Term [C]: 0.000 ft

Scale on Linear Error [S]: 1.960

Adjustment Statistics

Number of Iterations for Successful Adjustment: 2

Network Reference Factor: 1.00

Chi Square Test (95%): Passed

Precision Confidence Level: 95%
 Degrees of Freedom: 78

Post Processed Vector Statistics

Reference Factor: 1.00
 Redundancy Number: 78.00
 A Priori Scalar: 2.14

Control Coordinate Comparisons

Values shown are control coordinates minus adjusted coordinates.

Point ID	ΔEasting (US survey foot)	ΔNorthing (US survey foot)	ΔElevation (US survey foot)	ΔHeight (US survey foot)
DEV1	-0.040	-0.006	?	0.025
FSHS	-0.015	0.043	?	-0.039
GRIS	0.002	-0.017	?	0.027

Control Point Constraints

Point ID	Type	East σ (US survey foot)	North σ (US survey foot)	Height σ (US survey foot)	Elevation σ (US survey foot)
HOUM	Local	Fixed	Fixed	Fixed	

Fixed = 0.000003(US survey foot)

Adjusted Grid Coordinates

Point ID	Easting (US survey foot)	Easting Error (US survey foot)	Northing (US survey foot)	Northing Error (US survey foot)	Elevation (US survey foot)	Elevation Error (US survey foot)	Constraint
DEV1	3152130.399	0.023	-117001.382	0.023	112.969	0.024	
FSHS	3227265.780	0.023	474730.211	0.023	37.464	0.025	
	3719590.181		281033.491				

GRIS		0.023		0.023	27.348	0.024	
HOUm	3474618.955	?	397729.333	?	45.350	?	LLh
TE48-SM-01 (COON)	3408702.147	0.023	201740.531	0.023	1.477	0.025	

Adjusted Geodetic Coordinates

Point ID	Latitude	Longitude	Height (US survey foot)	Height Error (US survey foot)	Constraint
DEV1	N28°10'39.742732231"	W91°43'57.509876330"	34.575	0.024	
FSHS	N29°48'19.102817433"	W91°30'08.051073434"	-47.549	0.025	
GRIS	N29°15'55.883167151"	W89°57'26.262279193"	-51.313	0.024	
HOUm	N29°35'32.109640000"	W90°43'24.988470000"	-37.182	?	LLh
TE48-SM-01 (COON)	N29°03'14.791136597"	W90°55'59.373766236"	-77.518	0.025	

Adjusted ECEF Coordinates

Point ID	X (US survey foot)	X Error (US survey foot)	Y (US survey foot)	Y Error (US survey foot)	Z (US survey foot)	Z Error (US survey foot)	3D Error (US survey foot)	Constraint
DEV1	-558134.754	0.023	-18451026.857	0.024	9822435.339	0.023	0.040	
FSHS	-476410.891	0.023	-18166300.675	0.025	10340063.694	0.023	0.041	
GRIS	13616.874	0.023	-18269305.496	0.024	10169272.619	0.023	0.040	
HOUm	-229986.085	?	-18209490.634	?	10272765.225	?	?	LLh
TE48-SM-	-298143.377		-18304318.818		10102124.217			

01 (COON)		0.023		0.025		0.023	0.041	
-------------------------------	--	-------	--	-------	--	-------	-------	--

Error Ellipse Components

Point ID	Semi-major axis (US survey foot)	Semi-minor axis (US survey foot)	Azimuth
DEV1	0.029	0.028	42°
FSHS	0.029	0.028	102°
GRIS	0.029	0.028	97°
TE48-SM-01 (COON)	0.028	0.028	16°

Adjusted GNSS Observations

Observation ID		Observation	A-posteriori Error	Residual	Standardized Residual
DEV1 --> TE48-SM-01 (COON) (PV1077)	Az.	38°38'31"	0.011 sec	-0.002 sec	-0.136
	ΔHt.	-112.093 ft	0.026 ft	-0.036 ft	-1.173
	Ellip Dist.	409084.735 ft	0.023 ft	0.107 ft	3.582
FSHS --> TE48-SM-01 (COON) (PV1079)	Az.	146°18'30"	0.014 sec	-0.064 sec	-3.426
	ΔHt.	-29.968 ft	0.026 ft	-0.031 ft	-0.995
	Ellip Dist.	327790.117 ft	0.023 ft	-0.029 ft	-0.974
HOUM --> TE48-SM-01 (COON) (PV1104)	Az.	198°53'36"	0.023 sec	-0.025 sec	-0.861
	ΔHt.	-40.336 ft	0.025 ft	-0.031 ft	-1.022
	Ellip Dist.	206777.026 ft	0.023 ft	-0.095 ft	-3.257
GRIS --> TE48-SM-01 (COON) (PV1080)	Az.	256°22'25"	0.015 sec	0.047 sec	2.555
	ΔHt.	-26.204 ft	0.026 ft	-0.030 ft	-0.979
	Ellip	320830.083	0.023 ft	-0.072 ft	-2.434

	Dist.	ft			
<u>HOUN --> TE48-SM-01 (COON)</u> <u>(PV1108)</u>	Az.	198°53'36"	0.023 sec	0.011 sec	0.367
	ΔHt.	-40.336 ft	0.025 ft	0.025 ft	0.751
	Ellip Dist.	206777.026 ft	0.023 ft	0.070 ft	2.345
<u>FSHS --> TE48-SM-01 (COON)</u> <u>(PV1083)</u>	Az.	146°18'30"	0.014 sec	0.040 sec	2.041
	ΔHt.	-29.968 ft	0.026 ft	-0.002 ft	-0.056
	Ellip Dist.	327790.117 ft	0.023 ft	0.022 ft	0.663
<u>GRIS --> TE48-SM-01 (COON)</u> <u>(PV1084)</u>	Az.	256°22'25"	0.015 sec	-0.008 sec	-0.357
	ΔHt.	-26.204 ft	0.026 ft	-0.100 ft	-1.559
	Ellip Dist.	320830.083 ft	0.023 ft	0.061 ft	1.850
<u>DEV1 --> TE48-SM-01 (COON)</u> <u>(PV1081)</u>	Az.	38°38'31"	0.011 sec	0.002 sec	0.162
	ΔHt.	-112.093 ft	0.026 ft	0.013 ft	0.382
	Ellip Dist.	409084.735 ft	0.023 ft	-0.054 ft	-1.767
<u>HOUN --> TE48-SM-01 (COON)</u> <u>(PV1100)</u>	Az.	198°53'36"	0.023 sec	0.010 sec	0.351
	ΔHt.	-40.336 ft	0.025 ft	0.048 ft	1.483
	Ellip Dist.	206777.026 ft	0.023 ft	0.050 ft	1.679
<u>DEV1 --> TE48-SM-01 (COON)</u> <u>(PV1073)</u>	Az.	38°38'31"	0.011 sec	0.000 sec	0.012
	ΔHt.	-112.093 ft	0.026 ft	0.034 ft	1.089
	Ellip Dist.	409084.735 ft	0.023 ft	-0.044 ft	-1.471
<u>FSHS --> TE48-SM-01 (COON)</u> <u>(PV1075)</u>	Az.	146°18'30"	0.014 sec	0.023 sec	1.261
	ΔHt.	-29.968 ft	0.026 ft	0.019 ft	0.587
	Ellip Dist.	327790.117 ft	0.023 ft	0.023 ft	0.783
<u>GRIS --> TE48-SM-01 (COON)</u> <u>(PV1076)</u>	Az.	256°22'25"	0.015 sec	-0.018 sec	-0.975
	ΔHt.	-26.204 ft	0.026 ft	0.041 ft	1.145
	Ellip	320830.083			

	Dist.	ft	0.023 ft	0.034 ft	1.150
<u>DEV1 --> FSHS (PV1070)</u>	Az.	7°02'20"	0.008 sec	-0.001 sec	-0.101
	ΔHt.	-82.124 ft	0.026 ft	-0.002 ft	-0.034
	Ellip Dist.	596415.462 ft	0.023 ft	-0.017 ft	-0.536
<u>GRIS --> HOUT (PV1111)</u>	Az.	296°09'21"	0.017 sec	-0.011 sec	-0.480
	ΔHt.	14.132 ft	0.024 ft	0.012 ft	0.418
	Ellip Dist.	271352.690 ft	0.023 ft	-0.005 ft	-0.179
<u>GRIS --> DEV1 (PV1067)</u>	Az.	235°37'34"	0.007 sec	0.001 sec	0.084
	ΔHt.	85.888 ft	0.025 ft	-0.013 ft	-0.453
	Ellip Dist.	693010.121 ft	0.023 ft	-0.005 ft	-0.179
<u>GRIS --> FSHS (PV1048)</u>	Az.	292°09'28"	0.009 sec	0.005 sec	0.403
	ΔHt.	3.764 ft	0.026 ft	-0.001 ft	-0.047
	Ellip Dist.	529077.524 ft	0.023 ft	-0.005 ft	-0.163
<u>DEV1 --> HOUT (PV1101)</u>	Az.	31°52'43"	0.008 sec	-0.002 sec	-0.180
	ΔHt.	-71.757 ft	0.024 ft	-0.011 ft	-0.353
	Ellip Dist.	607325.600 ft	0.023 ft	0.003 ft	0.099
<u>GRIS --> HOUT (PV1103)</u>	Az.	296°09'21"	0.017 sec	-0.002 sec	-0.082
	ΔHt.	14.132 ft	0.024 ft	0.010 ft	0.337
	Ellip Dist.	271352.690 ft	0.023 ft	0.004 ft	0.148
<u>GRIS --> FSHS (PV1050)</u>	Az.	292°09'28"	0.009 sec	-0.002 sec	-0.139
	ΔHt.	3.764 ft	0.026 ft	0.002 ft	0.039
	Ellip Dist.	529077.524 ft	0.023 ft	-0.011 ft	-0.316
<u>GRIS --> HOUT (PV1107)</u>	Az.	296°09'21"	0.017 sec	0.002 sec	0.071
	ΔHt.	14.132 ft	0.024 ft	0.008 ft	0.295

	Ellip Dist.	271352.690 ft	0.023 ft	-0.004 ft	-0.139
<u>GRIS --> DEV1 (PV1063)</u>	Az.	235°37'34"	0.007 sec	-0.001 sec	-0.127
	ΔHt.	85.888 ft	0.025 ft	0.008 ft	0.268
	Ellip Dist.	693010.121 ft	0.023 ft	0.007 ft	0.243
<u>FSHS --> HOUM (PV1106)</u>	Az.	107°12'30"	0.018 sec	0.005 sec	0.201
	ΔHt.	10.368 ft	0.025 ft	0.005 ft	0.190
	Ellip Dist.	259076.765 ft	0.023 ft	0.007 ft	0.243
<u>FSHS --> HOUM (PV1110)</u>	Az.	107°12'30"	0.018 sec	-0.001 sec	-0.033
	ΔHt.	10.368 ft	0.025 ft	0.003 ft	0.074
	Ellip Dist.	259076.765 ft	0.023 ft	-0.007 ft	-0.221
<u>DEV1 --> HOUM (PV1105)</u>	Az.	31°52'43"	0.008 sec	0.002 sec	0.194
	ΔHt.	-71.757 ft	0.024 ft	0.003 ft	0.103
	Ellip Dist.	607325.600 ft	0.023 ft	-0.001 ft	-0.034
<u>DEV1 --> HOUM (PV1109)</u>	Az.	31°52'43"	0.008 sec	0.000 sec	-0.047
	ΔHt.	-71.757 ft	0.024 ft	-0.006 ft	-0.171
	Ellip Dist.	607325.600 ft	0.023 ft	0.002 ft	0.064
<u>DEV1 --> FSHS (PV1066)</u>	Az.	7°02'20"	0.008 sec	0.000 sec	-0.047
	ΔHt.	-82.124 ft	0.026 ft	0.003 ft	0.116
	Ellip Dist.	596415.462 ft	0.023 ft	-0.004 ft	-0.140
<u>DEV1 --> FSHS (PV1062)</u>	Az.	7°02'20"	0.008 sec	-0.001 sec	-0.058
	ΔHt.	-82.124 ft	0.026 ft	-0.004 ft	-0.132
	Ellip Dist.	596415.462 ft	0.023 ft	0.002 ft	0.066
<u>FSHS --> HOUM (PV1102)</u>	Az.	107°12'30"	0.018 sec	0.003 sec	0.124
	ΔHt.	10.368 ft	0.025 ft	0.002 ft	0.054

	Ellip Dist.	259076.765 ft	0.023 ft	0.000 ft	-0.011
GRIS --> FSHS (PV1046)	Az.	292°09'28"	0.009 sec	0.001 sec	0.086
	ΔHt.	3.764 ft	0.026 ft	0.002 ft	0.066
	Ellip Dist.	529077.524 ft	0.023 ft	-0.001 ft	-0.028
GRIS --> DEV1 (PV1071)	Az.	235°37'34"	0.007 sec	0.000 sec	0.008
	ΔHt.	85.888 ft	0.025 ft	0.000 ft	0.008
	Ellip Dist.	693010.121 ft	0.023 ft	0.002 ft	0.054

Covariance Terms

From Point	To Point		Components	A-posteriori Error	Horiz. Precision (Ratio)	3D Precision (Ratio)
DEV1	HOUM	Az.	31°52'43"	0.008 sec	1 : 26591500 26591875	1 : 26591875
		ΔHt.	-71.757 ft	0.024 ft		
		ΔElev.	-67.619 ft	0.024 ft		
		Ellip Dist.	607325.600 ft	0.023 ft		
DEV1	TE48-SM-01 (COON)	Az.	38°38'31"	0.011 sec	1 : 17783171 17783137	1 : 17783137
		ΔHt.	-112.093 ft	0.026 ft		
		ΔElev.	-111.492 ft	0.026 ft		
		Ellip Dist.	409084.735 ft	0.023 ft		
FSHS	DEV1	Az.	187°09'02"	0.008 sec	1 : 25956782 25956898	1 : 25956898
		ΔHt.	82.124 ft	0.026 ft		
		ΔElev.	75.505 ft	0.026 ft		
		Ellip Dist.	596415.462 ft	0.023 ft		
FSHS	HOUM	Az.	107°12'30"	0.018 sec	1 : 11279975 11279941	1 : 11279941
		ΔHt.	10.368 ft	0.025 ft		

		ΔElev.	7.887 ft	0.025 ft		
		Ellip Dist.	259076.765 ft	0.023 ft		
<u>FSHS</u>	<u>TE48-SM-01 (COON)</u>	Az.	146°18'30"	0.014 sec	1 : 14221332	1 : 14221471
		ΔHt.	-29.968 ft	0.026 ft		
		ΔElev.	-35.987 ft	0.026 ft		
		Ellip Dist.	327790.117 ft	0.023 ft		
<u>GRIS</u>	<u>DEV1</u>	Az.	235°37'34"	0.007 sec	1 : 30251864	1 : 30250548
		ΔHt.	85.888 ft	0.025 ft		
		ΔElev.	85.621 ft	0.025 ft		
		Ellip Dist.	693010.121 ft	0.023 ft		
<u>GRIS</u>	<u>FSHS</u>	Az.	292°09'28"	0.009 sec	1 : 22638798	1 : 22641906
		ΔHt.	3.764 ft	0.026 ft		
		ΔElev.	10.116 ft	0.026 ft		
		Ellip Dist.	529077.524 ft	0.023 ft		
<u>GRIS</u>	<u>HOUM</u>	Az.	296°09'21"	0.017 sec	1 : 11847663	1 : 11849112
		ΔHt.	14.132 ft	0.024 ft		
		ΔElev.	18.003 ft	0.024 ft		
		Ellip Dist.	271352.690 ft	0.023 ft		
<u>GRIS</u>	<u>TE48-SM-01 (COON)</u>	Az.	256°22'25"	0.015 sec	1 : 13933051	1 : 13930367
		ΔHt.	-26.204 ft	0.026 ft		
		ΔElev.	-25.871 ft	0.026 ft		
		Ellip Dist.	320830.083 ft	0.023 ft		
<u>TE48-SM-01 (COON)</u>	<u>HOUM</u>	Az.	18°47'26"	0.023 sec	1 : 9077293	1 : 9077371
		ΔHt.	40.336 ft	0.025 ft		
		ΔElev.	43.874 ft	0.025 ft		
		Ellip Dist.	206777.026 ft	0.023 ft		

APPENDIX 7

Fully Constrained Network Adjustment Report

Project File Data		Coordinate System	
Name:	P:\Y-2015\2015.0072\FieldData\TBC_Files\2015.0072_cp.vce	Name:	US State Plane 1983
Size:	1 MB	Datum:	NAD 1983 (Conus)
Modified:	3/18/2015 4:01:22 PM (UTC:-5)	Zone:	Louisiana South
Time zone:	Central Standard Time	Geoid:	GEOID12A (Conus)
Reference number:		Vertical datum:	NAVD88 (2011)
Description:			

Network Adjustment Report

Adjustment Settings

Set-Up Errors

GNSS

Error in Height of Antenna: 0.003 ft

Centering Error: 0.010 ft

Covariance Display

Horizontal:

Propagated Linear Error [E]: U.S.

Constant Term [C]: 0.000 ft

Scale on Linear Error [S]: 1.960

Three-Dimensional

Propagated Linear Error [E]: U.S.

Constant Term [C]: 0.000 ft

Scale on Linear Error [S]: 1.960

Adjustment Statistics

Number of Iterations for Successful Adjustment: 2

Network Reference Factor: 1.00

Chi Square Test (95%): Passed

Precision Confidence Level: 95%
 Degrees of Freedom: 83

Post Processed Vector Statistics

Reference Factor: 1.00
 Redundancy Number: 83.00
 A Priori Scalar: 2.17

Control Point Constraints

Point ID	Type	East σ (US survey foot)	North σ (US survey foot)	Height σ (US survey foot)	Elevation σ (US survey foot)
DEV1	Local	Fixed	Fixed	Fixed	
FSHS	Local	Fixed	Fixed	Fixed	
GRIS	Local	Fixed	Fixed	Fixed	
HOUM	Local	Fixed	Fixed	Fixed	
Fixed = 0.000003(US survey foot)					

Adjusted Grid Coordinates

Point ID	Easting (US survey foot)	Easting Error (US survey foot)	Northing (US survey foot)	Northing Error (US survey foot)	Elevation (US survey foot)	Elevation Error (US survey foot)	Constraint
DEV1	3152130.360	?	-117001.388	?	112.994	?	LLh
FSHS	3227265.765	?	474730.254	?	37.424	?	LLh
GRIS	3719590.183	?	281033.474	?	27.375	?	LLh
HOUM	3474618.955	?	397729.333	?	45.350	?	LLh
TE48-SM-01(COON)	3408702.132	0.018	201740.531	0.018	1.488	0.021	

Adjusted Geodetic Coordinates

Point ID	Latitude	Longitude	Height (US survey foot)	Height Error (US survey foot)	Constraint
DEV1	N28°10'39.742670000"	W91°43'57.510320000"	34.600	?	LLh
FSHS	N29°48'19.103240000"	W91°30'08.051250000"	-47.588	?	LLh
GRIS	N29°15'55.883000000"	W89°57'26.262260000"	-51.286	?	LLh
HOUT	N29°35'32.109640000"	W90°43'24.988470000"	-37.182	?	LLh
TE48-SM-01 (COON)	N29°03'14.791141076"	W90°55'59.373941475"	-77.506	0.021	

Adjusted ECEF Coordinates

Point ID	X (US survey foot)	X Error (US survey foot)	Y (US survey foot)	Y Error (US survey foot)	Z (US survey foot)	Z Error (US survey foot)	3D Error (US survey foot)	Constraint
DEV1	-558134.795	?	-18451026.880	?	9822435.345	?	?	LLh
FHS	-476410.906	?	-18166300.619	?	10340063.712	?	?	LLh
GRIS	13616.876	?	-18269305.528	?	10169272.618	?	?	LLh
HOUT	-229986.085	?	-18209490.634	?	10272765.225	?	?	LLh
TE48-SM- 01 (COON)	-298143.393	0.018	-18304318.827	0.021	10102124.223	0.019	0.033	

Error Ellipse Components

	Semi-major axis	Semi-minor axis	
--	-----------------	-----------------	--

Point ID	(US survey foot)	(US survey foot)	Azimuth
TE48-SM-01 (COON)	0.023	0.023	175°

Adjusted GNSS Observations

Transformation Parameters

Deflection in Latitude: -0.023 sec (95%) 0.009 sec
Deflection in Longitude: -0.019 sec (95%) 0.009 sec
Azimuth Rotation: -0.011 sec (95%) 0.005 sec
Scale Factor: 1.00000006 (95%) 0.00000003

Observation ID		Observation	A-posteriori Error	Residual	Standardized Residual
DEV1 --> TE48-SM-01 (COON) (PV1077)	Az.	38°38'31"	0.011 sec	-0.006 sec	-0.390
	ΔHt.	-112.093 ft	0.026 ft	-0.036 ft	-1.162
	Ellip Dist.	409084.731 ft	0.022 ft	0.104 ft	3.383
HOUT --> TE48-SM-01 (COON) (PV1104)	Az.	198°53'36"	0.019 sec	-0.022 sec	-0.724
	ΔHt.	-40.341 ft	0.022 ft	-0.036 ft	-1.146
	Ellip Dist.	206777.018 ft	0.019 ft	-0.103 ft	-3.382
FSHS --> TE48-SM-01 (COON) (PV1079)	Az.	146°18'30"	0.012 sec	-0.060 sec	-3.142
	ΔHt.	-29.965 ft	0.025 ft	-0.027 ft	-0.857
	Ellip Dist.	327790.134 ft	0.020 ft	-0.013 ft	-0.427
GRIS --> TE48-SM-01 (COON) (PV1080)	Az.	256°22'25"	0.013 sec	0.049 sec	2.563
	ΔHt.	-26.202 ft	0.025 ft	-0.027 ft	-0.861
	Ellip Dist.	320830.076 ft	0.020 ft	-0.078 ft	-2.554
FSHS --> TE48-SM-01 (COON) (PV1083)	Az.	146°18'30"	0.012 sec	0.043 sec	2.130
	ΔHt.	-29.965 ft	0.025 ft	0.002 ft	0.020
	Ellip Dist.	327790.134 ft	0.020 ft	0.037 ft	1.101

<u>HOUN --> TE48-SM-01 (COON) (PV1108)</u>	Az.	198°53'36"	0.019 sec	0.014 sec	0.457
	ΔHt.	-40.341 ft	0.022 ft	0.020 ft	0.578
	Ellip Dist.	206777.018 ft	0.019 ft	0.062 ft	2.012
<u>DEV1 --> TE48-SM-01 (COON) (PV1081)</u>	Az.	38°38'31"	0.011 sec	-0.002 sec	-0.103
	ΔHt.	-112.093 ft	0.026 ft	0.013 ft	0.373
	Ellip Dist.	409084.731 ft	0.022 ft	-0.057 ft	-1.843
<u>GRIS --> TE48-SM-01 (COON) (PV1084)</u>	Az.	256°22'25"	0.013 sec	-0.006 sec	-0.275
	ΔHt.	-26.202 ft	0.025 ft	-0.097 ft	-1.492
	Ellip Dist.	320830.076 ft	0.020 ft	0.055 ft	1.619
<u>DEV1 --> TE48-SM-01 (COON) (PV1073)</u>	Az.	38°38'31"	0.011 sec	-0.004 sec	-0.251
	ΔHt.	-112.093 ft	0.026 ft	0.033 ft	1.070
	Ellip Dist.	409084.731 ft	0.022 ft	-0.047 ft	-1.556
<u>FSHS --> TE48-SM-01 (COON) (PV1075)</u>	Az.	146°18'30"	0.012 sec	0.026 sec	1.382
	ΔHt.	-29.965 ft	0.025 ft	0.023 ft	0.682
	Ellip Dist.	327790.134 ft	0.020 ft	0.039 ft	1.263
<u>HOUN --> TE48-SM-01 (COON) (PV1100)</u>	Az.	198°53'36"	0.019 sec	0.013 sec	0.442
	ΔHt.	-40.341 ft	0.022 ft	0.043 ft	1.283
	Ellip Dist.	206777.018 ft	0.019 ft	0.042 ft	1.370
<u>GRIS --> TE48-SM-01 (COON) (PV1076)</u>	Az.	256°22'25"	0.013 sec	-0.016 sec	-0.854
	ΔHt.	-26.202 ft	0.025 ft	0.043 ft	1.204
	Ellip Dist.	320830.076 ft	0.020 ft	0.028 ft	0.914
<u>GRIS --> FSHS (PV1048)</u>	Az.	292°09'28"	0.005 sec	0.012 sec	0.989
	ΔHt.	3.763 ft	0.026 ft	-0.002 ft	-0.081
	Ellip Dist.	529077.530 ft	0.014 ft	0.002 ft	0.054

<u>FSHS --> HOUT (PV1106)</u>	Az.	107°12'30"	0.005 sec	0.022 sec	0.872
	ΔHt.	10.376 ft	0.012 ft	0.014 ft	0.454
	Ellip Dist.	259076.777 ft	0.007 ft	0.019 ft	0.593
<u>FSHS --> HOUT (PV1102)</u>	Az.	107°12'30"	0.005 sec	0.020 sec	0.799
	ΔHt.	10.376 ft	0.012 ft	0.010 ft	0.310
	Ellip Dist.	259076.777 ft	0.007 ft	0.012 ft	0.360
<u>GRIS --> FSHS (PV1046)</u>	Az.	292°09'28"	0.005 sec	0.008 sec	0.691
	ΔHt.	3.763 ft	0.026 ft	0.001 ft	0.033
	Ellip Dist.	529077.530 ft	0.014 ft	0.006 ft	0.181
<u>GRIS --> HOUT (PV1111)</u>	Az.	296°09'21"	0.005 sec	-0.012 sec	-0.484
	ΔHt.	14.139 ft	0.013 ft	0.020 ft	0.642
	Ellip Dist.	271352.683 ft	0.007 ft	-0.012 ft	-0.381
<u>FSHS --> HOUT (PV1110)</u>	Az.	107°12'30"	0.005 sec	0.016 sec	0.618
	ΔHt.	10.376 ft	0.012 ft	0.012 ft	0.262
	Ellip Dist.	259076.777 ft	0.007 ft	0.005 ft	0.143
<u>DEV1 --> FSHS (PV1062)</u>	Az.	7°02'20"	0.005 sec	-0.006 sec	-0.542
	ΔHt.	-82.128 ft	0.024 ft	-0.008 ft	-0.257
	Ellip Dist.	596415.478 ft	0.016 ft	0.018 ft	0.576
<u>DEV1 --> FSHS (PV1070)</u>	Az.	7°02'20"	0.005 sec	-0.006 sec	-0.572
	ΔHt.	-82.128 ft	0.024 ft	-0.006 ft	-0.129
	Ellip Dist.	596415.478 ft	0.016 ft	-0.001 ft	-0.033
<u>GRIS --> DEV1 (PV1067)</u>	Az.	235°37'34"	0.005 sec	-0.001 sec	-0.119
	ΔHt.	85.891 ft	0.024 ft	-0.010 ft	-0.334
	Ellip Dist.	693010.108 ft	0.018 ft	-0.018 ft	-0.565

<u>GRIS --> HOUT (PV1103)</u>	Az.	296°09'21"	0.005 sec	-0.003 sec	-0.117
	ΔHt.	14.139 ft	0.013 ft	0.018 ft	0.558
	Ellip Dist.	271352.683 ft	0.007 ft	-0.003 ft	-0.082
<u>GRIS --> HOUT (PV1107)</u>	Az.	296°09'21"	0.005 sec	0.001 sec	0.024
	ΔHt.	14.139 ft	0.013 ft	0.016 ft	0.542
	Ellip Dist.	271352.683 ft	0.007 ft	-0.011 ft	-0.346
<u>DEV1 --> FSHS (PV1066)</u>	Az.	7°02'20"	0.005 sec	-0.006 sec	-0.521
	ΔHt.	-82.128 ft	0.024 ft	0.000 ft	-0.025
	Ellip Dist.	596415.478 ft	0.016 ft	0.012 ft	0.390
<u>GRIS --> FSHS (PV1050)</u>	Az.	292°09'28"	0.005 sec	0.006 sec	0.441
	ΔHt.	3.763 ft	0.026 ft	0.001 ft	0.020
	Ellip Dist.	529077.530 ft	0.014 ft	-0.005 ft	-0.129
<u>GRIS --> DEV1 (PV1063)</u>	Az.	235°37'34"	0.005 sec	-0.003 sec	-0.323
	ΔHt.	85.891 ft	0.024 ft	0.011 ft	0.365
	Ellip Dist.	693010.108 ft	0.018 ft	-0.005 ft	-0.163
<u>DEV1 --> HOUT (PV1105)</u>	Az.	31°52'43"	0.005 sec	0.001 sec	0.078
	ΔHt.	-71.753 ft	0.021 ft	0.008 ft	0.263
	Ellip Dist.	607325.590 ft	0.016 ft	-0.010 ft	-0.334
<u>GRIS --> DEV1 (PV1071)</u>	Az.	235°37'34"	0.005 sec	-0.002 sec	-0.192
	ΔHt.	85.891 ft	0.024 ft	0.003 ft	0.080
	Ellip Dist.	693010.108 ft	0.018 ft	-0.011 ft	-0.330
<u>DEV1 --> HOUT (PV1101)</u>	Az.	31°52'43"	0.005 sec	-0.003 sec	-0.279
	ΔHt.	-71.753 ft	0.021 ft	-0.006 ft	-0.186
	Ellip Dist.	607325.590 ft	0.016 ft	-0.006 ft	-0.206

DEV1 --> HOUT (PV1109)	Az.	31°52'43"	0.005 sec	-0.002 sec	-0.151
	ΔHt.	-71.753 ft	0.021 ft	-0.001 ft	-0.019
	Ellip Dist.	607325.590 ft	0.016 ft	-0.007 ft	-0.233

Covariance Terms

From Point	To Point		Components	A-posteriori Error	Horiz. Precision (Ratio)	3D Precision (Ratio)
DEV1	HOUT	Az.	31°52'43"	0.000 sec	1 : 0	1 : 0
		ΔHt.	-71.781 ft	0.000 ft		
		ΔElev.	-67.643 ft	0.000 ft		
		Ellip Dist.	607325.627 ft	0.000 ft		
DEV1	TE48-SM-01 (COON)	Az.	38°38'31"	0.009 sec	1 : 22173330	1 : 22173235
		ΔHt.	-112.106 ft	0.021 ft		
		ΔElev.	-111.506 ft	0.021 ft		
		Ellip Dist.	409084.755 ft	0.018 ft		
FHS	DEV1	Az.	187°09'02"	0.000 sec	1 : 0	1 : 0
		ΔHt.	82.188 ft	0.000 ft		
		ΔElev.	75.569 ft	0.000 ft		
		Ellip Dist.	596415.514 ft	0.000 ft		
FHS	HOUT	Az.	107°12'30"	0.000 sec	1 : 0	1 : 0
		ΔHt.	10.407 ft	0.000 ft		
		ΔElev.	7.926 ft	0.000 ft		
		Ellip Dist.	259076.792 ft	0.000 ft		
FHS	TE48-SM-01 (COON)	Az.	146°18'30"	0.011 sec	1 : 17834302	1 : 17834691
		ΔHt.	-29.918 ft	0.021 ft		
		ΔElev.	-35.937 ft	0.021 ft		
		Ellip Dist.	327790.153 ft	0.018 ft		

<u>GRIS</u>	<u>DEV1</u>	Az.	235°37'34"	0.000 sec	1 : 0	1 : 0
		ΔHt.	85.886 ft	0.000 ft		
		ΔElev.	85.619 ft	0.000 ft		
		Ellip Dist.	693010.149 ft	0.000 ft		
<u>GRIS</u>	<u>FSHS</u>	Az.	292°09'28"	0.000 sec	1 : 0	1 : 0
		ΔHt.	3.697 ft	0.000 ft		
		ΔElev.	10.050 ft	0.000 ft		
		Ellip Dist.	529077.562 ft	0.000 ft		
<u>GRIS</u>	<u>HOUN</u>	Az.	296°09'21"	0.000 sec	1 : 0	1 : 0
		ΔHt.	14.104 ft	0.000 ft		
		ΔElev.	17.975 ft	0.000 ft		
		Ellip Dist.	271352.699 ft	0.000 ft		
<u>GRIS</u>	<u>TE48-SM-01 (COON)</u>	Az.	256°22'25"	0.012 sec	1 : 17537869	1 : 17538497
		ΔHt.	-26.220 ft	0.021 ft		
		ΔElev.	-25.887 ft	0.021 ft		
		Ellip Dist.	320830.095 ft	0.018 ft		
<u>TE48-SM-01 (COON)</u>	<u>HOUN</u>	Az.	18°47'26"	0.018 sec	1 : 11220557	1 : 11220848
		ΔHt.	40.325 ft	0.021 ft		
		ΔElev.	43.862 ft	0.021 ft		
		Ellip Dist.	206777.030 ft	0.018 ft		

Date: 3/19/2015 8:18:46 AM	Project: P:\Y- 2015\2015.0072\FieldData\TBC_Files\2015.0072_cp.vce	Trimble Business Center
-------------------------------	---	-------------------------

APPENDIX 8

Loop Closures Report

Project File Data		Coordinate System
Name:	P:\Y- 2015\2015.0072\FieldData\TBC_Files\2015.0072_cp.vce	Name: US State Plane 1983
Size:	1 MB	Datum: NAD 1983 (Conus)
Modified:	3/18/2015 4:01:22 PM (UTC:-5)	Zone: Louisiana South 1702
Time zone:	Central Standard Time	Geoid: GEOID12A (Conus)
Reference number:		Vertical datum: NAVD88 (2011)
Description:		

GNSS Loop Closure Results

Summary

Legs in loop: 3

Number of Loops: 270

Number Passed: 270

Number Failed: 0

	Length (US survey foot)	Δ3D (US survey foot)	ΔHoriz (US survey foot)	ΔVert (US survey foot)	PPM
Pass/Fail Criteria					1
Best		0.002	0.001	0.000	0.002
Worst		0.198	0.190	0.160	0.248
Average Loop	1266188.780	0.068	0.054	0.033	0.063
Standard Error	309838.258	0.096	0.083	0.048	0.069

Date: 3/19/2015
8:14:44 AM

Project: P:\Y-
2015\2015.0072\FieldData\TBC_Files\2015.0072_cp.vce

Trimble Business
Center

APPENDIX 9

Field Notes

2015.0072

TETRA-TECH

RACCOON ISLAND BRACKWATER SURVEY (TG-48)

X COOR SP83 / LA SOUTH 1702 / GEOFID 12A
@ 2²⁵m OPUS 1114 - 1320

- RACCOON ISLAND BW SURVEY

- TRANSECTS OF MARSH CREATION CELL

TRANSECT PTS DESC

20-19 1100-1120

18-17 1121-1144

16-15 1145-1162


14-13 1163-1186

12-11 1187-1211

J. STEVENS, D. FALGOUT, B. ANTILL

2-6-15

26

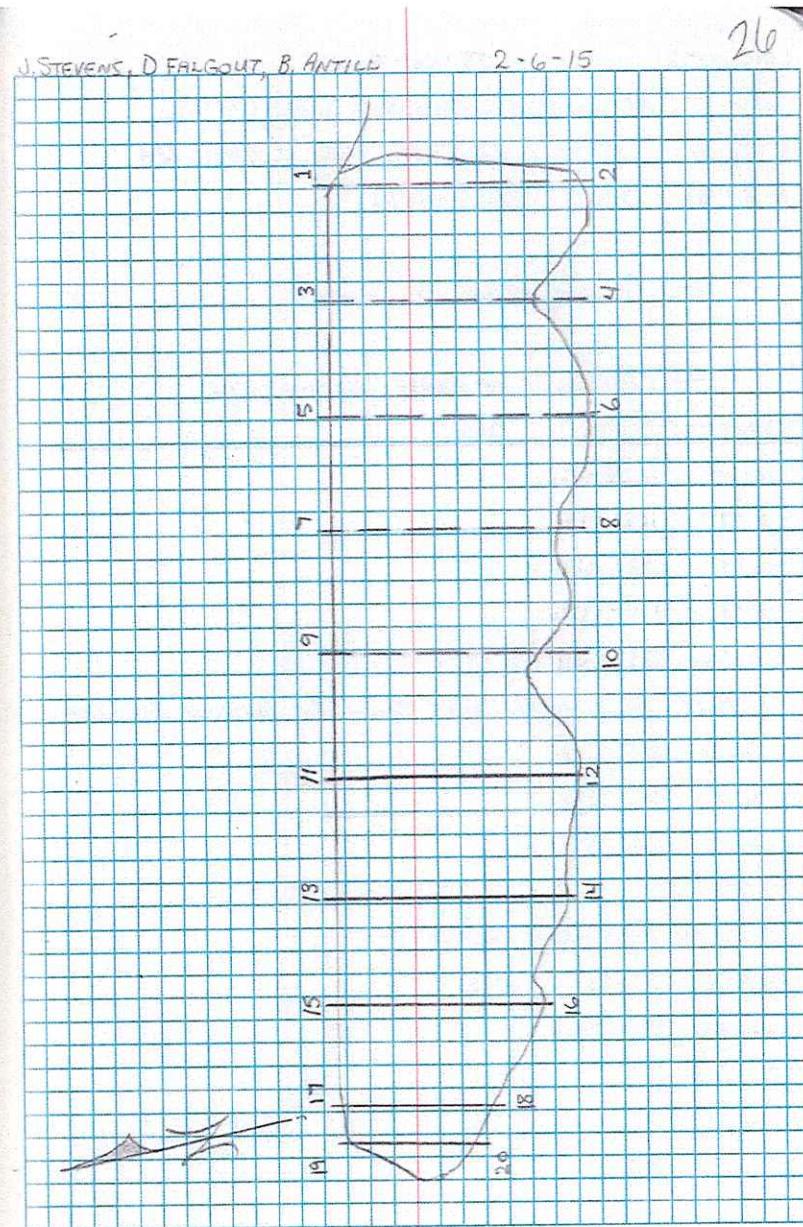

No. 4380

2015.0072

TETRA-TECH

RACCOON ISLAND BAGAWATER SURVEY (TG-48)

X Coon SD83 / LA South 1702 / GEO10 12A
 0 2.25m OPUS 0907 - 1413

— RACCOON ISLAND BIN SURVEY

— TRANSECTS OF MARSH CREATION CELL

TRANSECT	PTS	DESC
10-9	1225-1252	
8-7	1253-1283	
6-5	1284-1310	
4-3	1311-1335	
2-1	1336-1363	

NOTE: ADDITIONAL SHOTS TAKEN FOR PREVIOUS DAY'S TRANSECTS

12-11	1212 - 1224
14-13	1461 - 1466
16-15	1467 - 1475


— ROCK GROIN PROFILE

PROFILE	PTS	DESC
21-22	1364 - 1460	

J. STEVENS, M. PELLERIN, T. FORET

2-10-15

27

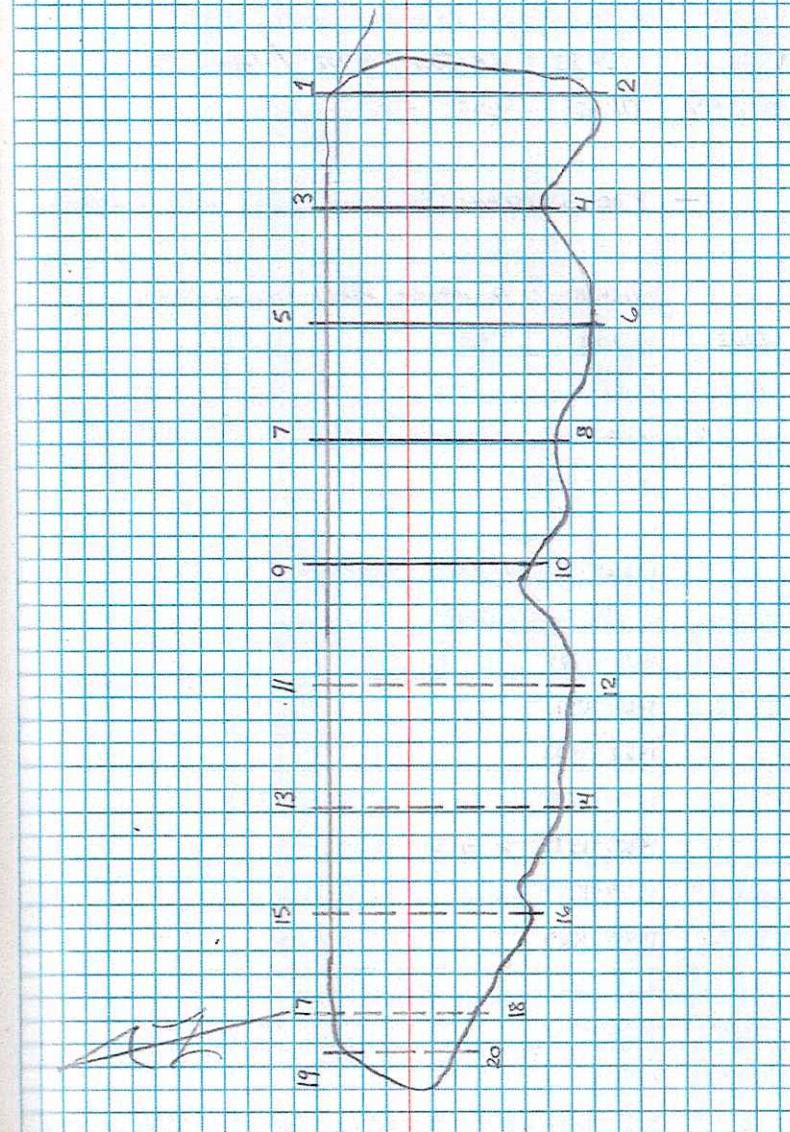

No. 4380

2015.0072

TETRA-TECH

Raccoon Island Breakwater Survey (TR-48)

A Coon SP 83 / LA SOUTH 1702 / Recd 0129
 @ 2.25M OPUS 0756 - 1520

- 3 MM (OBSERVED) SHOTS ON TBM'S AND MONUMENTS

CONE	PT	DESC
1001	• 11001	TERREBONNE PARISH RACCOON ISLAND
1002	• 11002	TBM1
1003	• 11003	TBM3

NOTE: MONUMENT "PELICAN" HAS BEEN DISTURBED; NO SHOT TAKEN


- Rock Grain Cross-Sections

X-SEC	PTS	DESC
23-24	1476-1497	-50' TO FOW
25-26	1498-1521	"
27-28	1522-1543	"
29-30	1544-1564	"
31-32	1565-1578	-50' TO 50' INCOMPLETE
33-34	1579-1589	" INCOMPLETE
35-36	1590-1609	" INCOMPLETE
37-38	1610-1625	"
39-40	1626-1641	"
41-42	1642-1657	"
43-44	1658-1664	ROCKS NEEDS SOUNDINGS; 45-46 IN WATER

J. STEVENS, D. FALGOUT, P. PELLEGRIN

2-11-15

28

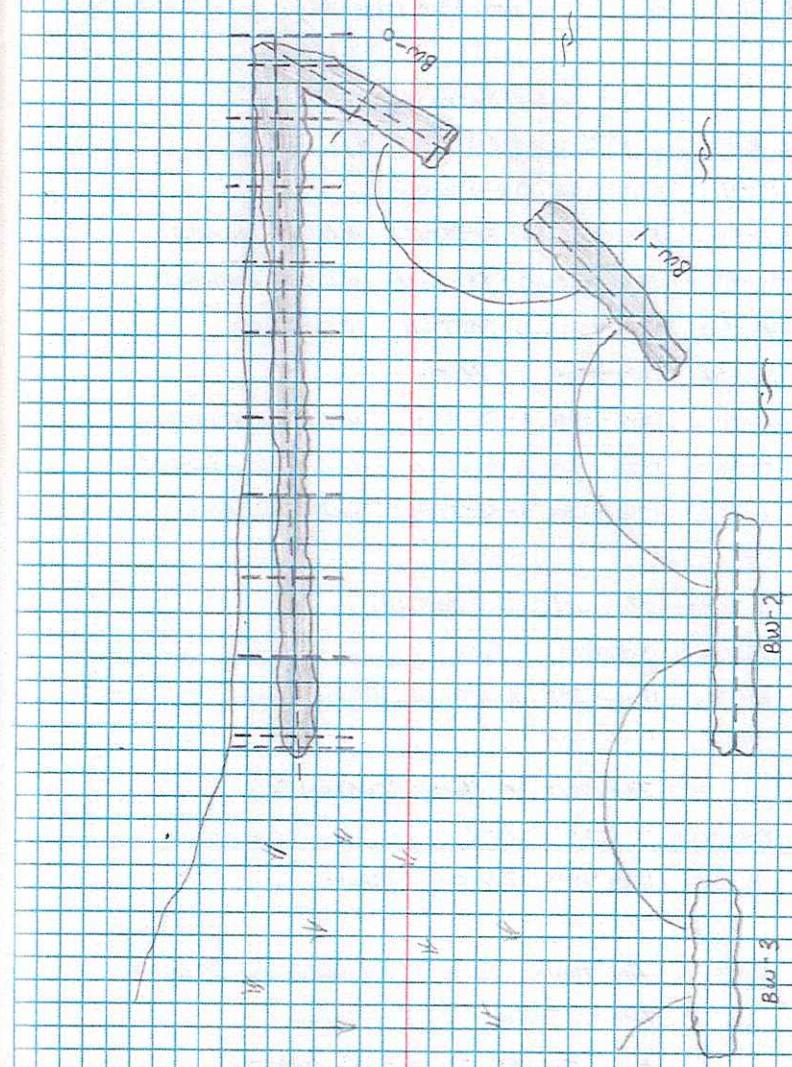

#. 4380

2015.0072

TETRA-TECH

RACCOON ISLAND BREAKWATER SURVEY (TG-18)

T COAN @ 2²⁵ m CONT. FROM PAGE 28

— BREAKWATER SURVEYS

BW	PTS	DESC
47-48	1665-1690	O - PROFILE
53-54	1691-1695	O - SECTION NEEDS SOUNDINGS
51-52	1696-1703	O - SECTION NEEDS SOUNDINGS
49-50	1704	O - SECTION INCOMPLETE
55-56	1747-1805	I - PROFILE
57-58	1705-1724	I - SECTION NEEDS SOUNDINGS
59-60	1725-1739	I - SECTION NEEDS SOUNDINGS
61-62	1740-1746	I - SECTION NEEDS SOUNDINGS

— ROCK GROIN PROFILE

PROFILE	PTS	DESC
21-22	1806-1823	ADDITIONAL PROFILE SHOTS

— TRANSECT OF MARSH CREATION CELL

TRANSECT	PTS	DESC
14-13	1824-1825	ADDITIONAL SHOTS

NOTE: ADDITIONAL SURVEYS PERFORMED ON ISLAND.


AERIAL SURVEY - ERIC DEROCHE

BIRD SPECIES SURVEY - CONTRACTOR

J. STEVENS, D. FAUCOURT, M. PELLEGRIN

2-11-15

29

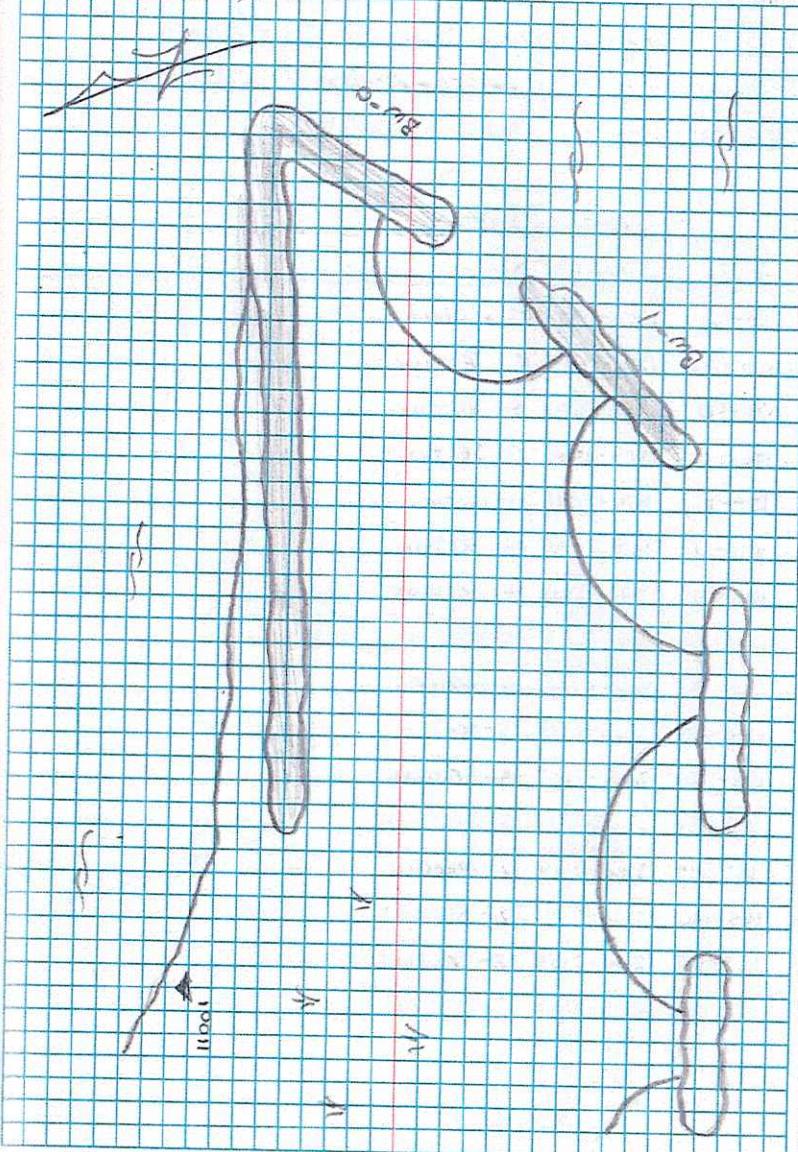

#. 4380

2015.0072

TETRA-TECH

RACCOON ISLAND BREAKWATER SURVEY (TS-42)

I COON SP.83 / LA SOUTH 1702 / GEORGE

02.25M OPUS 0829 - 1340


- BREAKWATER SURVEYS

BW	PTS	DESC
167-168	1826-1878	15 - PROFILE
169-170	1901-1911	15 - SECTION
171-172	1830-1892	15 - SECTION
173-174	1893-1900	15 - SECTION
159-160	1924-1977	14 - PROFILE
161-162	1978-1991	14 - SECTION
163-164	1992-2002	14 - SECTION
165-166	1912-1923	14 - SECTION
2015-2035		
151-152	2048-2062	13 - PROFILE
153-154	2063-2073	13 - SECTION
155-156	2036-2047	13 - SECTION
157-158	2003-2014	13 - SECTION
2032-2095		
143-144	2106-2119	12 - PROFILE
145-146	2120-2129	12 - SECTION
147-148	2096-2105	12 - SECTION
149-150	2074-2081	12 - SECTION

J. STEVENS, D. FALGOUT, M. PELLEGRIN

2-12-15

30

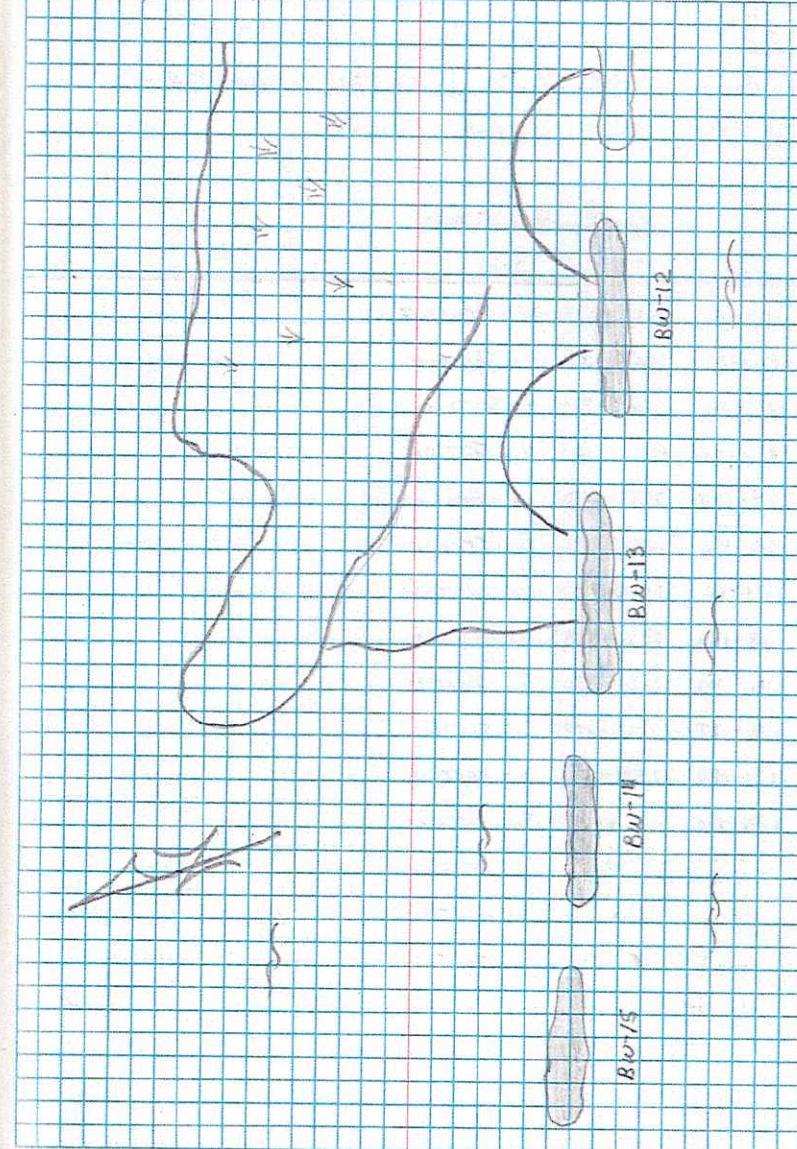

No. 4380

2015.0072

TETRA - TECH

RACCOON ISLAND BREAKWATER SURVEY (TC-48)

T COON SP83 / LA SOUTH 1702 / GEOM 12A

0.225 m OPUS 0844 - 1248

- BREAKWATER SURVEY

Bu PTS DESC

135-136 2142-2190 II - PROFILE

137-138 2191-2206 II - SECTION

139-140 2207-2219 II - SECTION

141-142 2131-2141 II - SECTION

127-128 2233-2284 I0 - PROFILE

129-130 2285-2297 I0 - SECTION

131-132 2298-2309 I0 - SECTION

133-134 2220-2232 I0 - SECTION

119-120 2320-2366 9 - PROFILE

121-122 2367-2380 9 - SECTION


123-124 2381-2393 9 - SECTION

125-126 2310-2319 9 - SECTION

J. STEVENS, J. DUPRE, A. ANSAROV

2-13-15

31

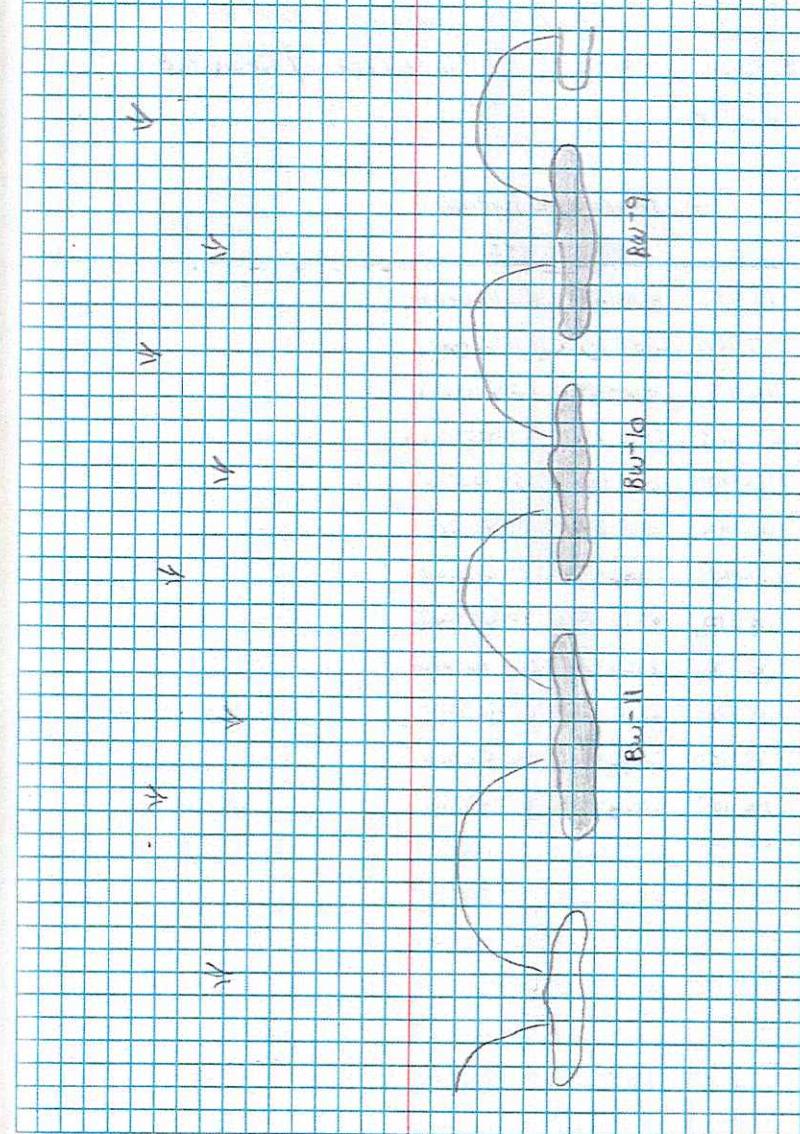

No. 4380

2015.0072

TETRA-TECH

RACCOON ISLAND BREAKWATER SURVEY (PG-48)

T COON

SP83 / LA SOUTH 1702 / GEOM 12A

02.25m


- BREAKWATER SURVEYS

BW	PTS	DESC
111-112	2408-2448	8 - PROFILE
113-114	2449-2459	8 - SECTION
115-116	2460-2471	8 - SECTION
117-118	2395-2407	8 - SECTION
103-104	2487-2517	7 - PROFILE
105-106	2518-2529	7 - SECTION
107-108	2530-2544	7 - SECTION
109-110	2472-2486	7 - SECTION
95-96	2557-2589	6 - PROFILE
97-98	2590-2601	6 - SECTION
99-100	2602-2615	6 - SECTION
101-102	2545-2556	6 - SECTION
87-88	2627-2659	5 - PROFILE
89-90	2660-2670	5 - SECTION
91-92	2671-2682	5 - SECTION
93-94	2616-2626	5 - SECTION
79-80	2689-2713	4 - PROFILE
83-84	2714-2725	4 - SECTION
85-86	2683-2688	4 - SECTION

J. STEVENS, J. DURRIG, A. ANSAROII

2-19-15

32

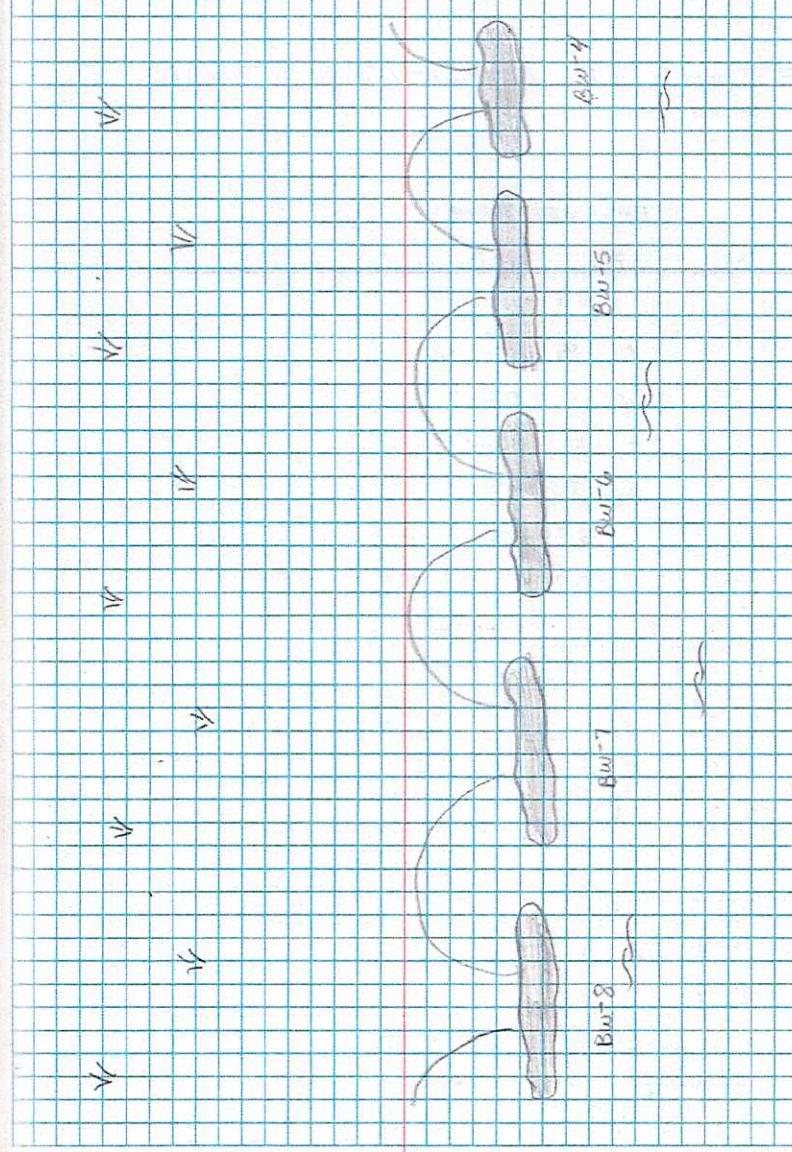

No. 4380

2013.0072

TETRA - TECH

RACCOON ISLAND BREAKWATER SURVEY (76-48)

T Coor @ 2.25m

PTS	STA	SOD	PTS	STA	SOD
1893-174	0+10	2.9	2002-163	0+10	3.2
	0+20	3.3		0+20	3.7
	0+30	2.8		0+30	4.8
1900-173	0+10	5.0		0+40	5.3
	0+20	5.8	1978-161	0+10	3.0
	0+30	7.2		0+20	3.5
	0+40	7.8		0+30	4.5
1892-171	0+10	4.5		0+40	5.3
	0+20	5.3	2014-157	0+10	3.5
	0+30	6.2		0+20	4.1
	0+40	6.5		0+30	5.1
1911-170	0+10	3.1		0+40	5.5
	0+20	2.9	2036-155	0+10	3.1
	0+30	2.9		0+20	4.5
1931-169	0+10	5.0		0+30	5.1
	0+20	5.5		0+40	5.3
	0+30	5.8	2043-153	0+10	3.1
	0+33	5.8		0+20	3.5
1923-165	0+10	4.2		0+30	4.8
	0+20	5.0		0+34	5.0
	0+30	6.1			
	0+37	6.3			

J. STEVENS, D. FAUGUET, M. PELLEGRIN

2-12-15

34

AM TIDE 0.27

PM TIDE 0.86

4	0.86'
	PM TIDE
0.27	
AM TIDE	0
-1	

No. 4380

2015_0072

TETRA - TECH

RACCOON ISLAND BREAKWATER SURVEY (TE-48)


T Coon @ 2.25 m

PTS	STA	SND	PTS	STA	SND
2081-149	0+10	3.9	2191-131	0+10	2.5
	0+20	4.5		0+20	3.5
	0+30	5.1		0+30	4.9
	0+40	5.8		0+33	5.0
2096-147	0+10	2.9	2232-133	0+10	3.0
	0+20	4.2		0+20	4.3
	0+30	5.2		0+30	5.5
	0+35	5.5		0+36	5.8
2120-145	0+10	3.0	2298-131	0+10	3.0
	0+20	4.1		0+20	4.2
	0+30	6.5		0+30	5.0
	0+40	6.8		0+10	4.9
2141-141	0+10	2.2	2285-129	0+20	5.0
	0+20	4.3		0+30	5.4
	0+30	5.2		0+35	5.9
	0+40	5.8		0+10	4.5
2219-139	0+10	2.0	2319-125	0+20	6.0
	0+20	4.5		0+30	6.5
	0+30	5.5		0+40	7.1
	0+35	5.9		0+43	7.2

J. Stevens, D. Falgout, M. Belgrin

2-12-15

35

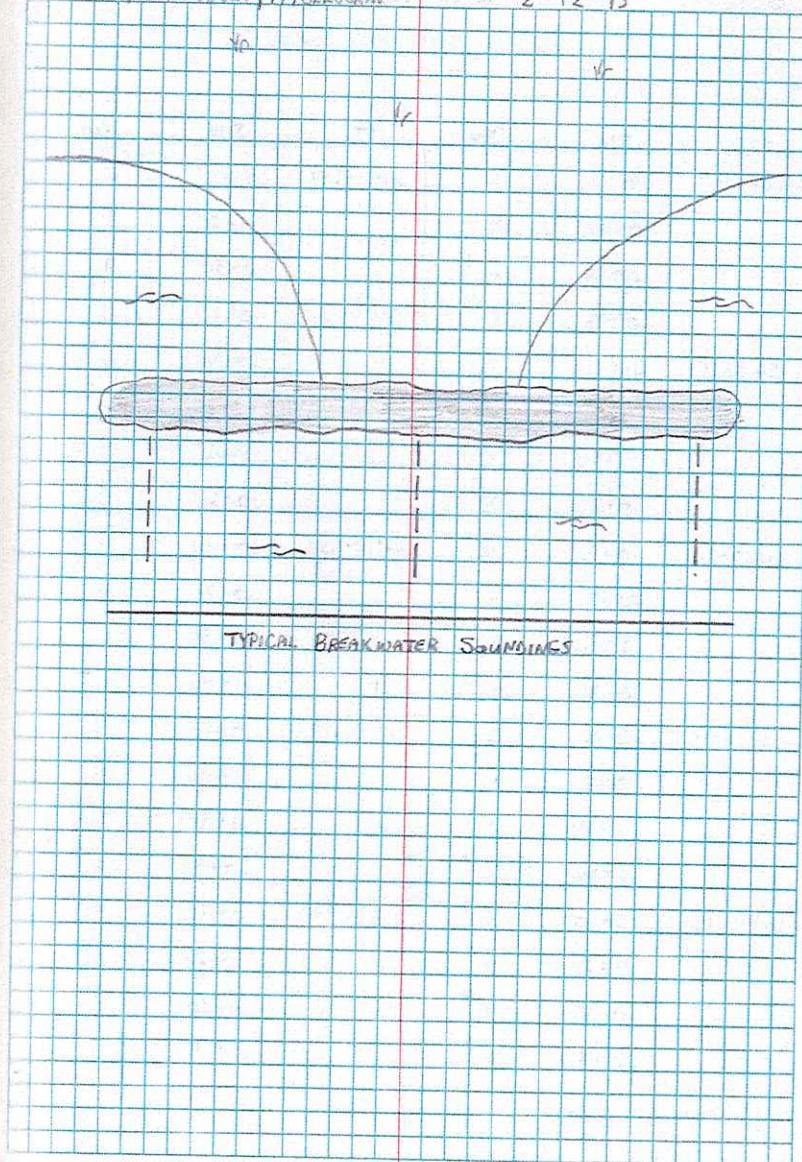

No. 4380

2015.0072

TETRA-TECH

RACCOON ISLAND BREAKWATER SURVEY (TB-48)

IT Coor @ 2.25m


PTS	STA	SND	PTS	STA	SND
2393-123	0+10	3. ⁵	2426-109	0+10	4. ⁷
	0+20	4. ⁵		0+20	5. ⁸
	0+30	6. ⁰		0+30	7. ⁰
	0+34	6. ³	2544-107	0+10	3. ⁸
2367-121	0+10	3. ⁰		0+20	5. ⁴
	0+20	4. ⁵		0+25	6. ²
	0+30	5. ⁵	2527-2529	0+10	3. ⁶
	0+33	5. ⁶		0+20	3. ²
2407-117	0+10	3. ⁰	2518-105	0+10	4. ²
	0+20	4. ⁹		0+20	5. ³
	0+30	5. ⁷		0+30	6. ⁰
	0+32	6. ⁰		0+33	6. ²
2471-115	0+10	2. ⁹	2556-101	0+10	3. ⁸
	0+20	4. ⁷		0+20	5. ¹
	0+30	5. ⁹		0+30	5. ⁹
	0+34	6. ¹		0+33	6. ¹
2449-113	0+10	3. ¹	2615-99	0+10	4. ⁰
	0+20	4. ²		0+20	5. ²
	0+30	5. ⁹		0+30	4. ⁹
	0+32	6. ⁰		0+34	5. ¹

J. STEVENS, D. FALGOUT, M. PELLEGRIN

2-12-15

360

PTS	STA	SND
2590-97	0+10	3. ⁸
	0+20	5. ³
	0+30	5. ⁸
	0+40	6. ³
	0+42	6. ⁵

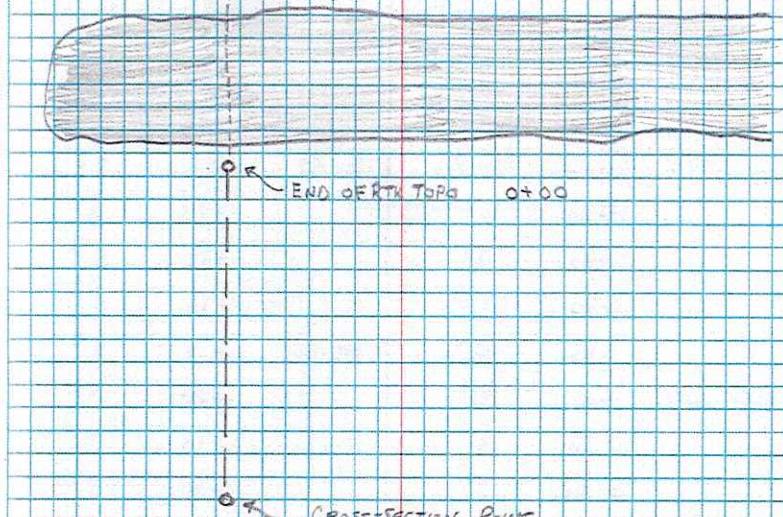

№. 4380

2015.0072

TETRA - TECH

RACCOON ISLAND BREAKWATER SURVEY (TE-48)

T COON @ 2.25m

PTS	STA	SND	PTS	STA	SND
2626-93	0+10	2.0	2714-83	0+10	3.8
	0+20	2.8		0+20	4.8
	0+30	4.5		0+30	5.3
	0+40	4.9		0+39	5.6
2682-91	0+10	2.0	2798-69	0+10	3.6
	0+20	3.2		0+20	3.8
	0+30	4.3		0+30	5.2
	0+36	4.7		0+32	5.3
2660-89	0+10	2.0	2776-67	0+10	2.8
	0+20	2.8		0+20	3.9
	0+30	4.0		0+30	5.0
	0+40	4.7		0+36	5.4
2684-2683	0+10	3.2	2775-66	0+10	3.7
	0+20	3.8		0+20	3.4
	0+30	3.3		0+30	3.3
	0+40	3.3		0+34	2.9
2688-85	0+10	4.0	2769-65	0+10	3.0
	0+20	4.7		0+20	3.8
	0+30	5.3		0+30	5.7
	0+40	5.6		0+35	5.9
	0+41	5.6			


J. STEVENS, J. DURR, A. ANSARI

2-19-15

37

AM TIDE -0.17'

PM TIDE 0.55'

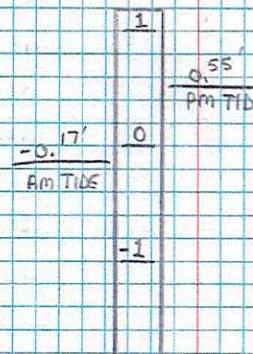

No. 4380

2015.0072

TETRA-TECH

RACCOON ISLAND BREAKWATER SURVEY (TE-48)


T COON @ 2.²⁵ M

PTS	STM	SND	PTS	STM	SND
1740-62	0+10	3. ¹	1691-53	0+10	4. ⁶
	0+20	3. ²		0+20	4. ⁶
	0+30	2. ⁶		0+30	5. ²
	0+40	1. ⁹		0+39	5. ⁸
	0+44	1. ⁷	1690-51	0+10	4. ⁵
1746-61	0+10	3. ⁷		0+20	4. ⁵
	0+20	4. ⁰		0+30	5. ³
	0+30	5. ¹		0+40	5. ⁷
	0+39	5. ⁵		0+45	6. ⁰
1725-59	0+10	3. ⁷	1455-1704	0+13	3. ³
	0+20	3. ⁷		0+20	3. ⁵
	0+30	5. ⁰		0+28	3. ²
	0+36	5. ³	1649-49	0+15	3. ¹
1724-57	0+10	3. ⁵		0+20	4. ⁴
	0+20	3. ⁷		0+30	4. ⁸
	0+30	5. ¹		0+40	6. ⁸
	0+33	5. ²		0+50	7. ⁰
1695-54	0+10	3. ³			
	0+20	3. ³			
	0+30	2. ²			
	0+35	1. ⁷			

J. STEVENS, J. DUPRE, A. ANSUSSI

2-19-15

38

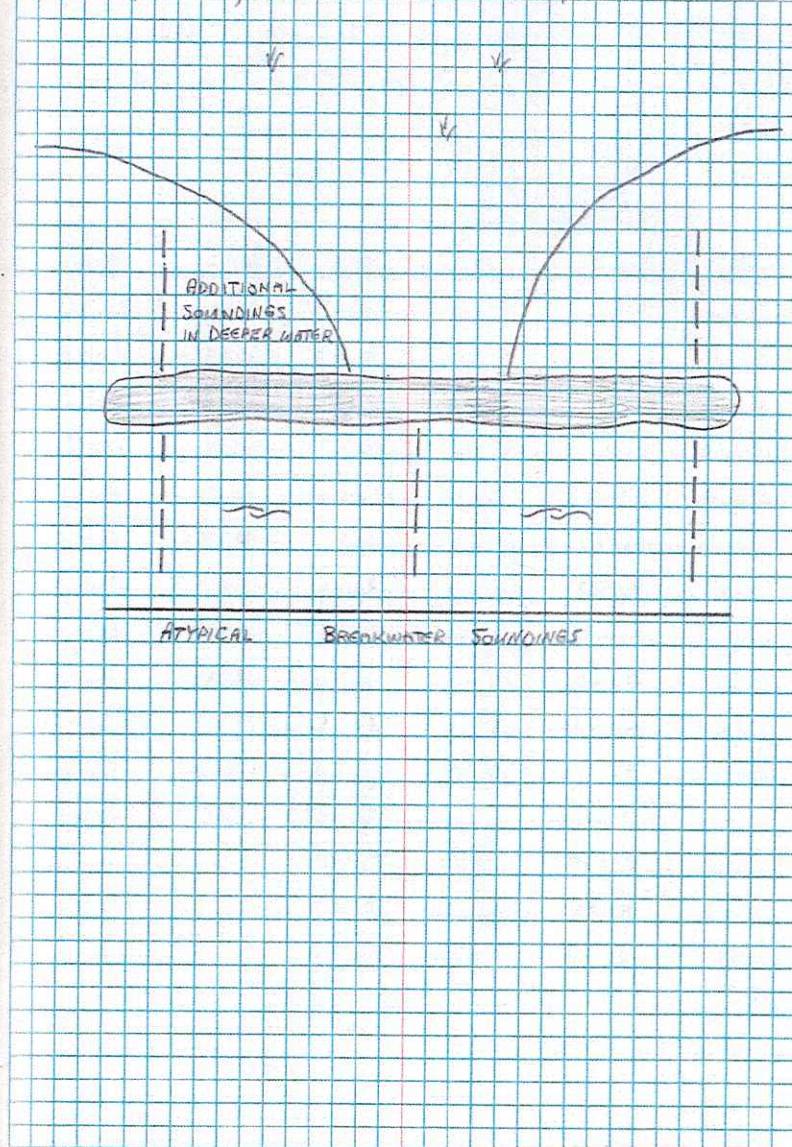

No. 4380

2015.0072

TETRA-TECH

RACCOON KEY AND BREAKWATER SURVEY (FG-48)

TCOON SP83 / LA SOUTH 1702 / GEOD 12A

@ 2.25m


- SETTLEMENT PIPES

PT	DESC	PT	DESC	PT	DESC
12000	BW-15	12015	BW-8	12030	BW-3
12001	BW-15	12016	BW-7	12031	BW-2
12002	BW-14	12017	BW-7	12032	BW-2
12003	BW-14	12018	BW-7	12033	BW-2
12004	BW-13	12019	BW-6	12034	BW-1
12005	BW-13	12020	BW-6	12035	BW-1
12006	BW-12	12021	BW-6	12036	BW-1
12007	BW-12	12022	BW-5	12037	BW-0
12008	BW-11	12023	BW-5	12038	BW-0
12009	BW-11	12024	BW-5	12039	P/BW-0
12010	BW-10	12025	BW-4	12040	PROFILE
12011	BW-10	12026	BW-4	12041	PROFILE
12012	BW-9	12027	BW-4		
12013	BW-9	12028	BW-3		
12014	BW-8	12029	BW-3		

J. STEVENS, A. FUSARO, C. KARLOCK

2-26-15

39

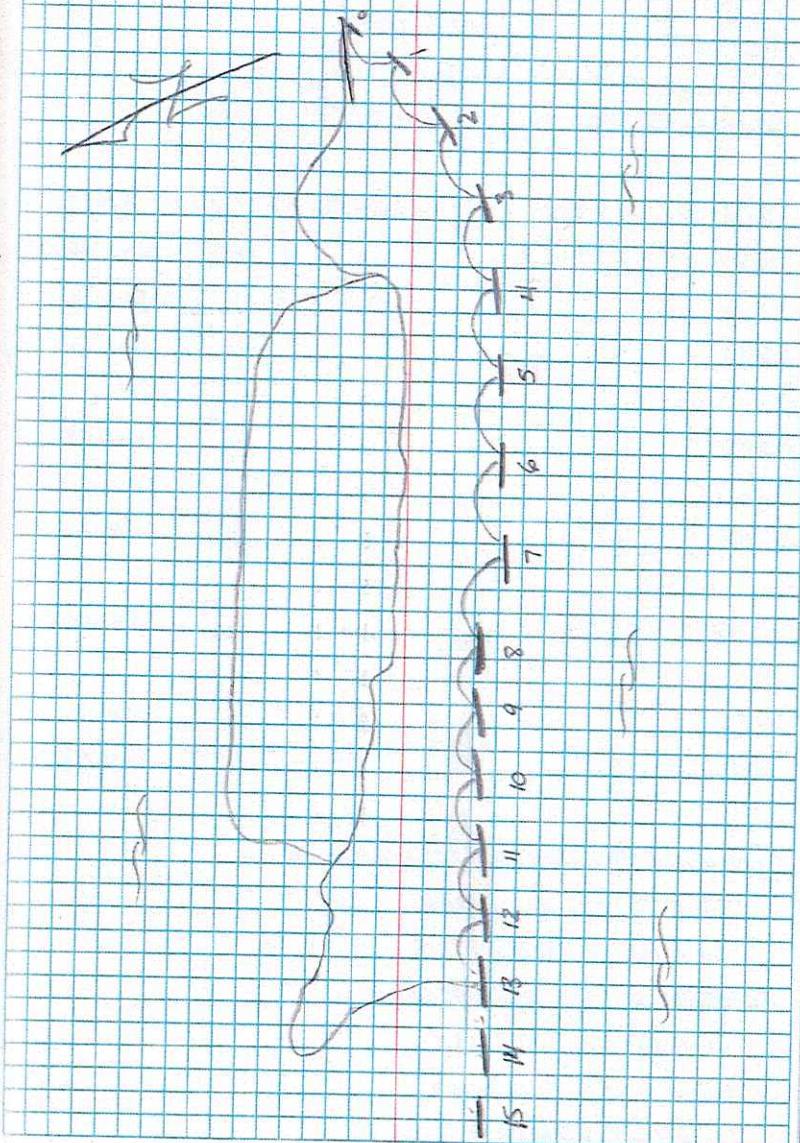

#. 4380

2015-0072

TETRA-TECH

RACCOON ISLAND BREAKWATER SURVEY (TG-48)

T COON

SP 83 / LA SOUTH 1702 / GEOFID 12A

@ 2.25 m

	PTS	STA	STA	PTS	STA	STA
2729-81	0+10	5.5		10	0. ⁶	
	0+20	5.8		20	(-0.9) [↑]	
	0+30	6. ⁴		30	0. ²	
	0+36	6. ⁷		40	-1. ¹	
2732-82	0+10	2.4		1+50	-0. ⁴	
	0+20	2. ²		60	-0. ³	
	0+30	3. ⁷		70	-1. ³	
	0+40	3. ⁵		80	-1. ¹	
	0+49	2.8		90	-0. ⁸	
71-72	0+00	5. ²		2+00	-0. ⁶	
	10	2.7		10	-0. ⁴	
	20	(-0.8) [↑]		20	0. ²	
	30	0. ³		30	0. ³	
	40	1. ²		40	0. ⁰	
	0+50	0. ³		2+50	0. ⁹	
	60	0. ⁷		60	1. ³	
	70	0. ⁶		2+70	3. ⁹	
	80	1. ²		2+74	4. ³	
	90	0. ⁹				
	1+00	1. ⁴				


J. SIEGELS, A. ANASTASOI, C. KNOBLOCH

2-26-15

48

PM TIDE 1005

TIDE EL 100'

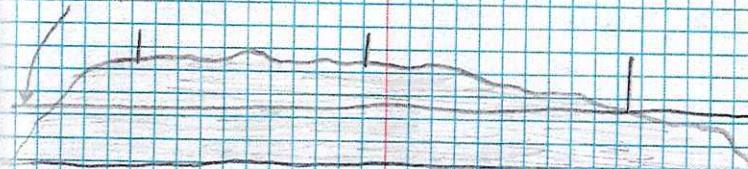

BUJ-4

EAST END SHALLOWED

No. 4380

2015.0072

TETRA-TECH

RACCOON ISLAND BREAKWATER SURVEY (TE-48)

T COON @ 2.²⁵ m

PTS	STA	SND	PTS	STA	SND
73-74	0+00	5.5	77-78	0+00	5.5
	10	5.7		10	5.8
	20	5.5		20	5.0
	30	2.9		30	3.2
	40	1.0		40	1.1
	50	(-0.3)		50	1.2
	60	2.0		60	1.5
	70	2.6		70	2.1
	80	3.4		80	3.6
	90	3.4		90	3.3
	1+00	3.3		1+00	3.0
75-76	0+00	5.6	1664-44	0+10	3.0
	10	5.8		0+20	3.7
	20	5.5		0+23	4.2
	30	2.8	1658-43	0+10	3.2
	40	1.1		0+20	3.5
	50	0.0		0+30	4.2
	60	0.8		0+34	4.4
	70	2.0	2799-46	0+10	3.1
	80	3.0		0+20	3.7
	90	2.8		0+30	3.9
	1+00	2.8		0+38	4.6

J. STEVENS, A. ANSARI, C. KNOBLOCK


2-26-15

49

PTS	STA	SND
2806-45	0+10	4.0
	0+20	4.3
	0+26	4.6

NOTES: BREAKWATER SET "3" SUBMERGED BELOW WATER
SOUNDINGS TAKEN AS SAFEST METHOD

TIDE ET 1.00

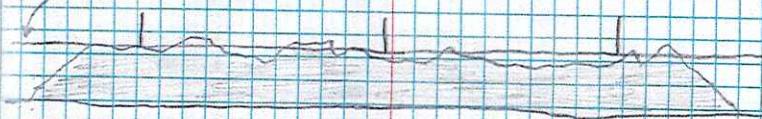

BW-3

SUBMERGED

No. 4380

2015.0072

TETRA-TECH

RACCOON ISLAND BW SURVEY

- EXPOSED MONUMENT FOR PICTURES AND LEVEL SURVEY
• APPROX 1.5' BELOW NATURAL GROUND

+ H1	-	ELEV	DESC
4 46		1.488	COON T648-SM-01
5 948		3.19	2.758 NG
		4.31	1.638 TBM
4 03		1.638	TBM
5 668		2.90	2.768 NG
		4.18	1.488 COON T648-SM-01

J. SPARNS, F. LITTLE, T. RAMIREZ

3-23-15

7

(TBM)

115

10

(COON)


W

~~X~~

4520

INDEX TO SHEETS

SHEET NO.	DESCRIPTION
1	OVERALL PLAN EXHIBIT
2	SETTLEMENT PLATES/ TRANSECTS
3 - 6	MARSH CREATION TRANSECTS
7 - 9	EAST GROIN TRANSECTS
10 - 17	BREAKWATER TRANSECTS
18	EAST GROIN PROFILE
19-22	BREAKWATER PROFILES

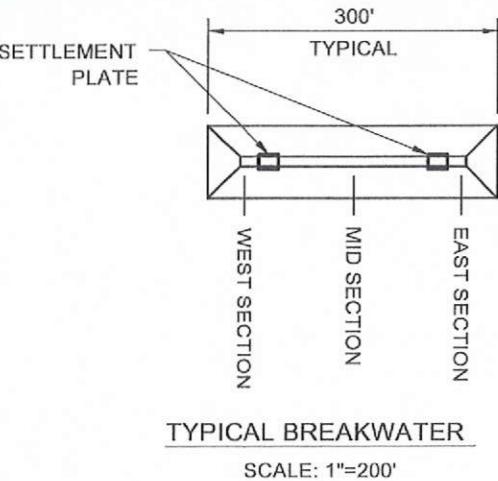BENCHMARKS


POINT #	NAME	EASTING	NORTHING	ELEVATION
1000	TE48-SM-01 (COON)	3408702.132	201740.532	1.488
1001	Terrebonne Parish Raccoon Island	3413654.95	200280.37	3.92
1002	TBM1	3408686.56	201752.34	2.70
1003	TBM3	3413913.75	199873.62	4.04

LEGEND


- TE-29 BREAKWATERS (1996)
- TE-48A BREAKWATERS (2005)
- TE-48B MARSH CREATION (2012)
- MARSH CREATION TRANSECTS
- BREAKWATER & EAST GROIN TRANSECTS

SURVEY NOTES:

1. SURVEY PERFORMED FEBRUARY 2015 BY T. BAKER SMITH, L.L.C.
2. ALL HORIZONTAL POSITIONS ARE EXPRESSED IN LOUISIANA STATE PLANE, SOUTH ZONE, NAD83, IN U.S. SURVEY FEET. ELEVATIONS ARE NAVD88 (GEOID12A), IN U.S. SURVEY FEET.
3. THE REFERENCE BENCHMARK FOR THIS SURVEY IS TE48-SM-01 (COON).
4. BACKGROUND IMAGERY REPRODUCED FROM 2013 DOQQ AERIAL PHOTOGRAPHY ACQUIRED FROM THE NAIP.

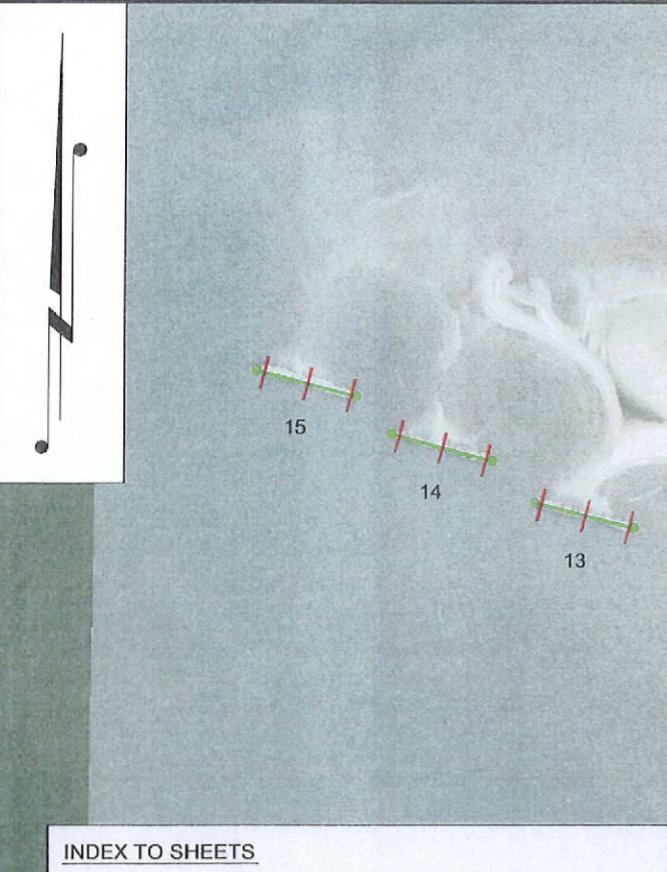

TE48-SM-01 (COON)
ELEV. = 1.488'
X = 3,408,702.132' NAD 83
Y = 201,740.532' NAD 83
LAT = N 29° 3' 14.79" LONG = W 90° 55' 59.37"

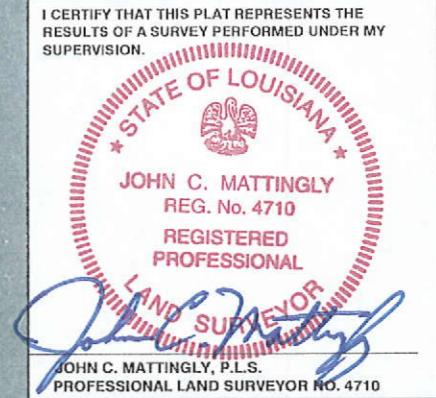

0+00 1+00 2+00 3+00 4+00 5+00 6+00 7+00 8+00 9+26
EAST GROIN

TBM 3
1
2
3
4
5
6
7
8
9
0


MARSH CREATION ALIGNMENT		
STATION	EASTING	NORTHING
0+00	3,412,971.99	200,654.88
41+71	3,408,994.42	201,911.79

EAST GROIN ALIGNMENT		
STATION	EASTING	NORTHING
0+00	3,413,824.21	200,146.79
9+26	3,414,749.99	200,146.79

NOTES:



T. BAKER SMITH
SOLUTIONS START HERE
410 South Van Ave., Houma, LA 70363
(985)868-1050 | tbsurvey.com

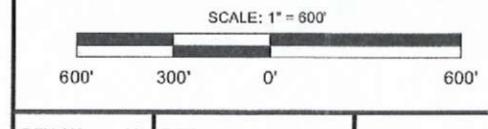


REV. NO: 00 REV. DATE: --- REV. BY: ---

REVISION DESCRIPTION: --

DRAWN BY: JMC APPROVED BY: JCM
DATE: 5/5/2015 JOB NO: 2015.0072
DRAWING NAME: 1-2 OVERALL PLAN EXHIBIT.DWG
PROJECTION: LA83-SF-MOD
GEO. DATUM: NAD83 | VERT. DATUM: NAVD88
GRID UNITS: US SURVEY FEET
SHEET NO: 1 OF 22

OVERALL PLAN EXHIBIT
COASTAL PROTECTION AND RESTORATION AUTHORITY
TETRA TECH, INC.
RACCOON ISLAND SHORELINE PROTECTION/
MARSH CREATION (TE-48) PROJECT
BREAKWATER SURVEY
TERREBONNE PARISH, LOUISIANA

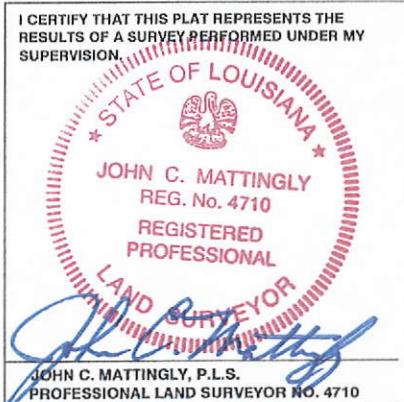

NOTES:



TBS

T. BAKER SMITH
SOLUTIONS START HERE
112 South Van Aken, Thibodaux, LA 70363
(985)868-1050 • tsmith@tbs.com

REV. NO: 00	REV. DATE: -/-/-	REV. BY: ---
REVISION DESCRIPTION: --		

DRAWN BY: JMC	APPROVED BY: JCM
DATE: 5/5/2015	JOB NO: 2015.0072
DRAWING NAME: 1-2 OVERALL PLAN EXHIBIT.DWG	
PROJECTION: LA83-SF-MOD	
GEO. DATUM: NAD83 VERT. DATUM: NAVD88	
GRID UNITS: US SURVEY FEET	
SHEET NO: 2 OF 22	




SETTLEMENT PLATES					
Point #	EASTING	NORTHING	ELEVATION	DESCRIPTION	LOCATION
12000	3406935.26	201745.17	8.28	PIPE	BW 15 WEST
12001	3407026.48	201695.64	8.34	PIPE	BW 15 EAST
12002	3407255.22	201544.78	8.07	PIPE	BW 14 WEST
12003	3407453.07	201492.38	8.05	PIPE	BW 14 EAST
12004	3407696.69	201533.49	7.36	PIPE	BW 13 WEST
12005	3407890.37	201284.70	6.92	PIPE	BW 13 EAST
12006	3408152.91	201101.65	6.87	PIPE	BW 12 WEST
12007	3408345.16	201051.00	8.25	PIPE	BW 12 EAST
12008	3408645.70	200929.41	5.26	PIPE BENT	BW 11 WEST
12009	3408896.27	200877.57	8.53	PIPE	BW 11 EAST
12010	3409154.67	200732.98	7.95	PIPE	BW 10 WEST
12011	3409344.97	200683.18	8.42	PIPE	BW 10 EAST
12012	3409679.50	200517.15	7.82	PIPE	BW 9 WEST
12013	3409872.02	200484.13	8.06	PIPE	BW 9 EAST
12014	3410211.49	200296.62	9.41	PIPE	BW 8 WEST
12015	3410407.43	200252.90	10.08	PIPE	BW 8 EAST
12016	3410757.86	199949.15	6.42	PIPE	BW 7 WEST
12017	3410852.71	199920.46	6.80	PIPE	BW 7 MID
12018	3410949.16	199894.96	7.02	PIPE	BW 7 EAST
12019	3411340.13	199784.37	6.18	PIPE	BW 6 WEST
12020	3411436.62	199756.92	6.45	PIPE	BW 6 MID
12021	3411530.79	199731.31	6.23	PIPE BENT	BW 6 EAST
12022	3411916.23	199621.94	6.37	PIPE	BW 5 WEST
12023	3412013.11	199599.73	7.06	PIPE	BW 5 MID
12024	3412109.00	199565.50	5.70	PIPE	BW 5 EAST
12025	3412504.39	199460.02	3.75	PIPE	BW 4 WEST
12026	3412600.60	199435.89	5.34	PIPE	BW 4 MID
12027	3412698.69	199410.99	3.23	PIPE	BW 4 EAST
12028	3413119.92	199385.42	2.73	PIPE BENT	BW 3 WEST
12029	3413220.20	199379.66	4.06	PIPE	BW 3 MID
12030	3413518.24	199382.30	2.64	PIPE	BW 3 EAST
12031	3413720.09	199450.19	5.17	PIPE	BW 2 WEST
12032	3413616.90	199464.71	5.16	PIPE	BW 2 MID
12033	3413915.75	199480.73	5.33	PIPE	BW 2 EAST
12034	3414270.79	198710.18	4.36	PIPE BENT	BW 1 WEST
12035	3414344.35	199774.60	5.32	PIPE	BW 1 MID
12036	3414418.05	199841.53	5.03	PIPE	BW 1 EAST
12037	3414604.46	200011.68	7.24	PIPE	BW 0 WEST
12038	3414676.48	200078.96	4.65	PIPE	BW 0 MID
12039	3414749.57	200146.72	5.18	PIPE	GROIN/ BW DJOINT
12040	3414908.71	200147.06	5.77	PIPE	GROIN EAST
12041	3414125.47	200146.26	6.41	PIPE	GROIN WEST

MARSH CREATION TRANSECT ENDPOINTS					
POINT #	EASTING	NORTHING	DESCRIPTION		
1	3,412,971.99	200,654.88	MC 0+00 BEG		
2	3,412,788.16	200,073.15	MC 0+00 END		
3	3,412,495.23	200,805.54	MC 5+00 BEG		
4	3,412,327.42	200,274.51	MC 5+00 END		
5	3,412,018.46	200,956.19	MC 10+00 BEG		
6	3,411,806.55	200,285.56	MC 10+00 END		
7	3,411,541.70	201,106.85	MC 15+00 BEG		
8	3,411,359.69	200,530.87	MC 15+00 END		
9	3,411,064.94	201,257.51	MC 20+00 BEG		
10	3,410,908.60	200,762.77	MC 20+00 END		
11	3,410,588.18	201,408.16	MC 25+00 BEG		
12	3,410,384.86	200,764.77	MC 25+00 END		
13	3,410,111.41	201,558.82	MC 30+00 BEG		
14	3,409,946.07	201,035.58	MC 30+00 END		
15	3,409,634.65	201,709.48	MC 35+00 BEG		
16	3,409,496.52	201,272.33	MC 35+00 END		
17	3,409,157.89	201,860.13	MC 40+00 BEG		
18	3,409,051.14	201,522.32	MC 40+00 END		
19	3,408,994.42	201,911.79	MC 41+87 BEG		
20	3,408,905.43	201,630.19	MC 41+87 END		

EAST GROIN TRANSECT ENDPOINTS					
POINT #	EASTING	NORTHING	DESCRIPTION		
21	3,413,824.21	200,146.79	GROIN PROFILE BEG		
22	3,414,749.99	200,146.79	GROIN PROFILE END		
23	3,413,824.21	200,236.70	GROIN 0+00 BEG		
24	3,413,824.21	200,096.79	GROIN 0+00 END		
25	3,413,832.21	200,234.71	GROIN 0+08 BEG		
26	3,413,832.21	200,096.79	GROIN 0+08 END		
27	3,413,934.21	200,257.92	GROIN 1+10 BEG		
28	3,413,934.21	200,096.79	GROIN 1+10 END		
29	3,414,024.21	200,228.17	GROIN 2+00 BEG		
30	3,414,024.21	200,096.79	GROIN 2+00 END		
31	3,414,126.21	200,223.13	GROIN 3+02 BEG		
32	3,414,126.21	200,096.79	GROIN 3+02 END		
33	3,414,230.21	200,254.10	GROIN 4+06 BEG		
34	3,414,230.21	200,096.79	GROIN 4+06 END		
35	3,414,324.21	200,249.57	GROIN 5+00 BEG		
36	3,414,324.21	200,096.79	GROIN 5+00 END		
37	3,414,428.21	200,217.62	GROIN 6+04 BEG		
38	3,414,428.21	200,096.79	GROIN 6+04 END		
39	3,414,527.21	200,196.79	GROIN 7+03 BEG		
40	3,414,527.21	200,096.79	GROIN 7+03 END		
41	3,414,632.21	200,196.79	GROIN 8+08 BEG		
42	3,414,632.21	200,096.79	GROIN 8+08 END		
43	3,414,729.21	200,196.79	GROIN 9+05 BEG		
44	3,414,729.21	200,096.79	GROIN 9+05 END		
45	3,414,750.21	200,196.79	GROIN 9+26 BEG		
46	3,414,750.21	200,096.79	GROIN 9+26 END		

NOTE: ALL PROFILES
SHOWN LOOKING WEST

ALIGNMENT

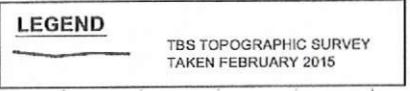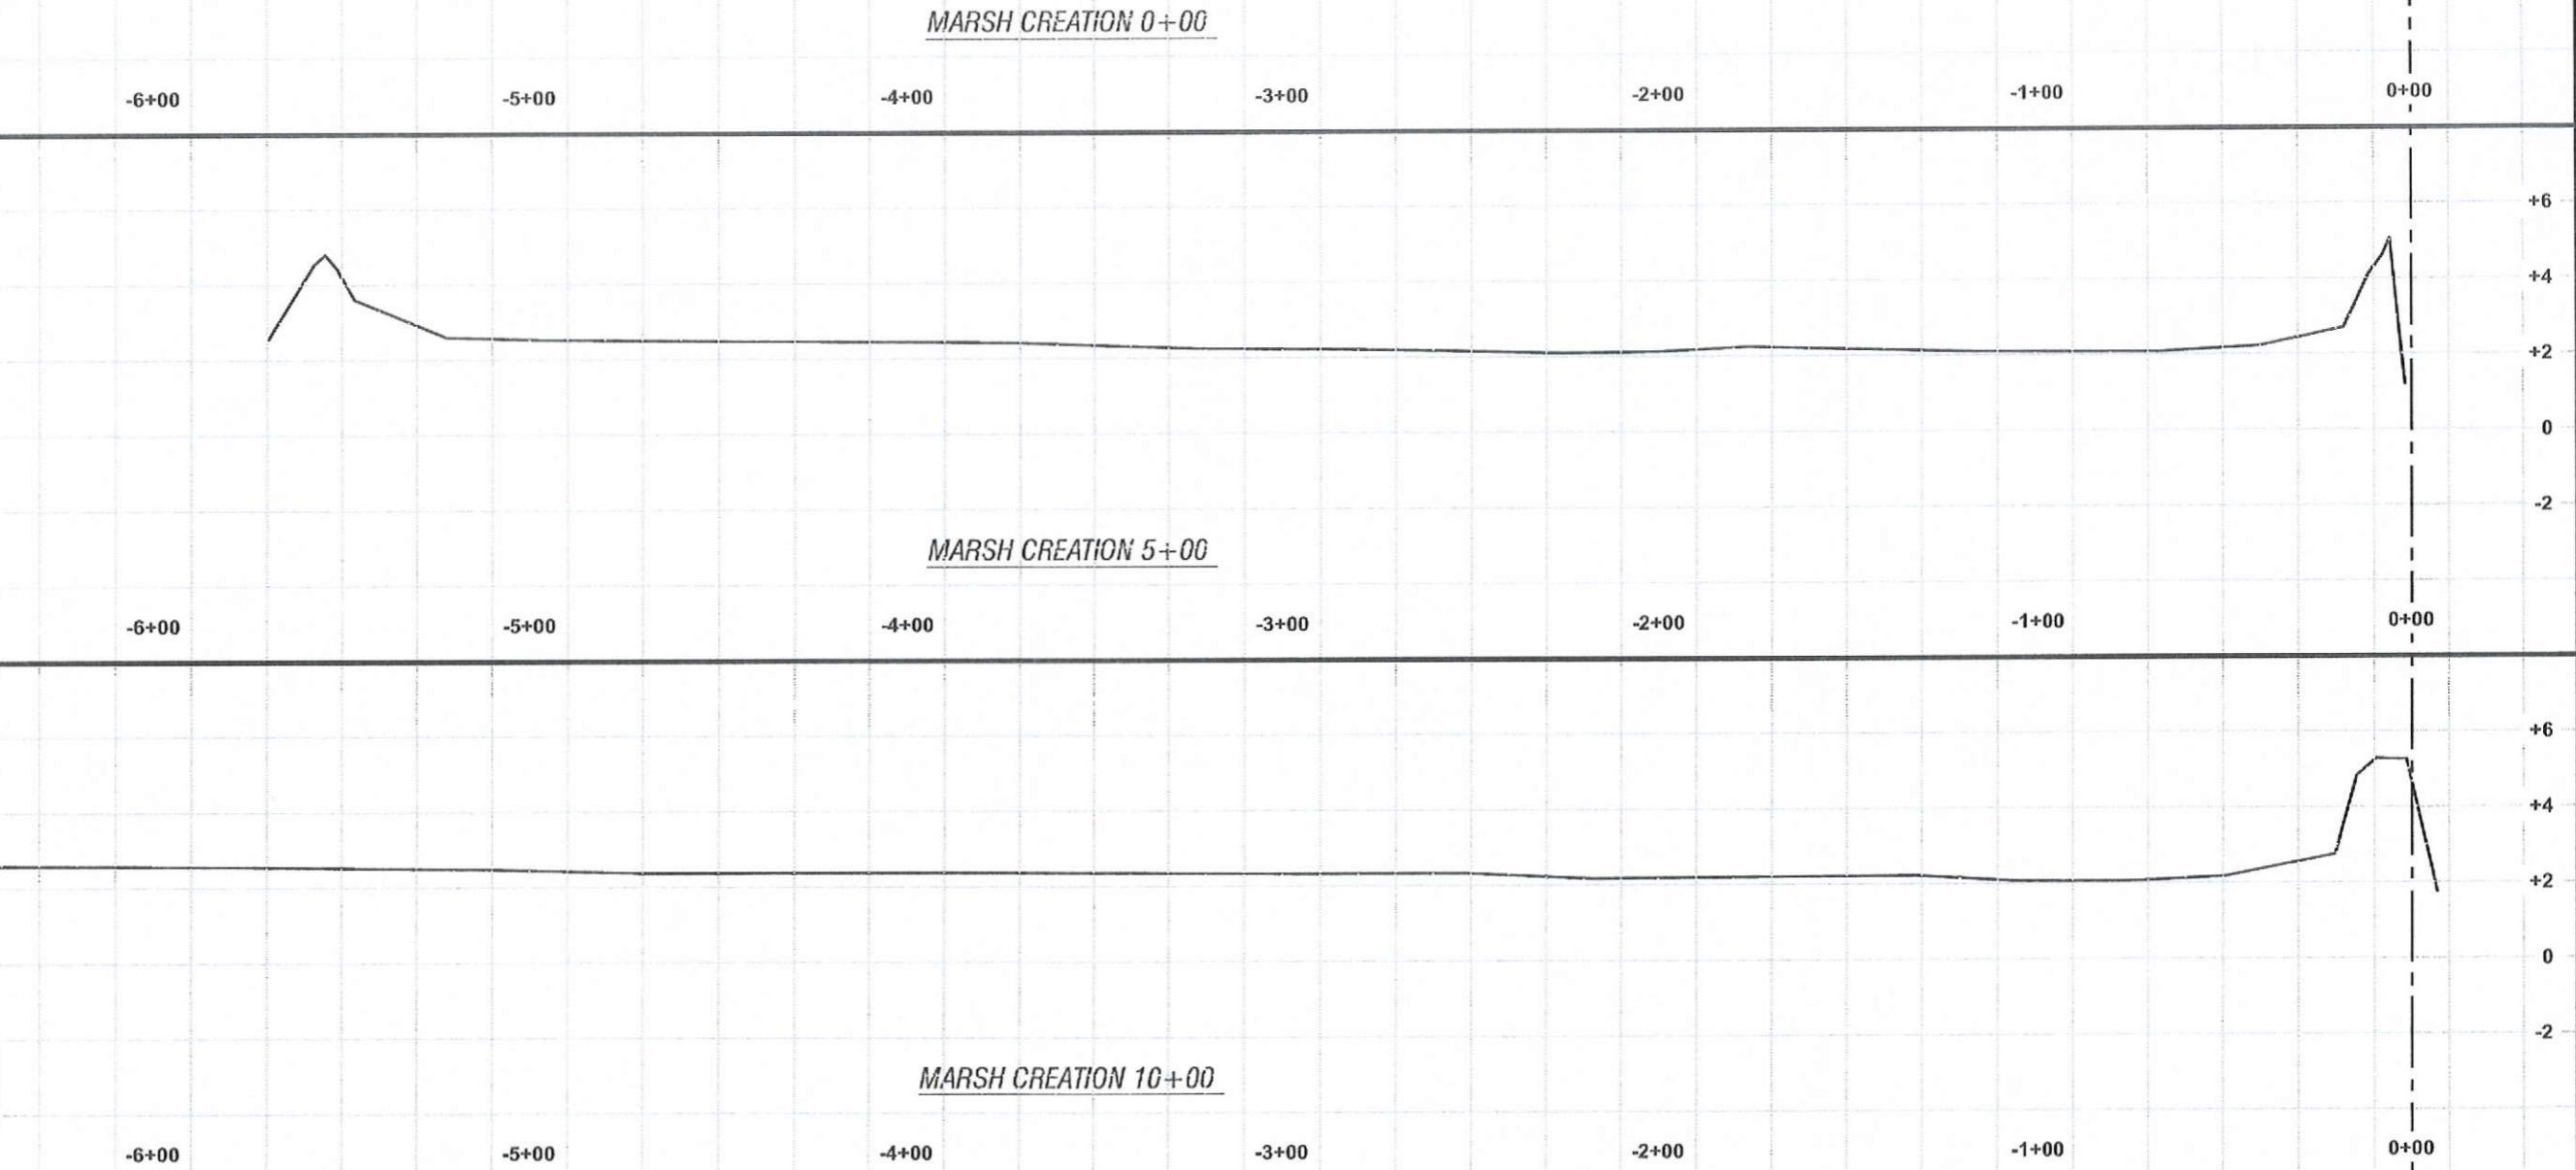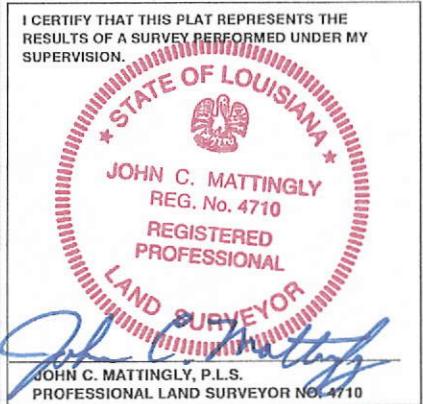

NOTES:




HORIZONTAL SCALE: 1" = 50'		
50'	25'	0'
VERTICAL SCALE: 1" = 5'		
5'	2.5'	0'
REV. NO.: 00	REV. DATE: --/--/--	REV. BY: --
REVISION DESCRIPTION: --		

DRAWN BY:	JMC	APPROVED BY:	JCM
DATE:	5/5/2015	JOB NO:	2015.0072
DRAWING NAME:	3-6 MC TRANSECTS.DWG		
PROJECTION:	LA83-SF-MOD		
GEO. DATUM:	NAD83 VERT. DATUM: NAVD88		
GRID UNITS:	US SURVEY FEET		
SHEET NO:	3	OF	22




MARSH CREATION TRANSECTS

COASTAL PROTECTION AND RESTORATION AUTHORITY
TETRA TECH, INC.
RACCOON ISLAND SHORELINE PROTECTION/
MARSH CREATION (TE-48) PROJECT
BREAKWATER SURVEY
TERREBONNE PARISH, LOUISIANA

NOTE: ALL PROFILES
SHOWN LOOKING WEST

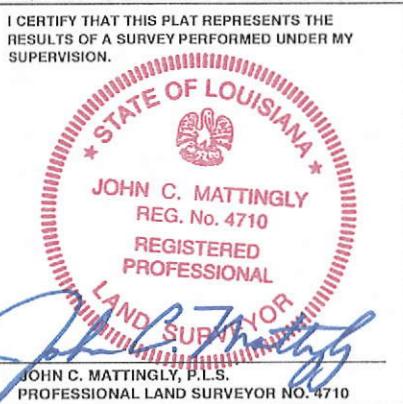

ALIGNMENT

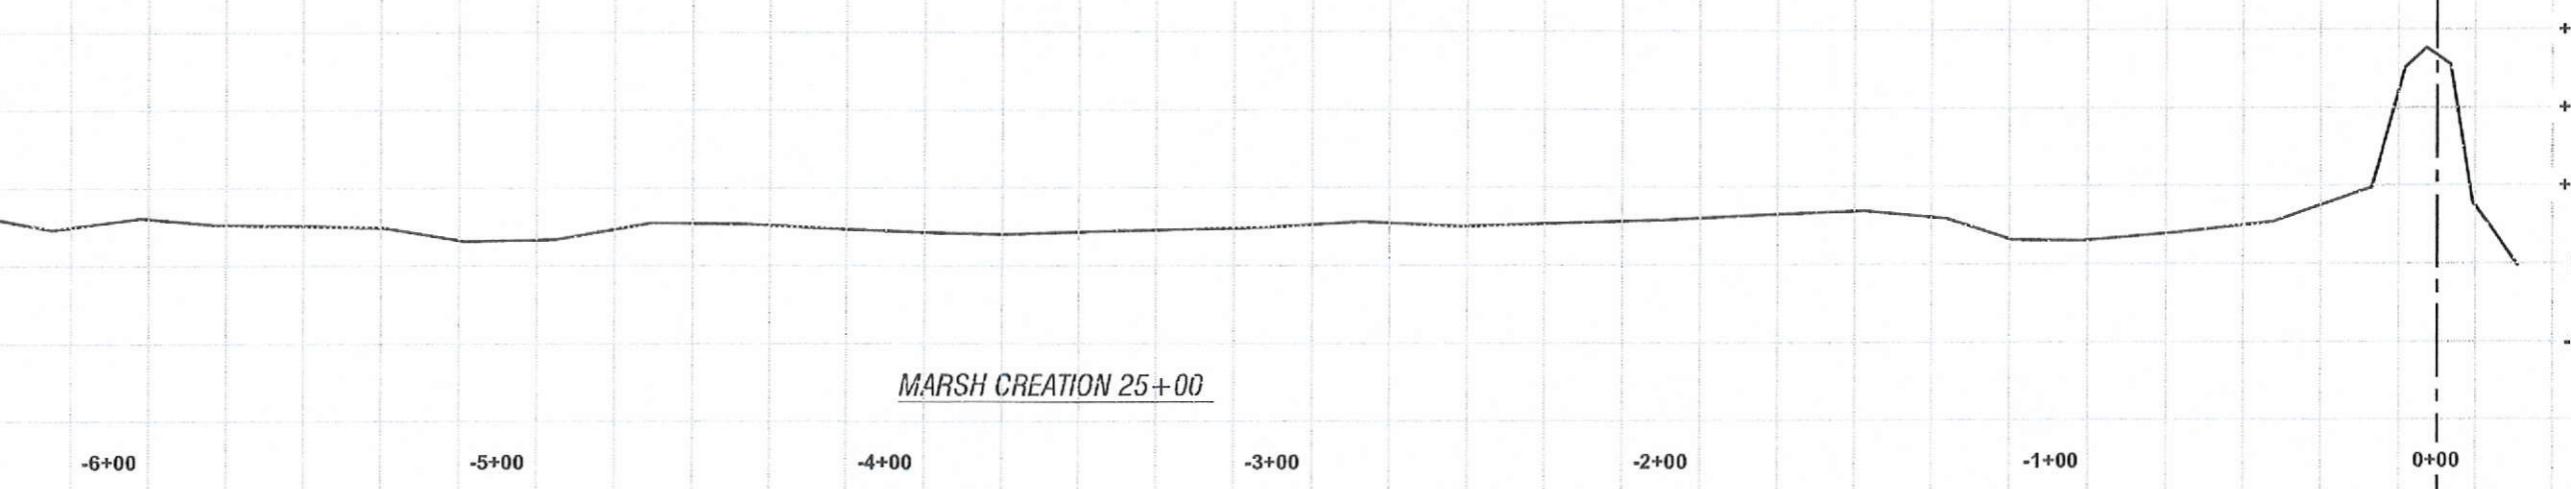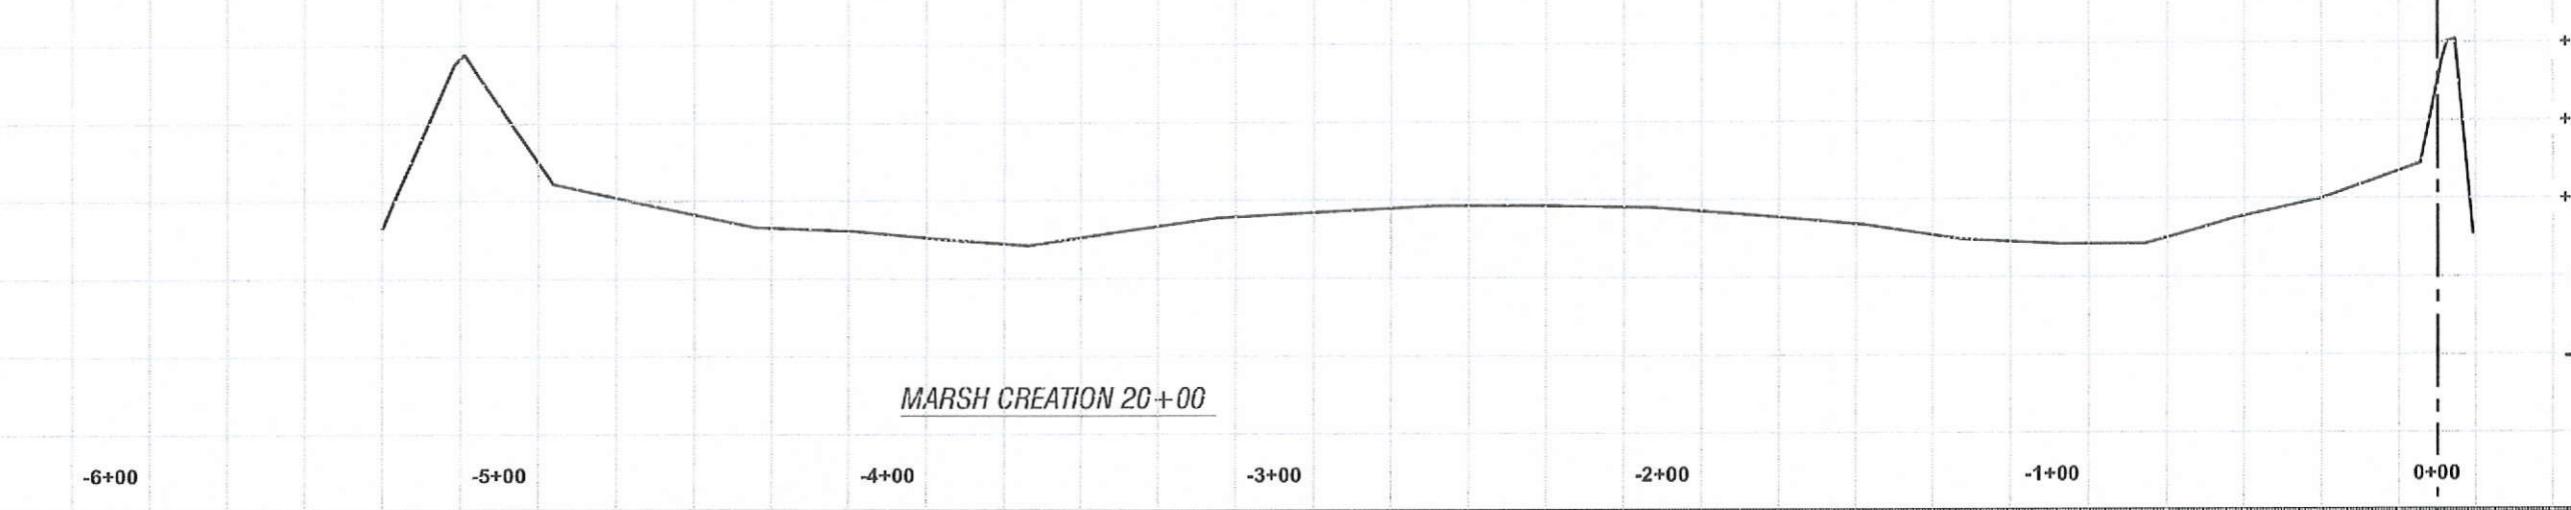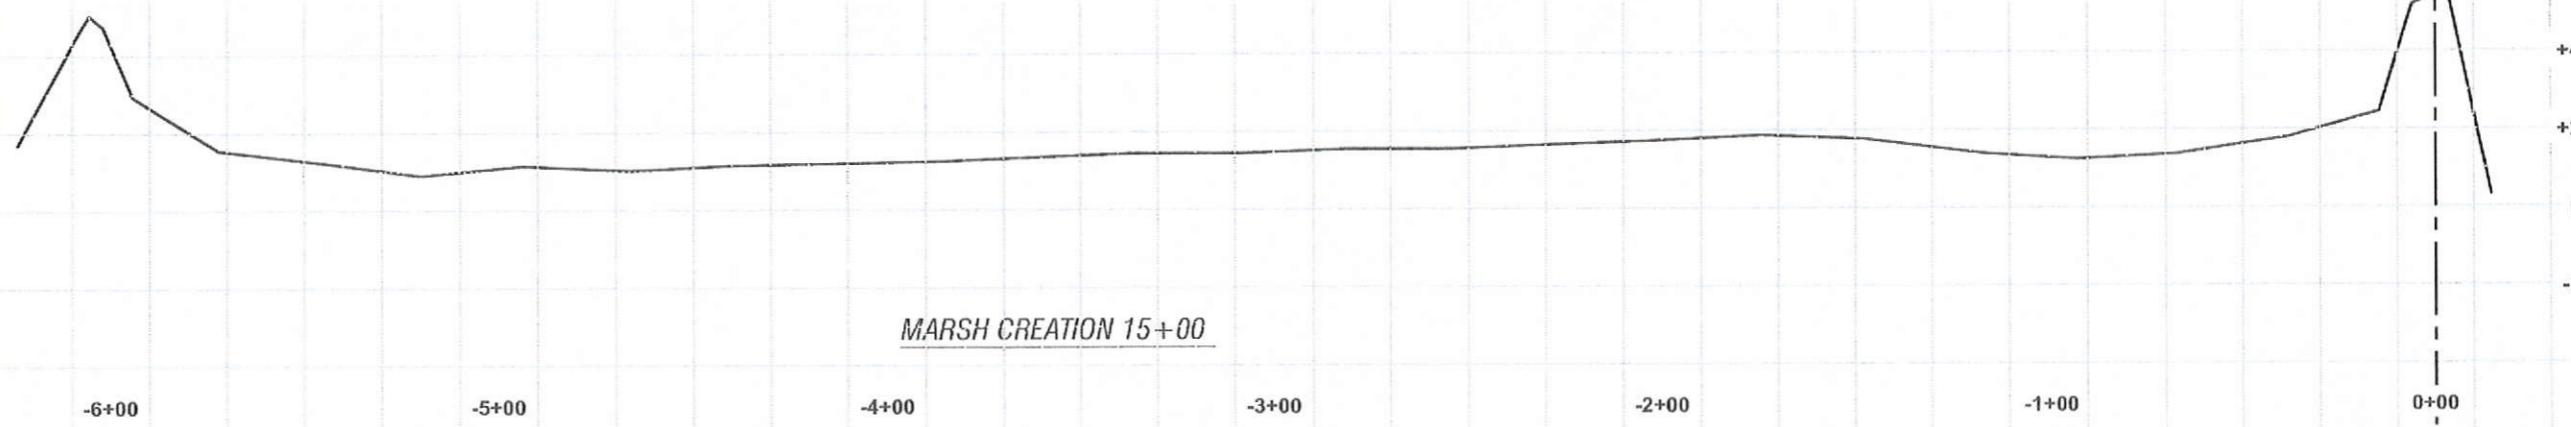

LEGEND
— TBS TOPOGRAPHIC SURVEY
TAKEN FEBRUARY 2015

NOTES:



T. BAKER SMITH
SOLUTIONS START HERE
112 Main Van Allen, Houma, LA 70360
(985)468-1050 | tbsolutions.com

HORIZONTAL SCALE: 1" = 50'
50' 25' 0' 50'
VERTICAL SCALE: 1" = 5'
5' 2.5' 0' 5'

REV. NO: 00 REV. DATE: --- REV. BY: ---

REVISION DESCRIPTION:
--

DRAWN BY: JMC APPROVED BY: JCM
DATE: 5/5/2015 JOB NO: 2015.0072
DRAWING NAME: 3-6 MC TRANSECTS.DWG
PROJECTION: LA83-SF-MOD
GEO. DATUM: NAD83 | VERT. DATUM: NAVD88
GRID UNITS: US SURVEY FEET
SHEET NO: 4 OF 22

MARSH CREATION TRANSECTS

COASTAL PROTECTION AND RESTORATION AUTHORITY
TETRA TECH, INC.
RACCOON ISLAND SHORELINE PROTECTION/
MARSH CREATION (TE-48) PROJECT
BREAKWATER SURVEY
TERREBONNE PARISH, LOUISIANA

NOTE: ALL PROFILES
SHOWN LOOKING WEST

ALIGNMENT



MARSH CREATION 30+00

-7+00 -6+00 -5+00 -4+00 -3+00 -2+00 -1+00 0+00


MARSH CREATION 35+00

-7+00 -6+00 -5+00 -4+00 -3+00 -2+00 -1+00 0+00

MARSH CREATION 40+00

-7+00 -6+00 -5+00 -4+00 -3+00 -2+00 -1+00 0+00

5/5/2015 - P:\\Y-2015\\2015_0072\\DWG13-6 MC TRANSECTS.DWG

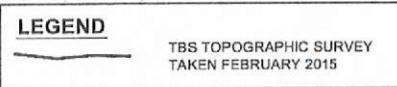

T. BAKER SMITH
SOLUTIONS START HERE
112 South Van Ave. Houma, LA 70363
(985)866-1050 - tbsmith.com

NOTES:

HORIZONTAL SCALE: 1" = 50'
50' 25' 0' 50'
VERTICAL SCALE: 1" = 5'
5' 2.5' 0' 5'

REV. NO: 00 REV. DATE: --- REV. BY: ---

REVISION DESCRIPTION:
--

DRAWN BY: JMC APPROVED BY: JCM
DATE: 5/5/2015 JOB NO: 2015.0072
DRAWING NAME: 3-6 MC TRANSECTS.DWG
PROJECTION: LA83-SF-MOD
GEO. DATUM: NAD83 | VERT. DATUM: NAVD88
GRID UNITS: US SURVEY FEET
SHEET NO: 5 OF 22

MARSH CREATION TRANSECTS


COASTAL PROTECTION AND RESTORATION AUTHORITY
TETRA TECH, INC.
RACCOON ISLAND SHORELINE PROTECTION/
MARSH CREATION (TE-48) PROJECT
BREAKWATER SURVEY
TERREBONNE PARISH, LOUISIANA

NOTE: ALL PROFILES
SHOWN LOOKING WEST

ALIGNMENT

-7+00 -6+00 -5+00 -4+00 -3+00 -2+00 -1+00 0+00

MARSH CREATION 41+71

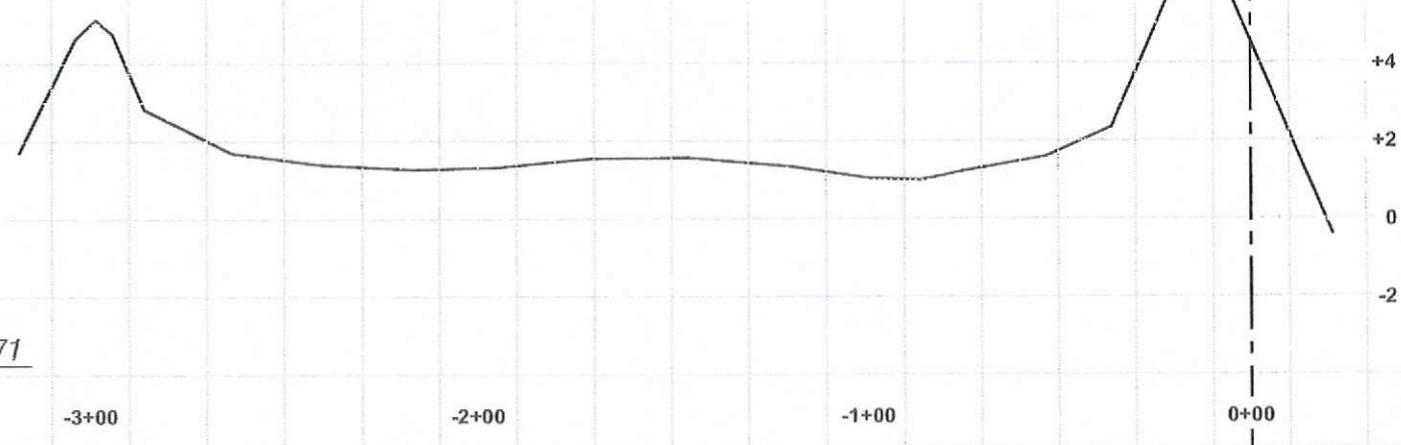

NOTES:



T. BAKER SMITH
SOLUTIONS START HERE
412 South Main Ave., Houma, LA 70363
(985) 874-0160 | tbsmith.com

HORIZONTAL SCALE: 1" = 50'
50' 25' 0' 50'
VERTICAL SCALE: 1" = 5'
5' 2.5' 0' 5'

REV. NO: 00 REV. DATE: --/-- REV. BY: --

REVISION DESCRIPTION:
--


DRAWN BY: JMC APPROVED BY: JCM

DATE: 5/5/2015 JOB NO: 2015.0072

DRAWING NAME: 3-6 MC TRANSECTS.DWG


PROJECTION: LA83-SF-MOD
GEO. DATUM: NAD83 | VERT. DATUM: NAVD88
GRID UNITS: US SURVEY FEET

SHEET NO: 6 OF 22

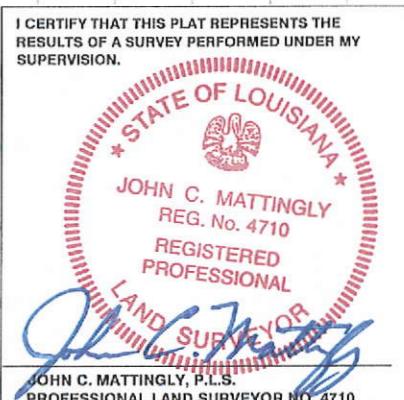

MARSH CREATION TRANSECTS

COASTAL PROTECTION AND RESTORATION AUTHORITY
TETRA TECH, INC.
RACCOON ISLAND SHORELINE PROTECTION/
MARSH CREATION (TE-48) PROJECT
BREAKWATER SURVEY
TERREBONNE PARISH, LOUISIANA

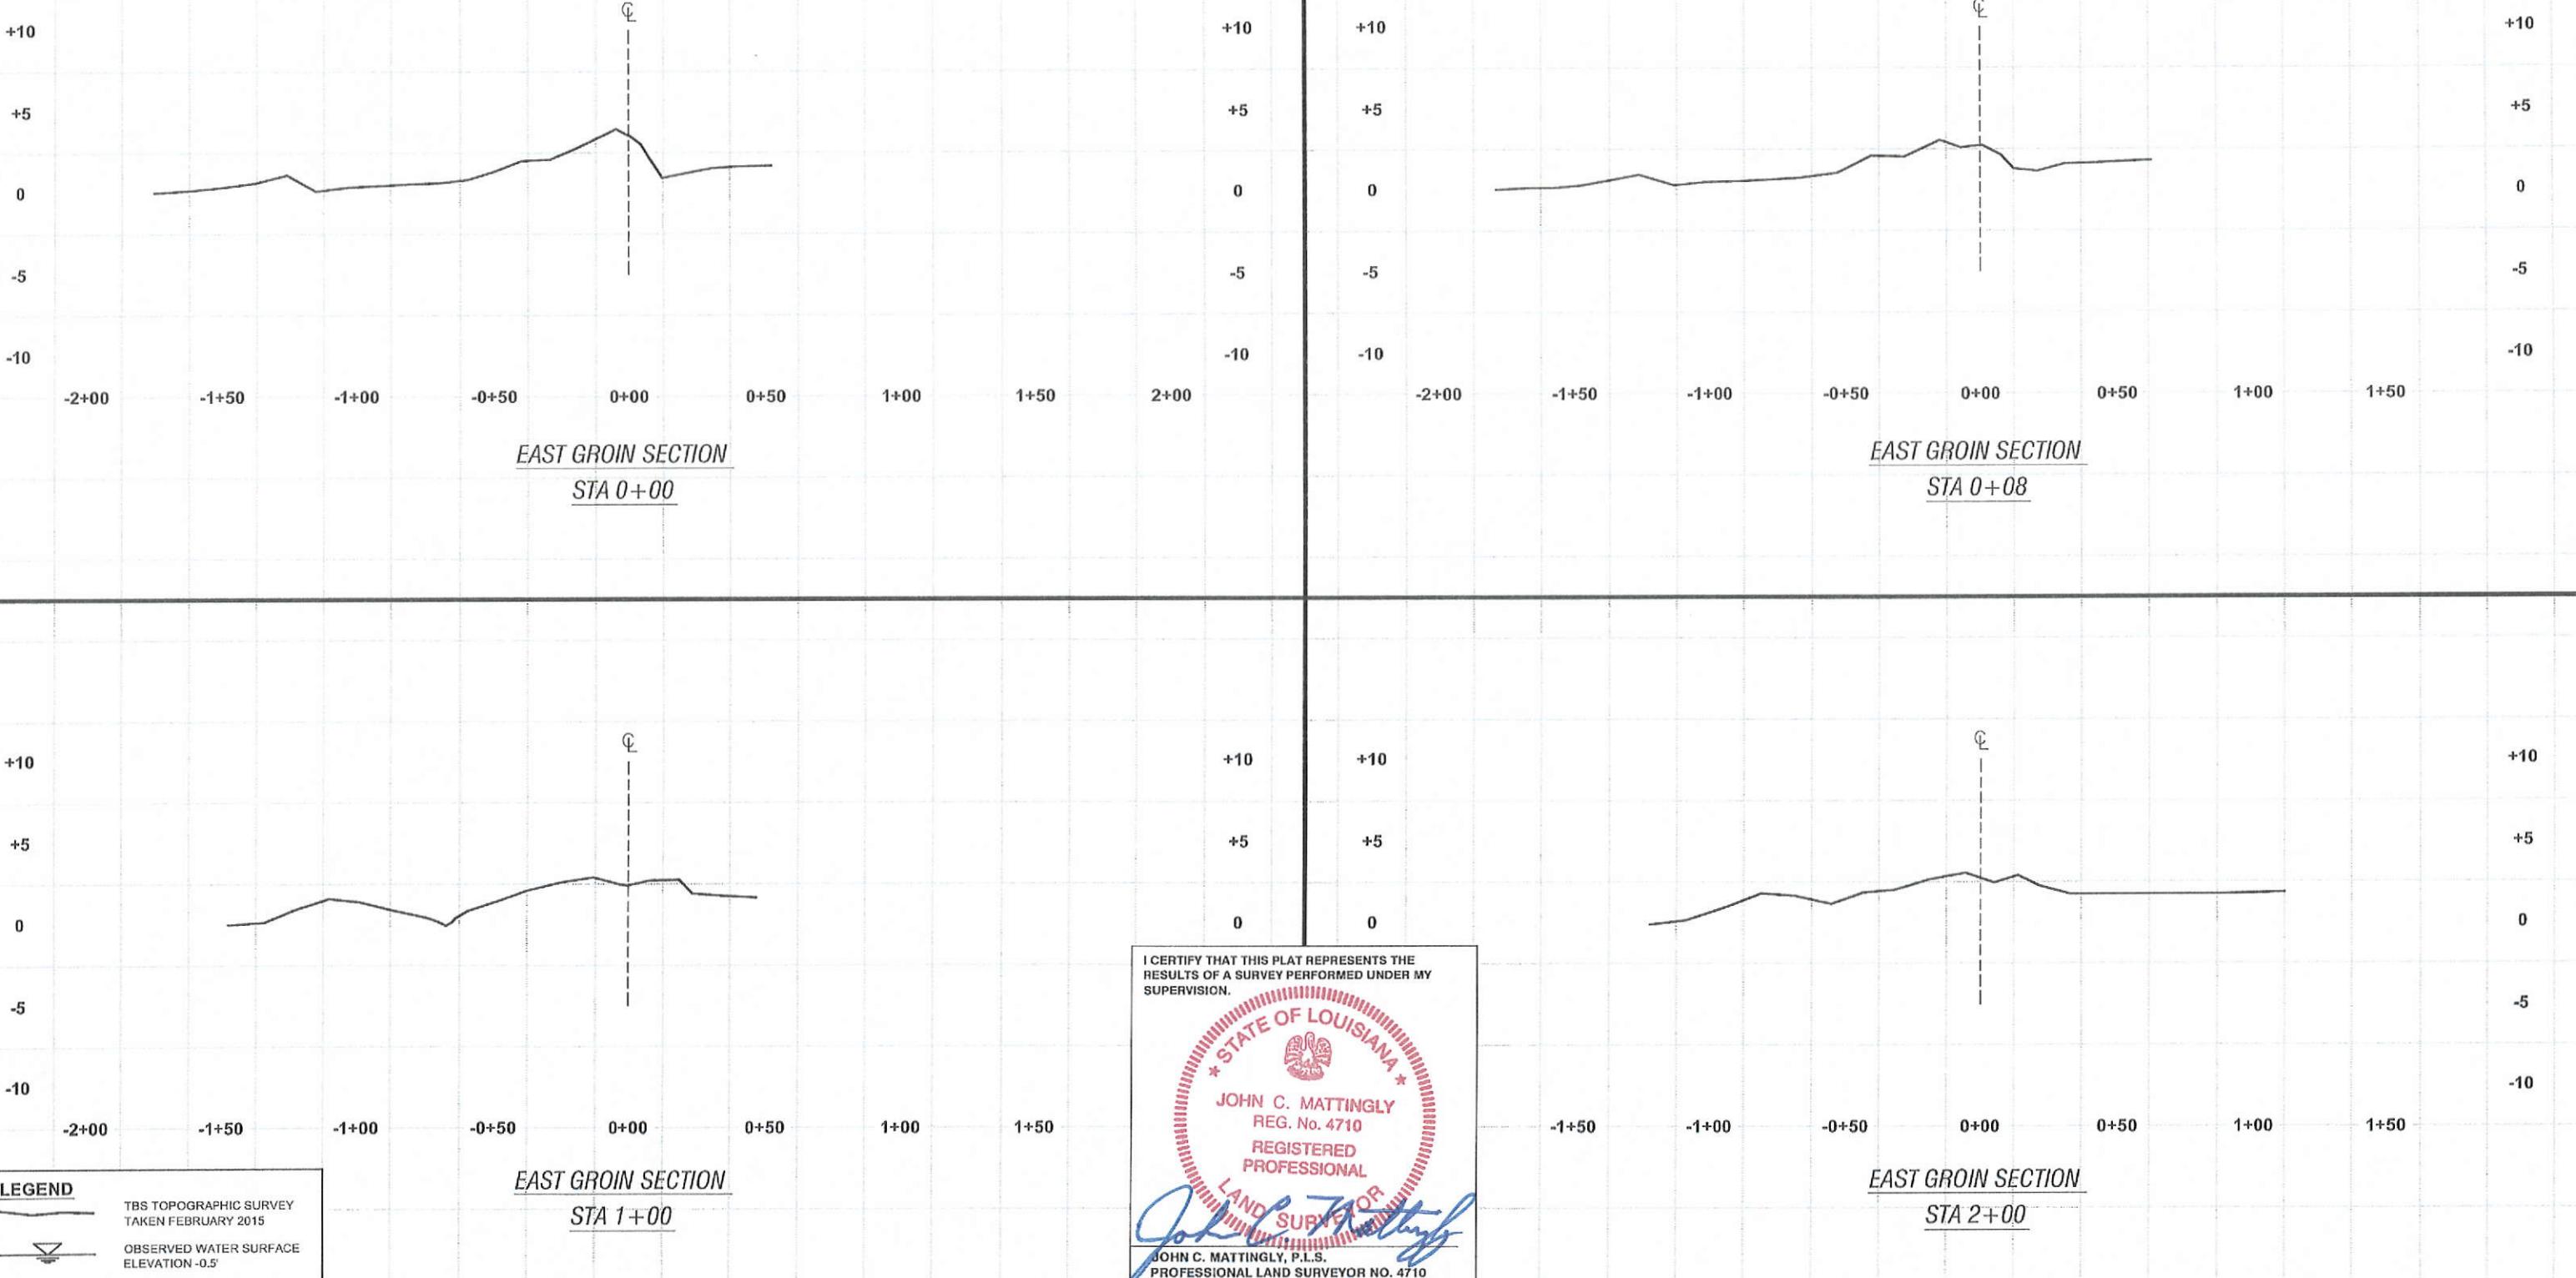

NOTES:




TBS

T. BAKER SMITH
SOLUTIONS START HERE
812 Smith Van Ave., Houma, LA 70363
(985)868-1080 | tbsmth.com


HORIZONTAL SCALE: 1" = 60'
60' 30' 0' 60'
VERTICAL SCALE: 1" = 10'
10' 5' 0' 10'
REV. NO: 00 REV. DATE: -/-/- REV. BY: ---
REVISION DESCRIPTION: --

DRAWN BY: A.W.S. APPROVED BY: K.S.B.
DATE: 5/5/2015 JOB NO: 2015.0072
DRAWING NAME: 7-17 150072X-SEC01.DWG
PROJECTION: LA83-SF-MOD
GEO. DATUM: NAD83 | VERT. DATUM: NAVD88
GRID UNITS: US SURVEY FEET
SHEET NO: 7 OF 22


EAST GROIN TRANSECTS
COASTAL PROTECTION AND RESTORATION AUTHORITY
TETRA TECH, INC.
RACCOON ISLAND SHORELINE PROTECTION/
MARSH CREATION (TE-48) PROJECT
BREAKWATER SURVEY
TERREBONNE PARISH, LOUISIANA

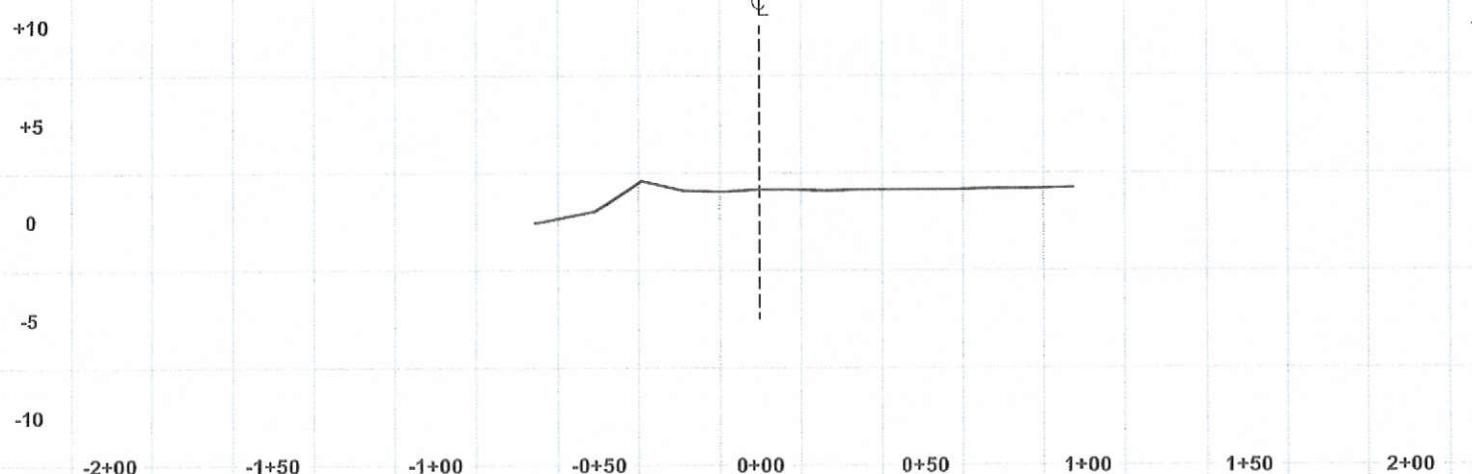


EAST GROIN SECTION
STA 3+00

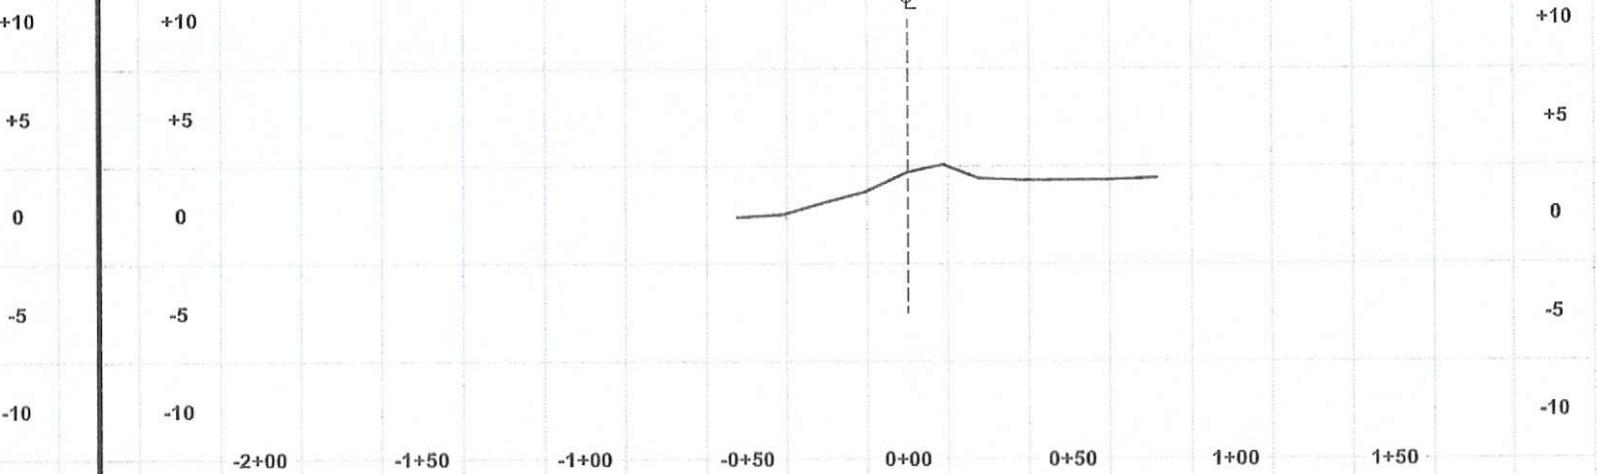

EAST GROIN SECTION
STA 4+00

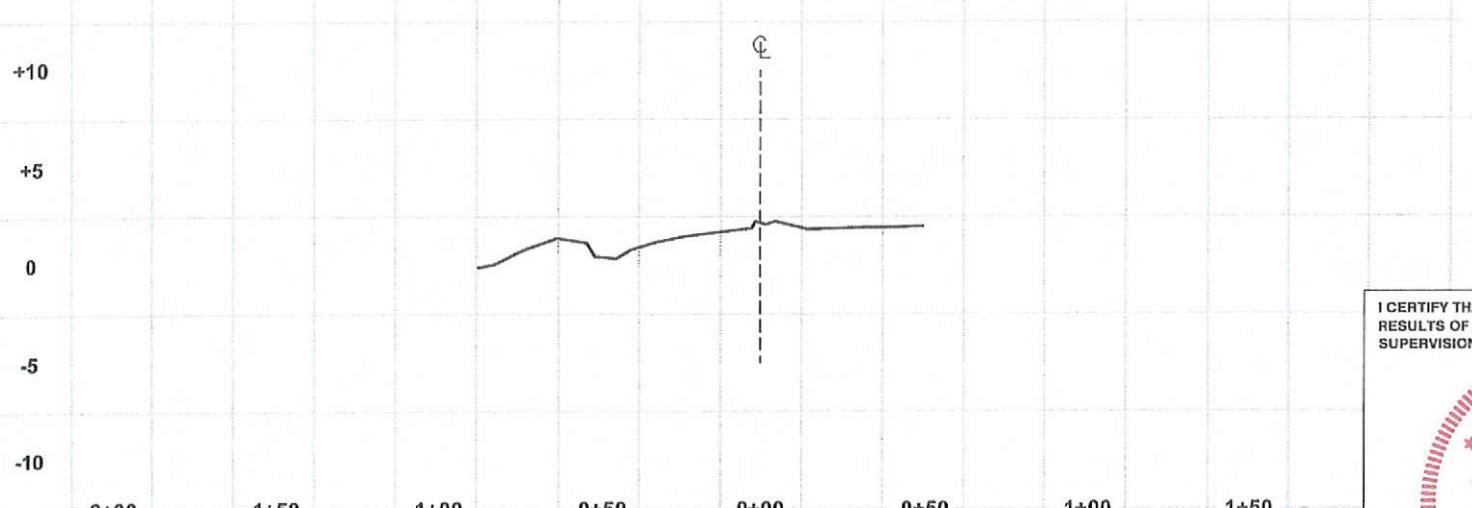

EAST GROIN SECTION
STA 5+00

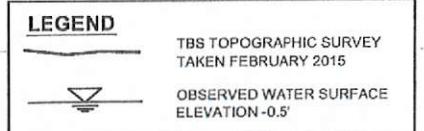

REV. NO: 00 REV. DATE: -/-/- REV. BY: ---

REVISION DESCRIPTION:
--

HORIZONTAL SCALE: 1" = 60'

60' 30' 0' 60'

VERTICAL SCALE: 1" = 10'

10' 5' 0' 10'

DRAWN BY: A.W.S. APPROVED BY: K.S.B.

DATE: 5/5/2015 JOB NO: 2015.0072

DRAWING NAME: 7-17 150072X-SEC01.DWG

PROJECTION: LA83-SF-MOD

GEO. DATUM: NAD83 | VERT. DATUM: NAVD88




GRID UNITS: US SURVEY FEET

SHEET NO: 8 OF 22





EAST GROIN TRANSECTS

COASTAL PROTECTION AND RESTORATION AUTHORITY
TETRA TECH, INC.
RACCOON ISLAND SHORELINE PROTECTION/
MARSH CREATION (TE-48) PROJECT
BREAKWATER SURVEY
TERREBONNE PARISH, LOUISIANA





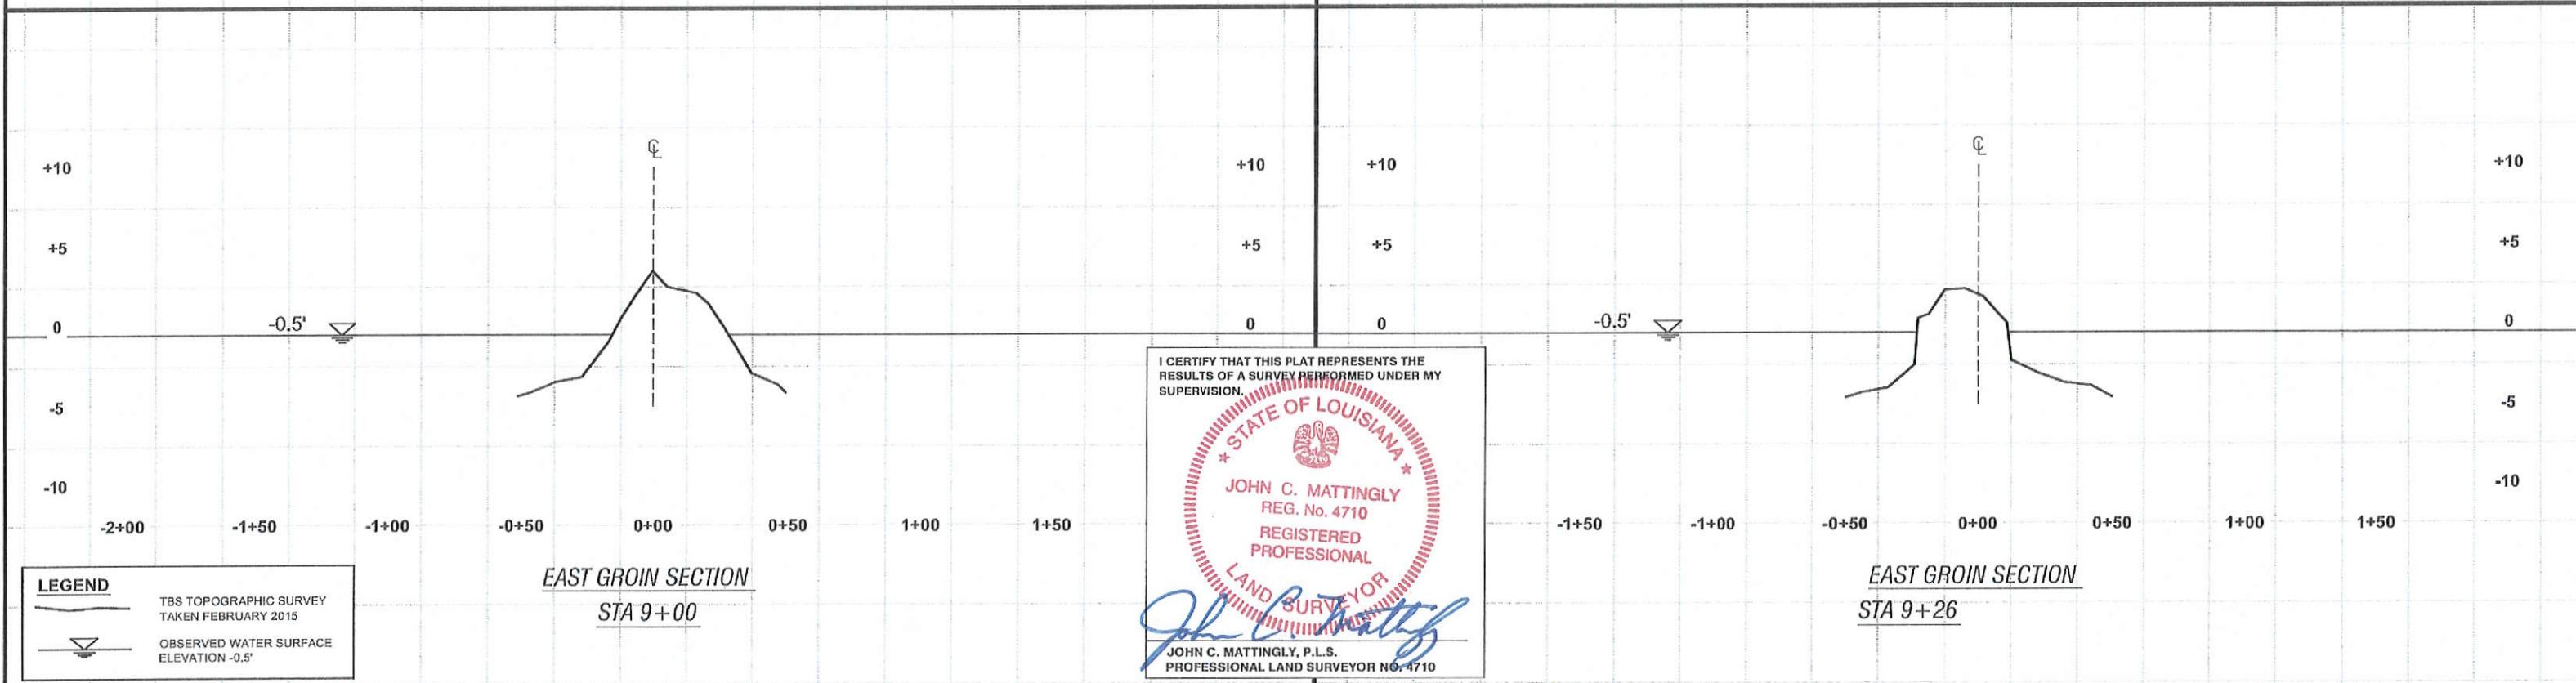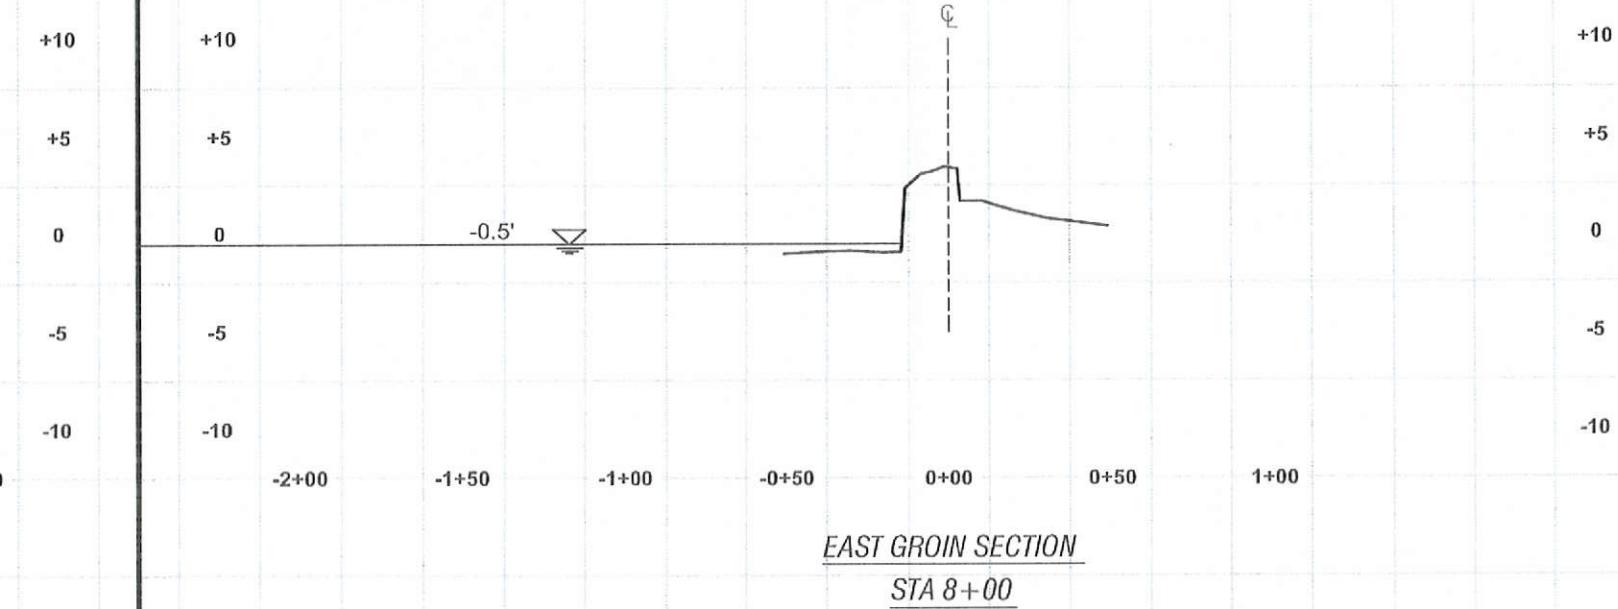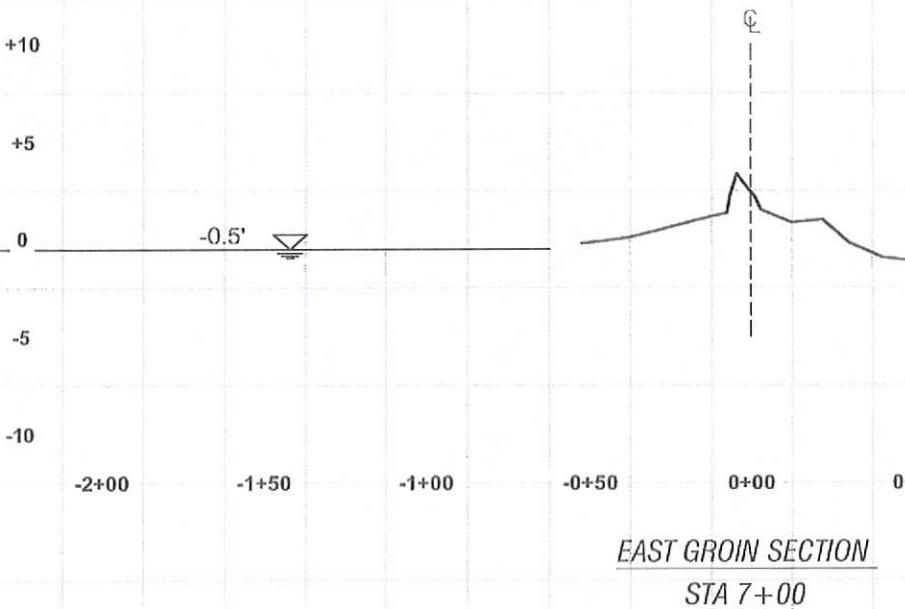

NOTE: ALL PROFILES SHOWN LOOKING WEST

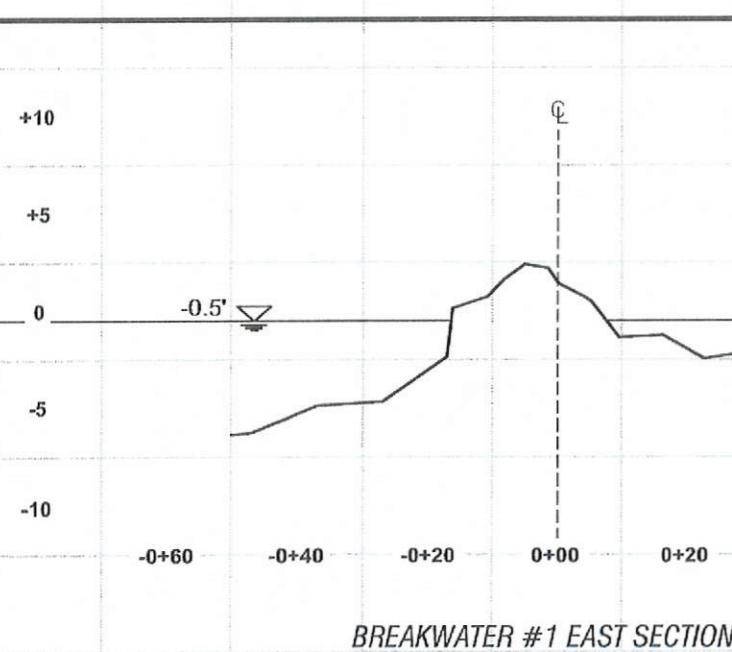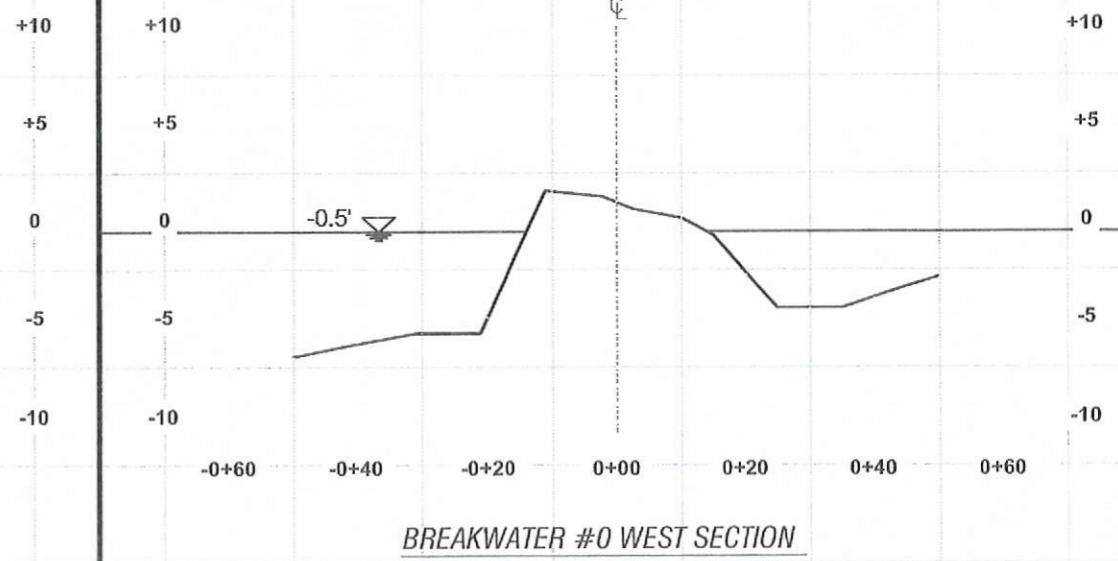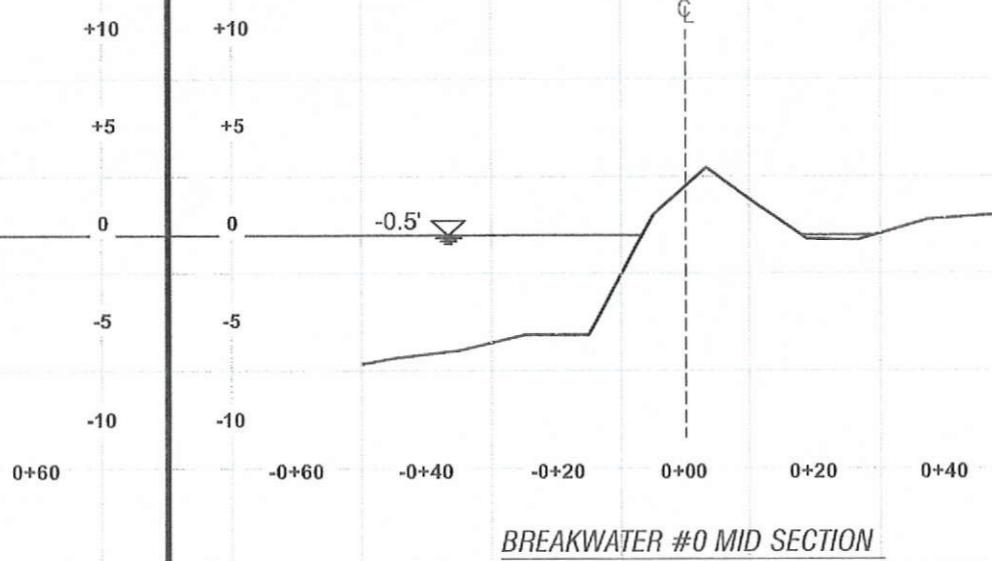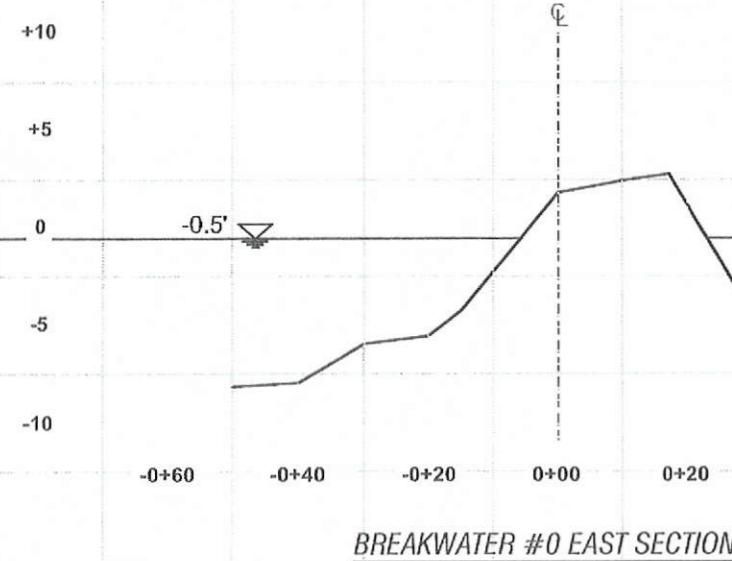

BREAKWATER #1 MID SECTION

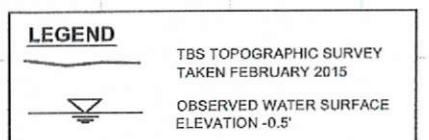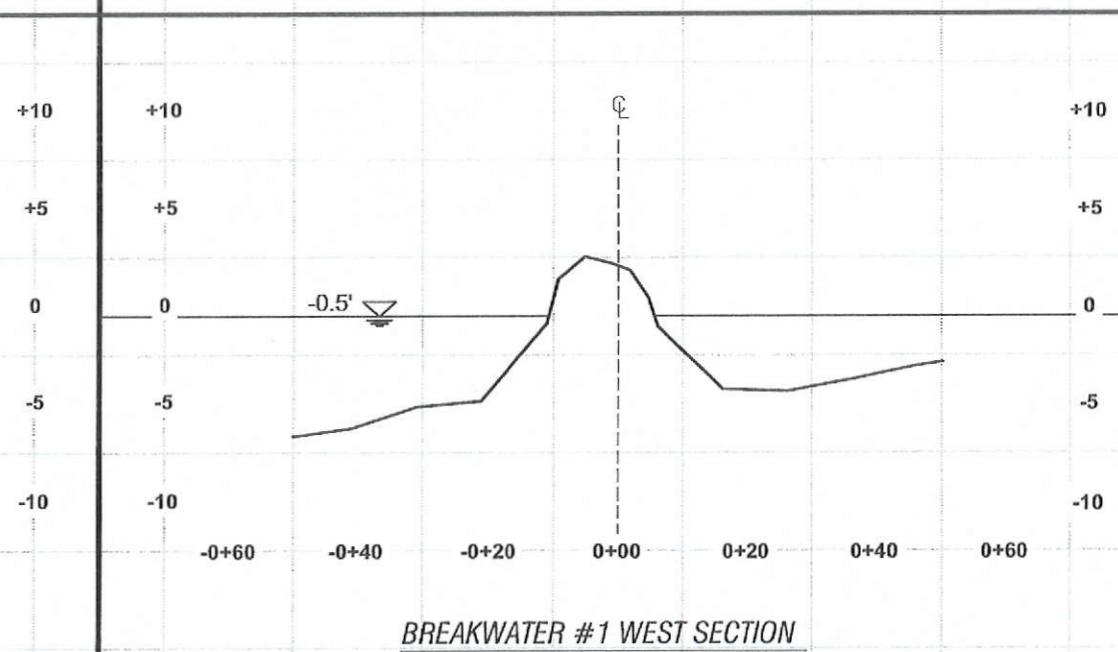

NOTES:



T. BAKER SMITH
SOLUTIONS START HERE
412 South Virginia Street, Houma, LA 70360
(337) 852-1000 • tbsmith.com









HORIZONTAL SCALE: 1" = 30'
30' 15' 0' 30'
VERTICAL SCALE: 1" = 10'
10' 5' 0' 10'
REV. NO: 00 REV. DATE: -/-/- REV. BY: --
REVISION DESCRIPTION: --

DRAWN BY: A.W.S. APPROVED BY: K.S.B.
DATE: 5/5/2015 JOB NO: 2015.0072
DRAWING NAME: 7-17 150072X-SEC01.DWG
PROJECTION: LA83-SF-MOD
GEO. DATUM: NAD83 | VERT. DATUM: NAVD88
GRID UNITS: US SURVEY FEET
SHEET NO: 10 OF 22

BREAKWATER TRANSECTS

COASTAL PROTECTION AND RESTORATION AUTHORITY
TETRA TECH, INC.
RACCOON ISLAND SHORELINE PROTECTION/
MARSH CREATION (TE-48) PROJECT
BREAKWATER SURVEY
TERREBONNE PARISH, LOUISIANA

NOTE: ALL PROFILES
SHOWN LOOKING WEST

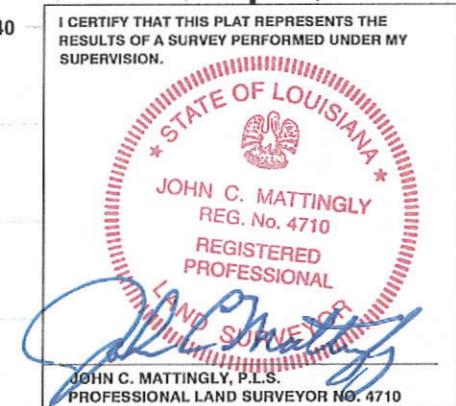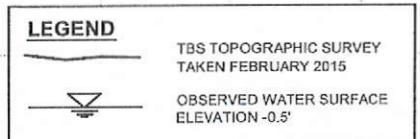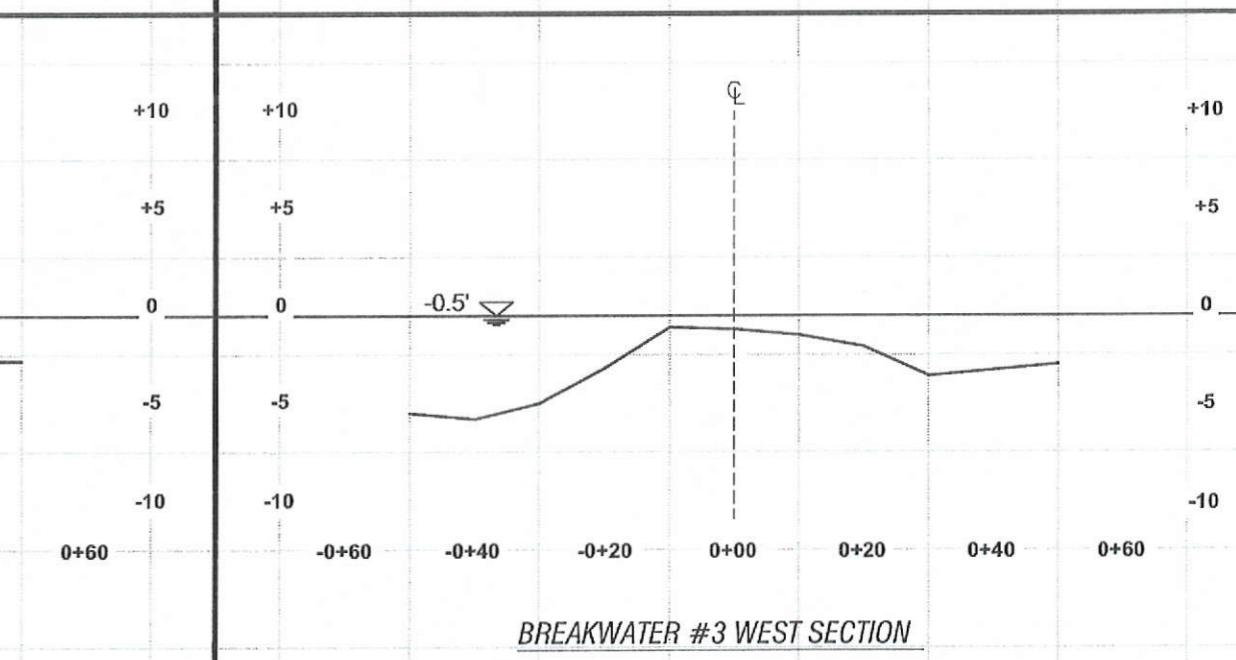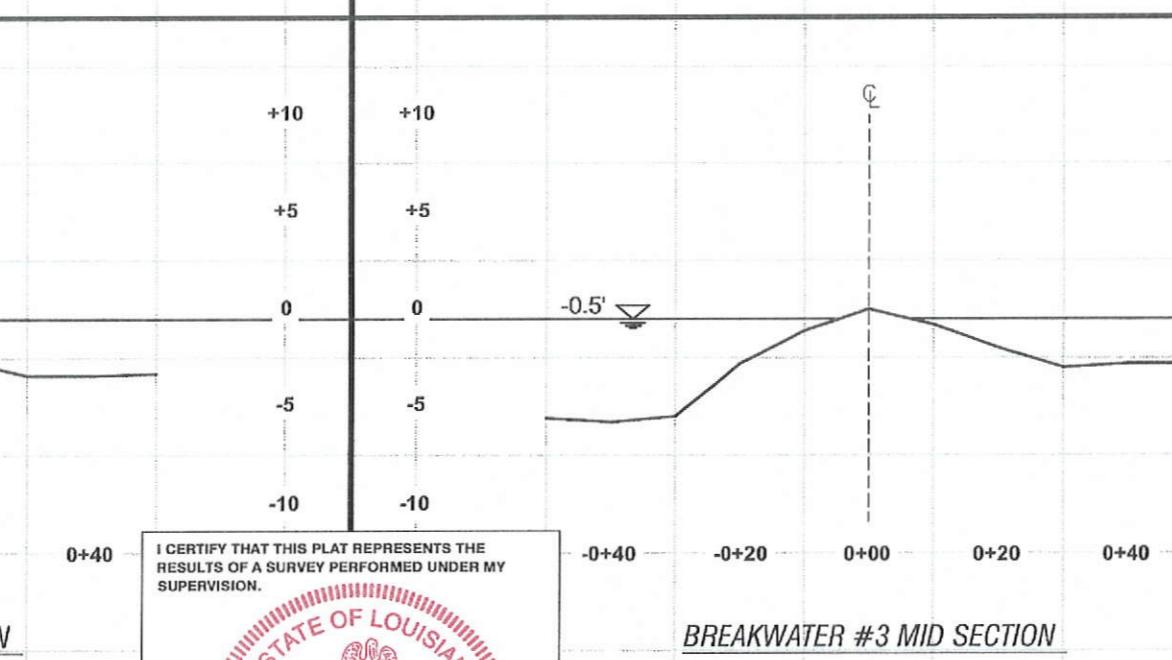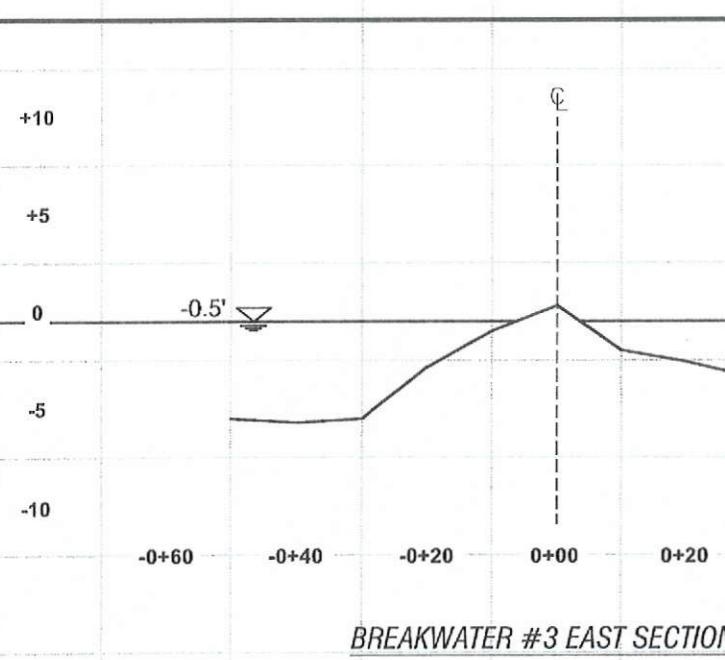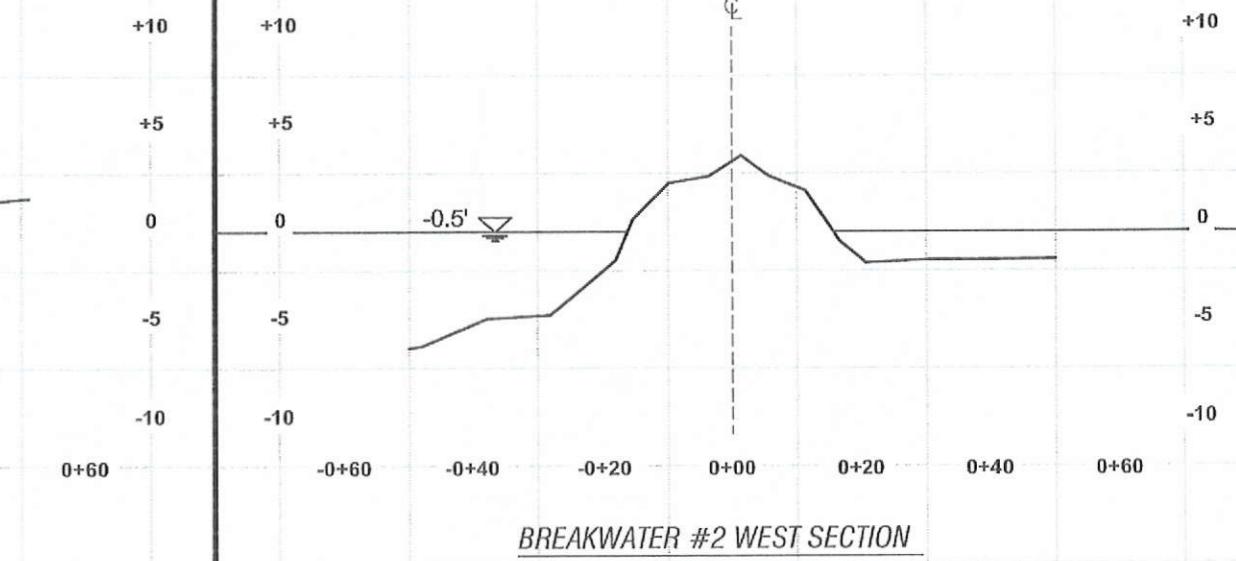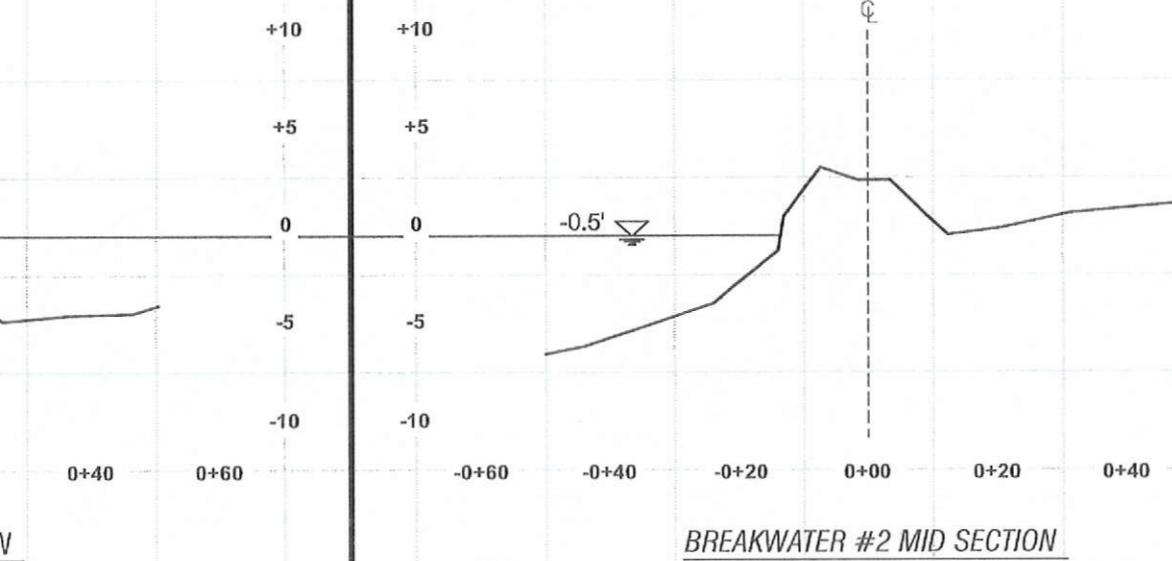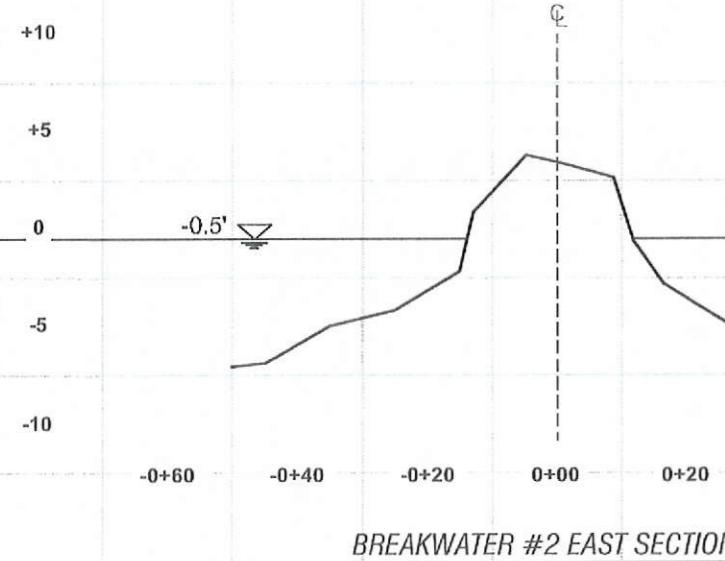

NOTES:



T. BAKER SMITH
SOLUTIONS START HERE
410 Canal Ave., Houma, LA 70360
981.566.4000 | tbs.tetra.com


HORIZONTAL SCALE: 1" = 30'		
30'	15'	0'
VERTICAL SCALE: 1" = 10'		
10'	5'	0'
REV. NO:	00	REV. DATE:
--	--	--
REVISION DESCRIPTION:	--	--

DRAWN BY:	A.W.S.	APPROVED BY:	K.S.B.
DATE:	5/5/2015	JOB NO:	2015.0072
DRAWING NAME:	7-17 150072X-SEC01.DWG		
PROJECTION:	LA83-SF-MOD		
GEO. DATUM: NAD83 VERT. DATUM: NAVD88			GRID UNITS: US SURVEY FEET
SHEET NO:	11 OF 22		

BREAKWATER TRANSECTS

COASTAL PROTECTION AND RESTORATION AUTHORITY
TETRA TECH, INC.
RACCOON ISLAND SHORELINE PROTECTION/
MARSH CREATION (TE-48) PROJECT
BREAKWATER SURVEY
TERREBONNE PARISH, LOUISIANA


NOTE: ALL PROFILES
SHOWN LOOKING WEST

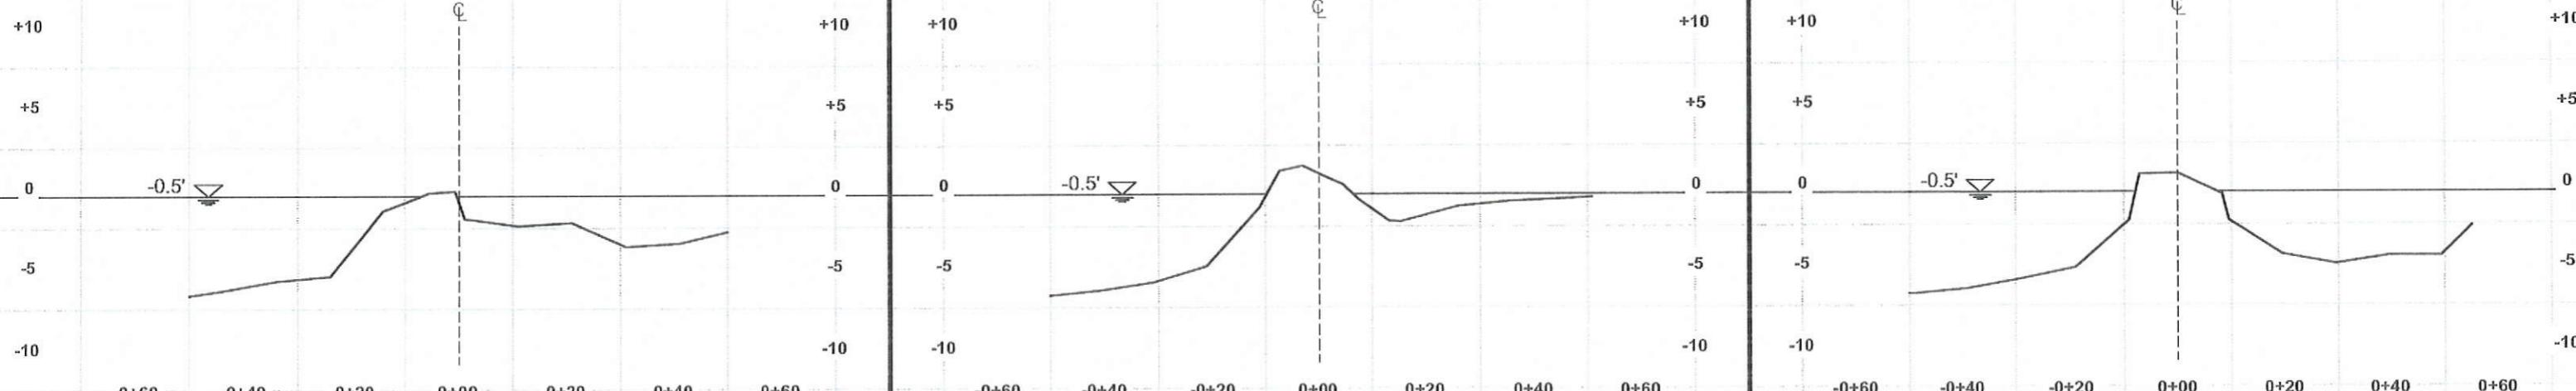

BREAKWATER #4 EAST SECTION

BREAKWATER #4 MID SECTION

BREAKWATER #4 WEST SECTION


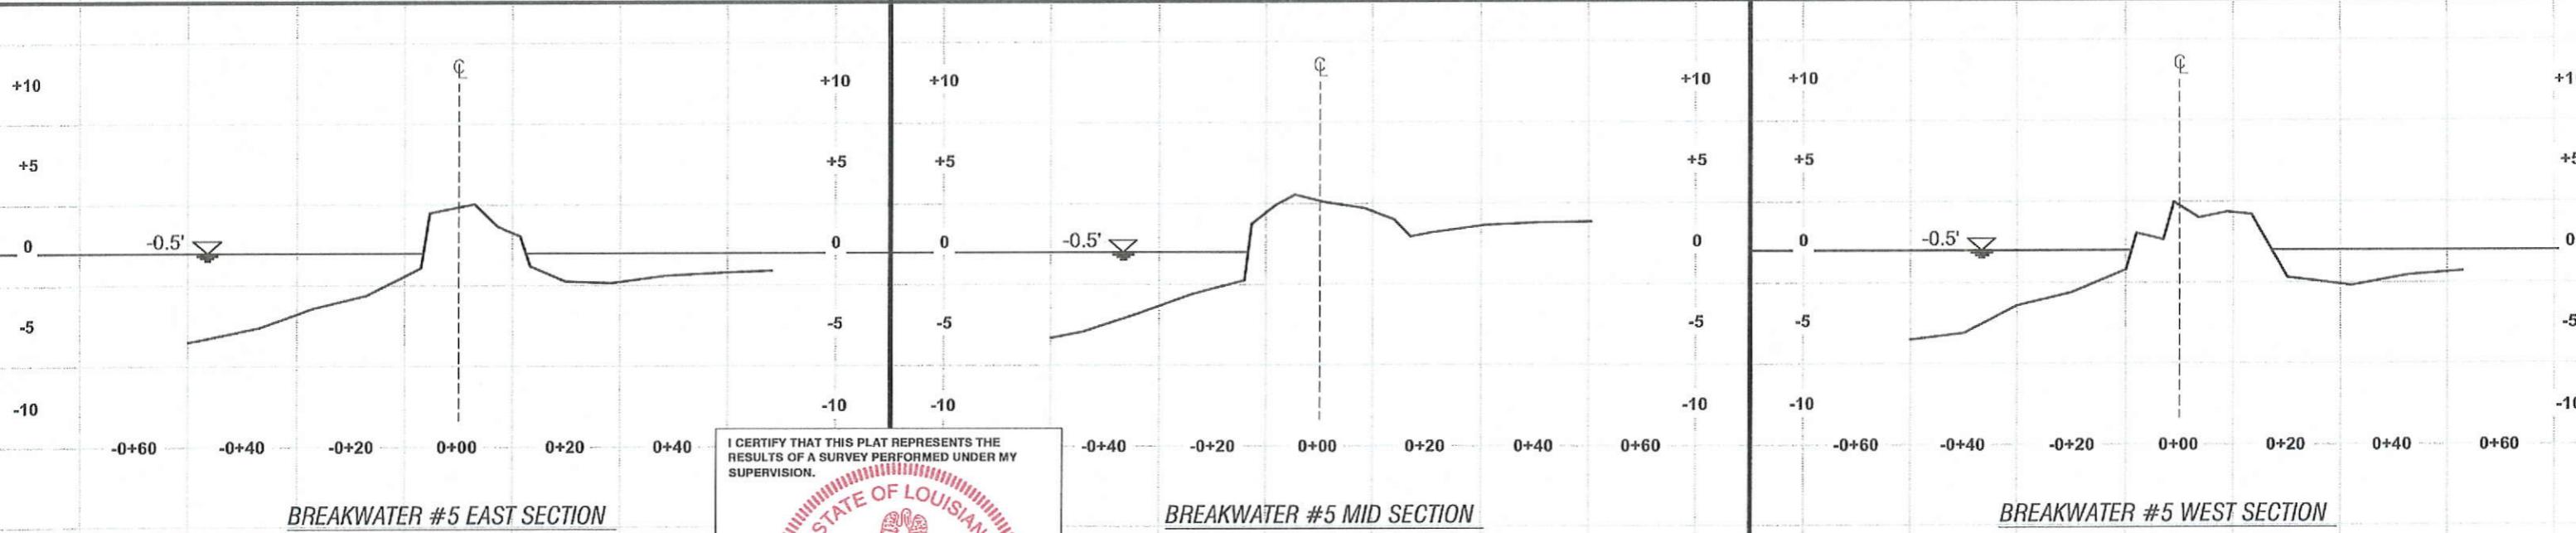


BREAKWATER #5 EAST SECTION

BREAKWATER #5 MID SECTION

BREAKWATER #5 WEST SECTION

5/5/2015 - P:\\Y-2015\\0072\\DWG\\7-17\\150072X-SEC01.DWG

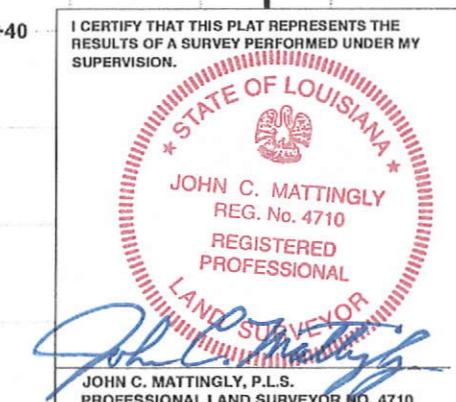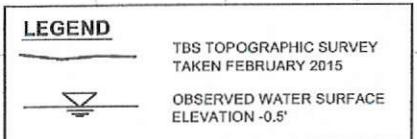

NOTES:



T. BAKER SMITH
SOLUTIONS START HERE
412 South 2nd Ave., Houma LA 70360
(985) 873-1000 | tbs@tbsinc.com

HORIZONTAL SCALE: 1" = 30'
30' 15' 0' 30'
10' 5' 0' 10'
VERTICAL SCALE: 1" = 10'
10' 5' 0' 10'

REV. NO: 00 REV. DATE: -/-/- REV. BY: ---


REVISION DESCRIPTION:
--

DRAWN BY:	A.W.S.	APPROVED BY:	K.S.B.
DATE:	5/5/2015	JOB NO:	2015.0072
DRAWING NAME:	7-17 150072X-SEC01.DWG		
PROJECTION:	LA83-SF-MOD		
GEO. DATUM:	NAD83 VERT. DATUM: NAVD88		
GRID UNITS:	US SURVEY FEET		
SHEET NO:	12	OF	22

BREAKWATER TRANSECTS

COASTAL PROTECTION AND RESTORATION AUTHORITY
TETRA TECH, INC.
RACCOON ISLAND SHORELINE PROTECTION/
MARSH CREATION (TE-48) PROJECT
BREAKWATER SURVEY
TERREBONNE PARISH, LOUISIANA


NOTE: ALL PROFILES
SHOWN LOOKING WEST

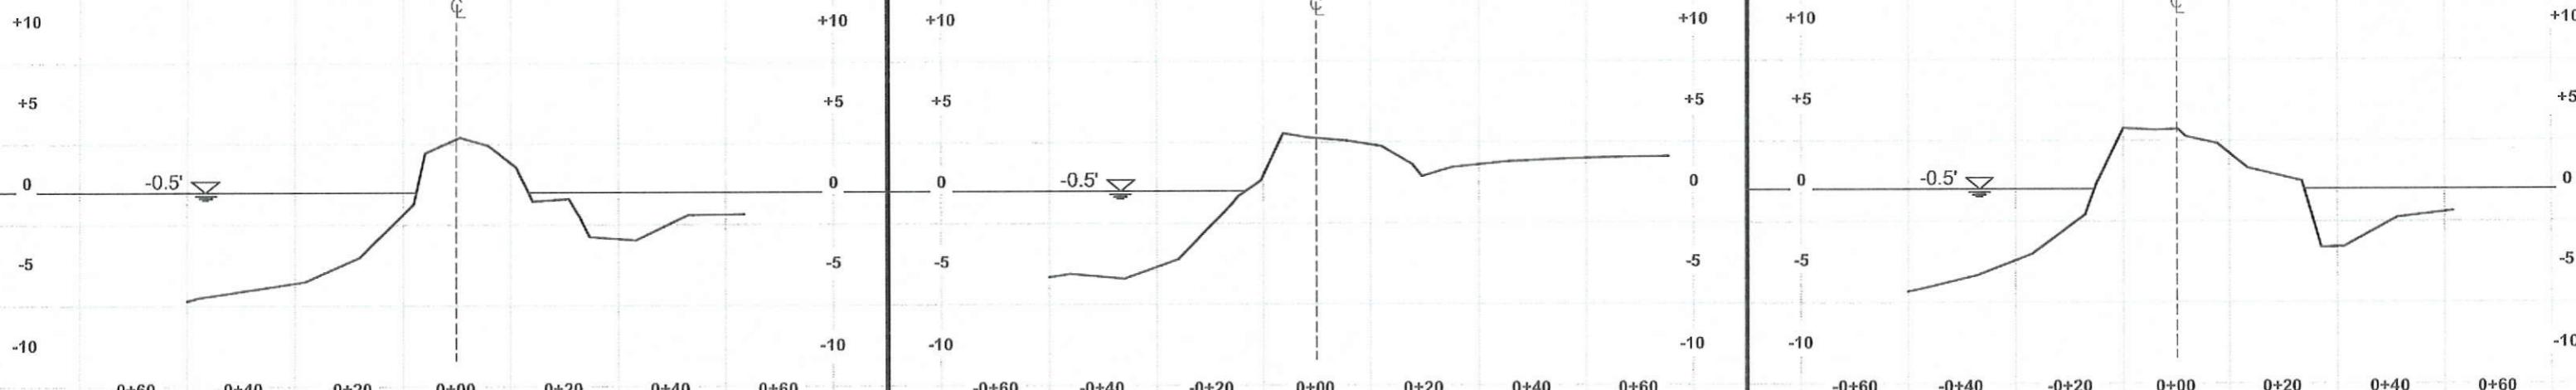

BREAKWATER #6 EAST SECTION

BREAKWATER #6 MID SECTION

BREAKWATER #6 WEST SECTION


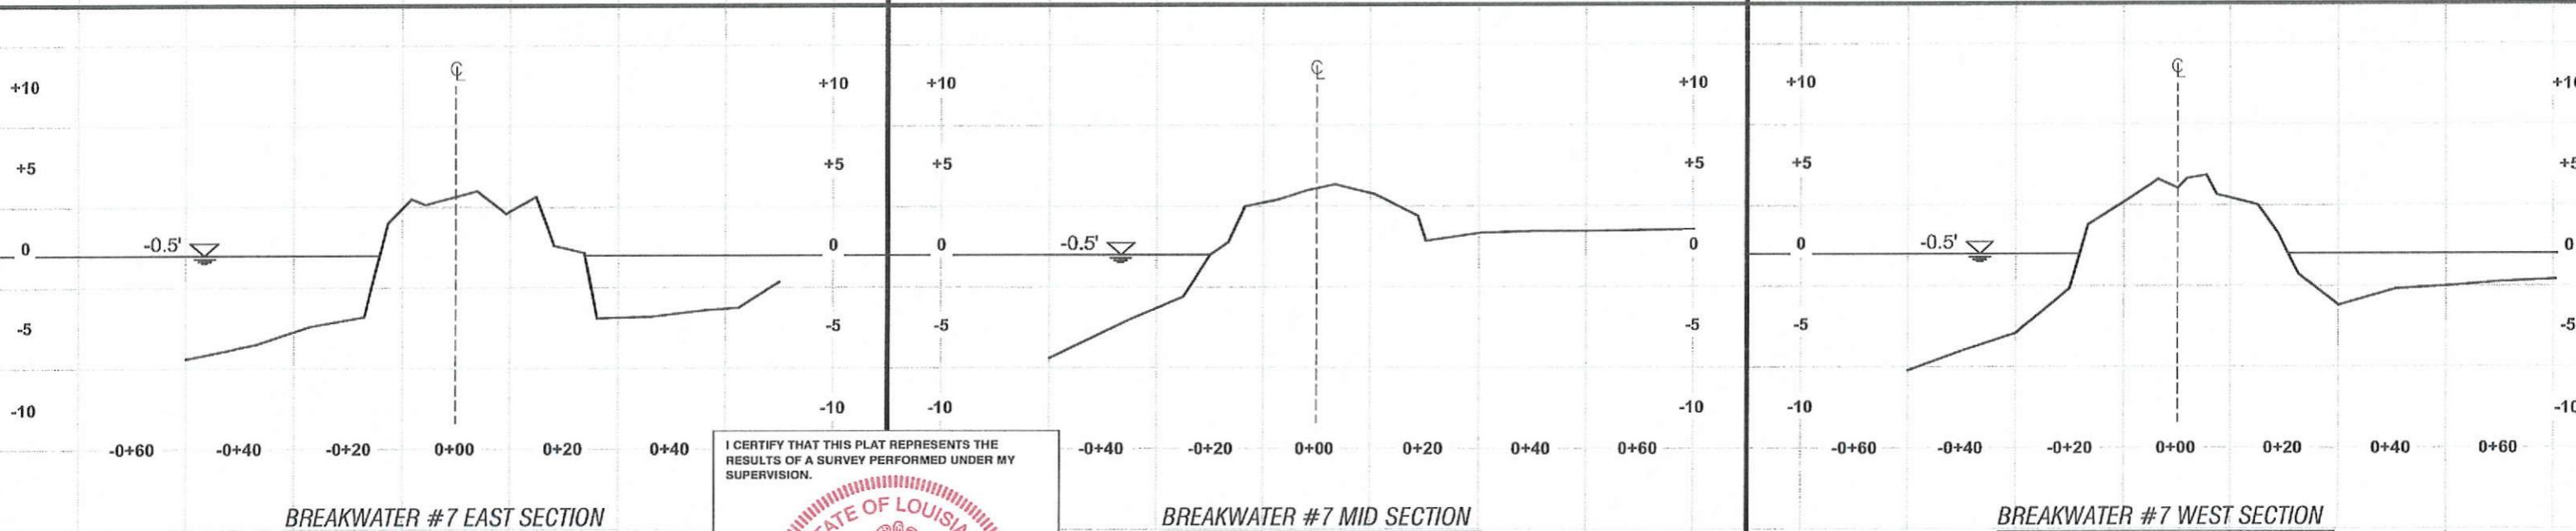


BREAKWATER #7 EAST SECTION

BREAKWATER #7 MID SECTION

BREAKWATER #7 WEST SECTION

5/5/2015 - P:\\Y-2015\\007\\0072\\DWG\\7-17\\150072X-SEC01.DWG

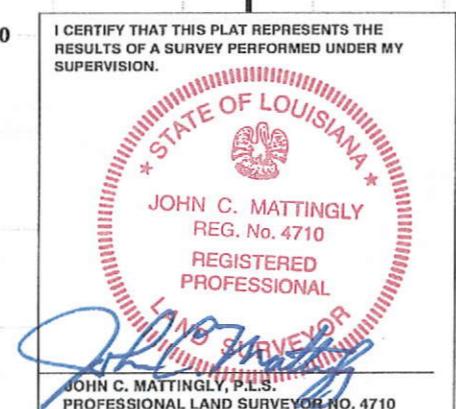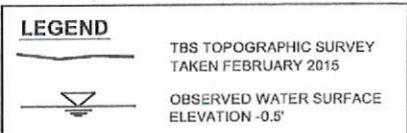

NOTES:



T. BAKER SMITH
SOLUTIONS START HERE
4100 Main Street, Houston, TX 77001
(281) 200-0000 | TBSMITH.COM

HORIZONTAL SCALE: 1" = 30'
30' 15' 0' 30'
VERTICAL SCALE: 1" = 10'
10' 5' 0' 10'

REV. NO: 00 REV. DATE: -/-/- REV. BY: ---








REVISION DESCRIPTION:
--

DRAWN BY:	A.W.S.	APPROVED BY:	K.S.B.
DATE:	5/5/2015	JOB NO:	2015.0072
DRAWING NAME:	7-17 150072X-SEC01.DWG		
PROJECTION:	LA83-SF-MOD		
GEO. DATUM:	NAD83 VERT. DATUM: NAVD88		
GRID UNITS:	US SURVEY FEET		
SHEET NO:	13	OF	22

BREAKWATER TRANSECTS

COASTAL PROTECTION AND RESTORATION AUTHORITY
TETRA TECH, INC.
RACCOON ISLAND SHORELINE PROTECTION/
MARSH CREATION (TE-48) PROJECT
BREAKWATER SURVEY
TERREBONNE PARISH, LOUISIANA

NOTE: ALL PROFILES SHOWN LOOKING WEST

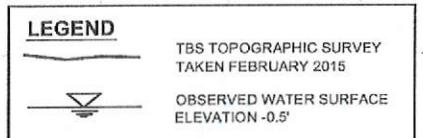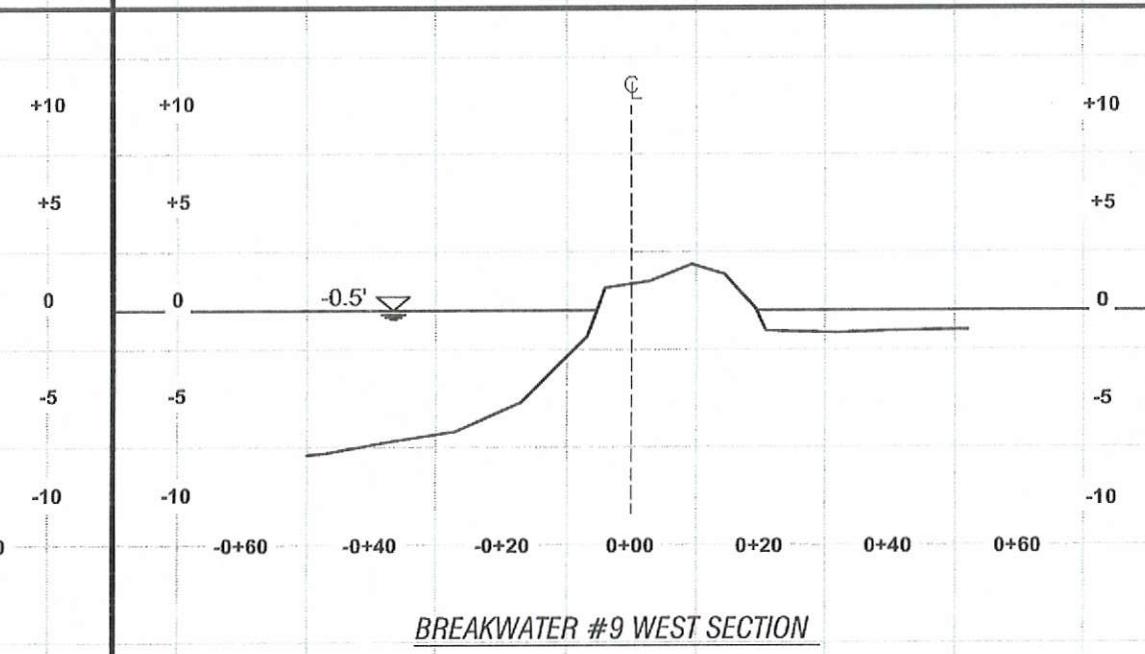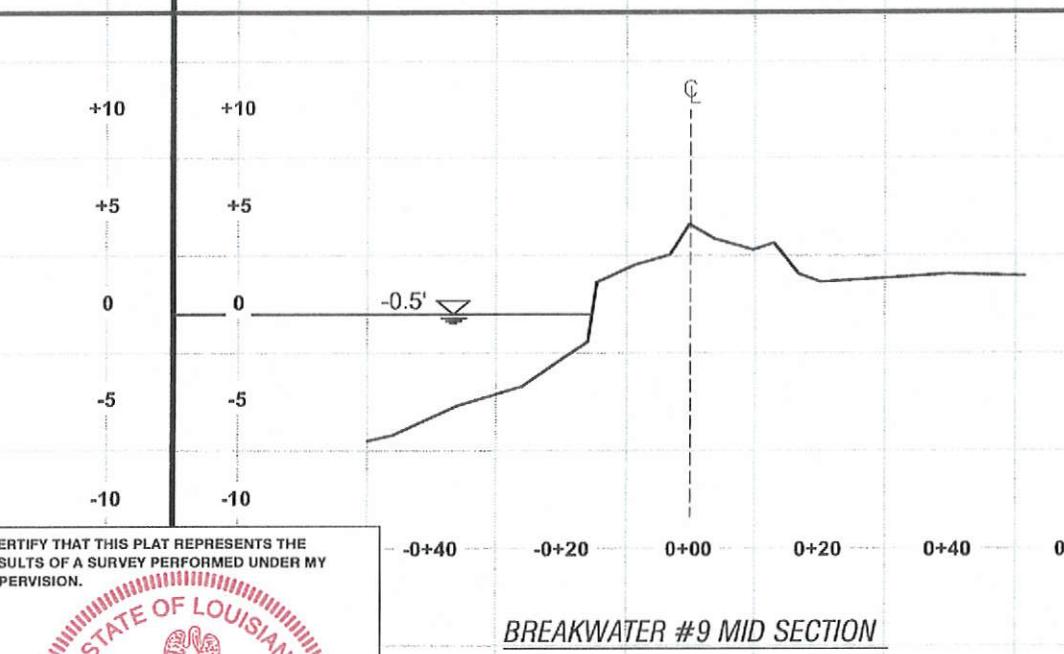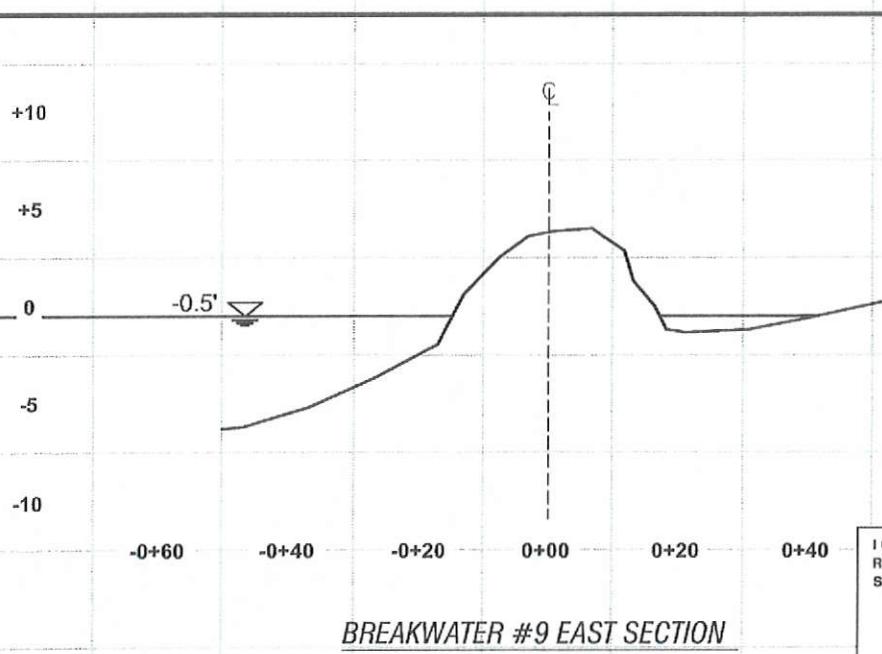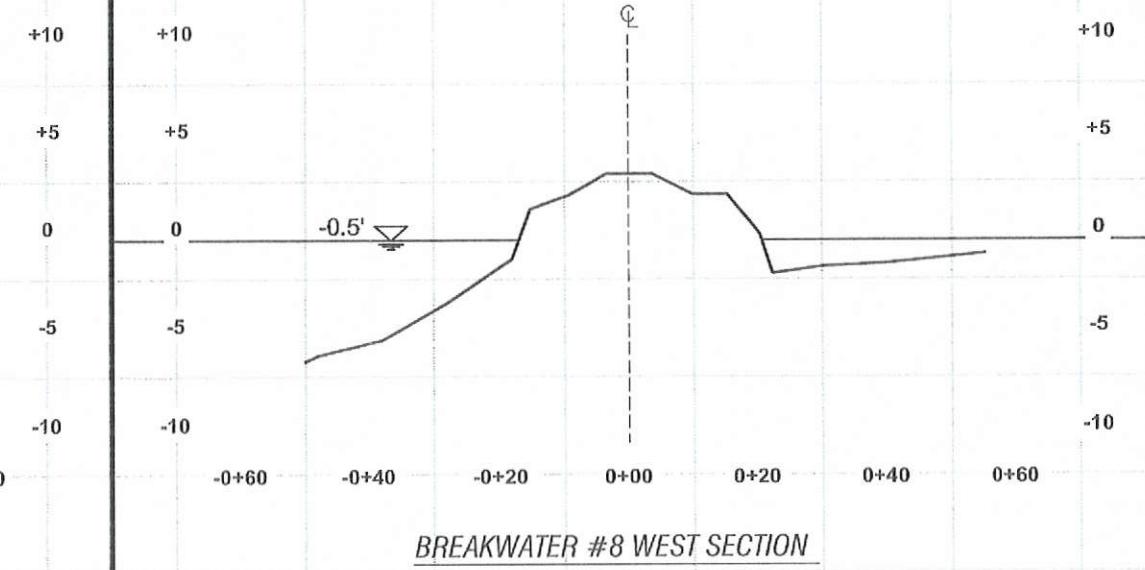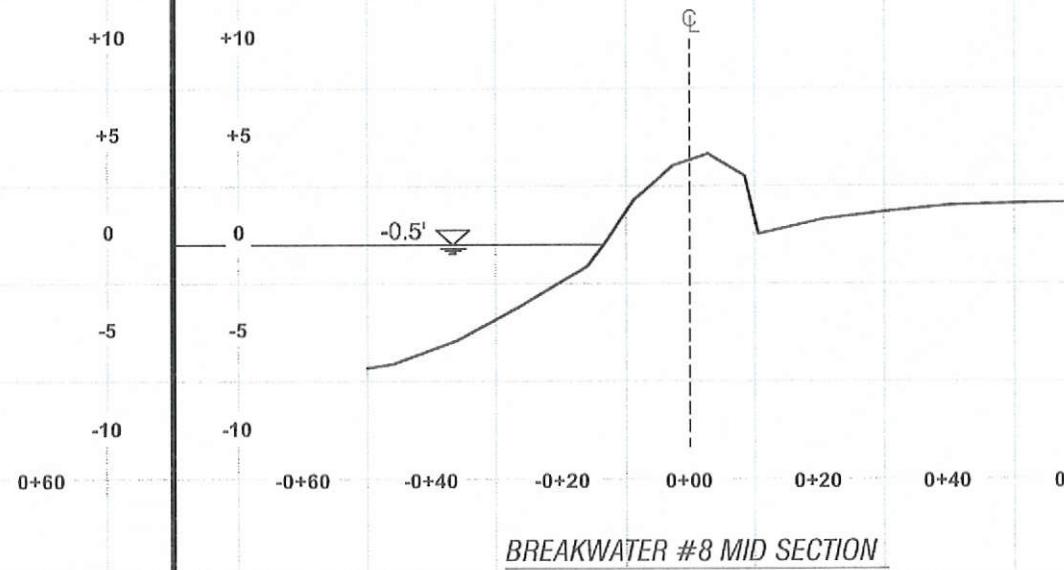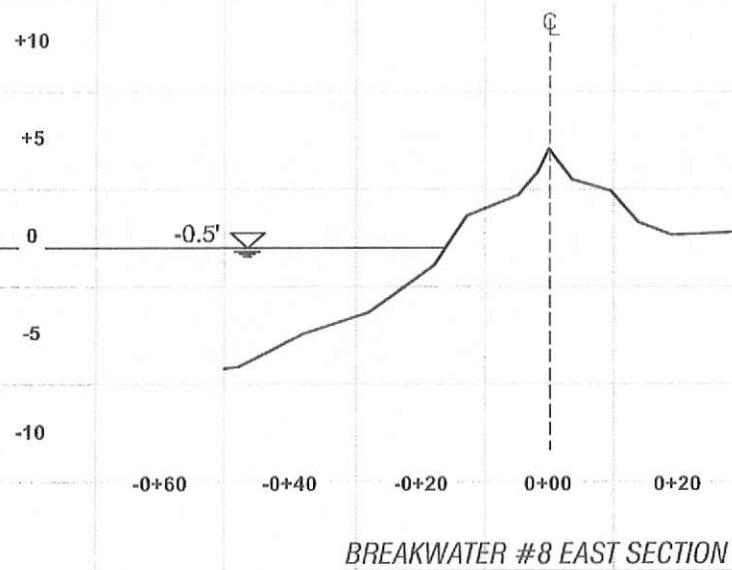

T. BAKER SMITH
SOLUTIONS START HERE
212 South Main Street, Houma, LA 70360
504.354.4560 | tbsmith.com

NOTES:


HORIZONTAL SCALE: 1" = 30'
30' 15' 0' 30'
VERTICAL SCALE: 1" = 10'
10' 5' 0' 10'
REV. NO: 00 REV. DATE: -/-/- REV. BY: ---
REVISION DESCRIPTION:
--

DRAWN BY: A.W.S. APPROVED BY: K.S.B.
DATE: 5/5/2015 JOB NO: 2015.0072
DRAWING NAME: 7-17 150072X-SEC01.DWG
PROJECTION: LA83-SF-MOD
GEO. DATUM: NAD83 | VERT. DATUM: NAVD88
GRID UNITS: US SURVEY FEET
SHEET NO: 14 OF 22

BREAKWATER TRANSECTS

COASTAL PROTECTION AND RESTORATION AUTHORITY
TETRA TECH, INC.
RACCOON ISLAND SHORELINE PROTECTION/
MARSH CREATION (TE-48) PROJECT
BREAKWATER SURVEY
TERREBONNE PARISH, LOUISIANA


NOTE: ALL PROFILES
SHOWN LOOKING WEST

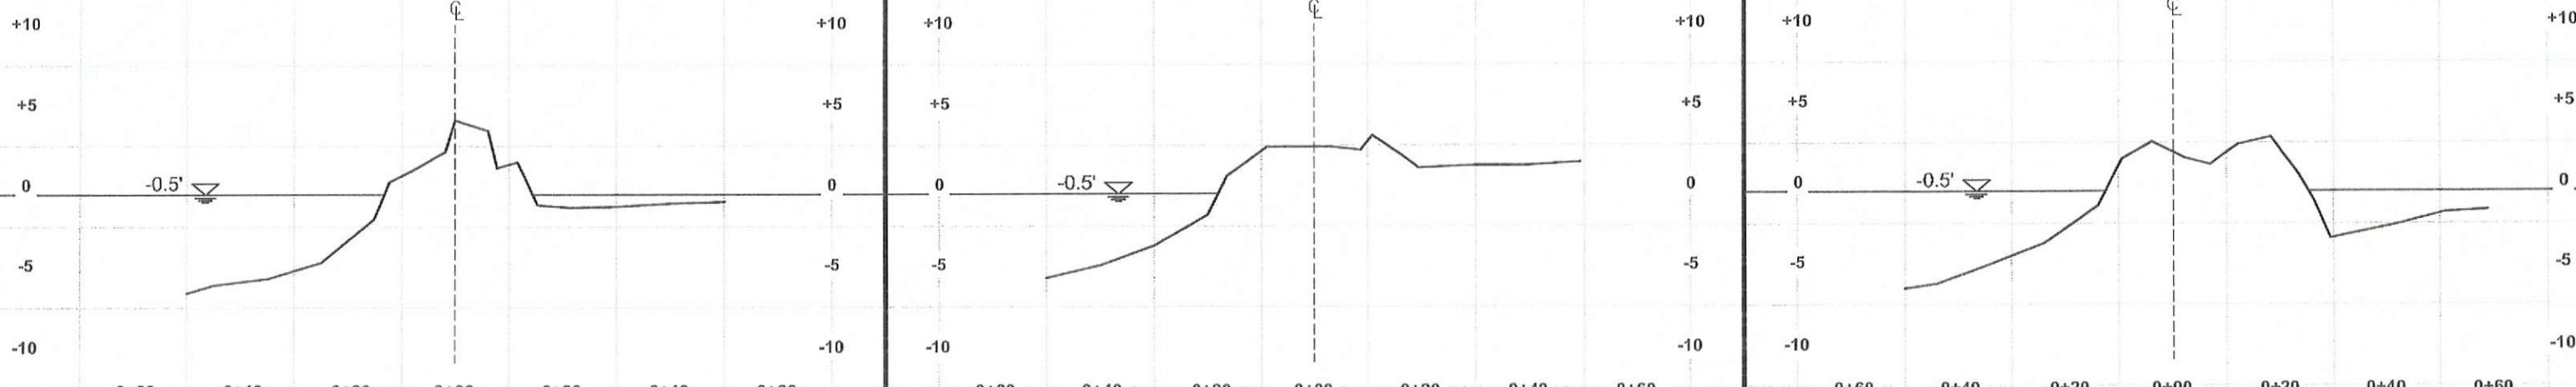

BREAKWATER #10 EAST SECTION

BREAKWATER #10 MID SECTION



BREAKWATER #10 WEST SECTION

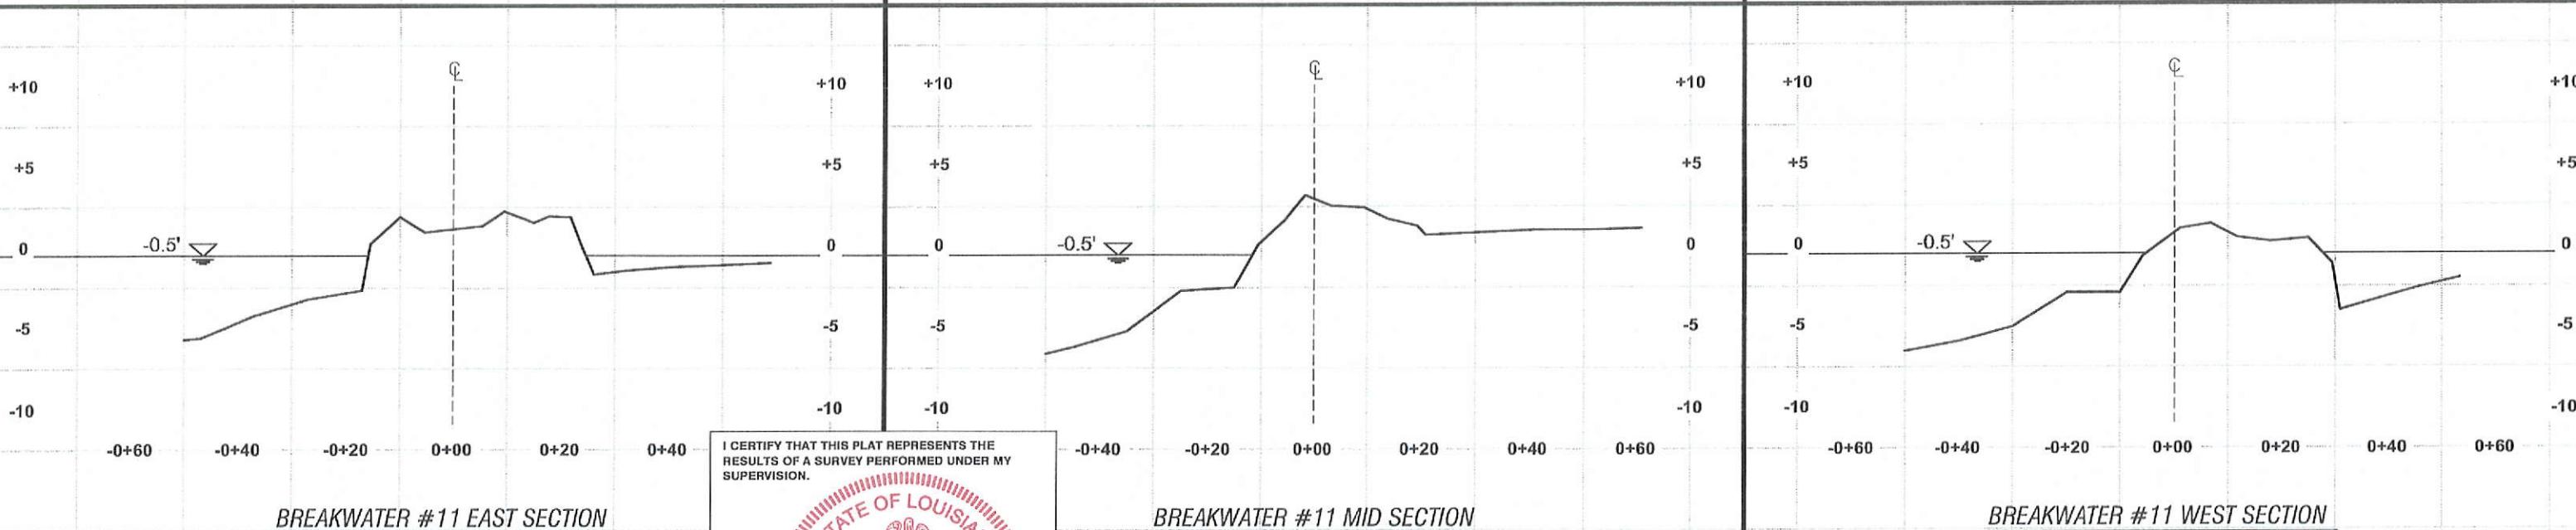

BREAKWATER #11 EAST SECTION

BREAKWATER #11 MID SECTION

BREAKWATER #11 WEST SECTION

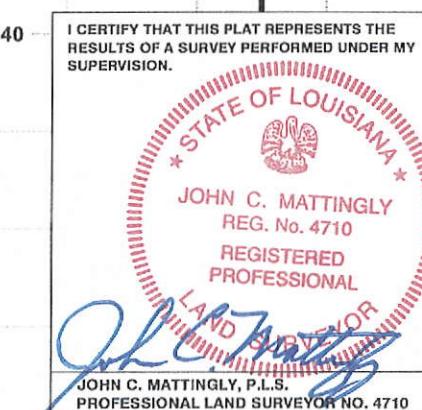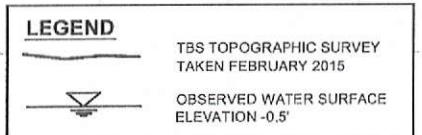

NOTES:



T. BAKER SMITH
SOLUTIONS START HERE
1125 Spring Hill Lane, Houma LA 70363
337.852.1000 | tbsolutions.com



HORIZONTAL SCALE: 1" = 30'
30' 15' 0' 30'
VERTICAL SCALE: 1" = 10'
10' 5' 0' 10'
REV. NO: 00 REV. DATE: -/-/- REV. BY: ---
REVISION DESCRIPTION: --

DRAWN BY: A.W.S. APPROVED BY: K.S.B.
DATE: 5/5/2015 JOB NO: 2015.0072
DRAWING NAME: 7-17 150072X-SEC01.DWG
PROJECTION: LA83-SF-MOD
GEO. DATUM: NAD83 | VERT. DATUM: NAVD88
GRID UNITS: US SURVEY FEET
SHEET NO: 15 OF 22

BREAKWATER TRANSECTS


COASTAL PROTECTION AND RESTORATION AUTHORITY
TETRA TECH, INC.
RACCOON ISLAND SHORELINE PROTECTION/
MARSH CREATION (TE-48) PROJECT
BREAKWATER SURVEY
TERREBONNE PARISH, LOUISIANA

NOTE: ALL PROFILES
SHOWN LOOKING WEST

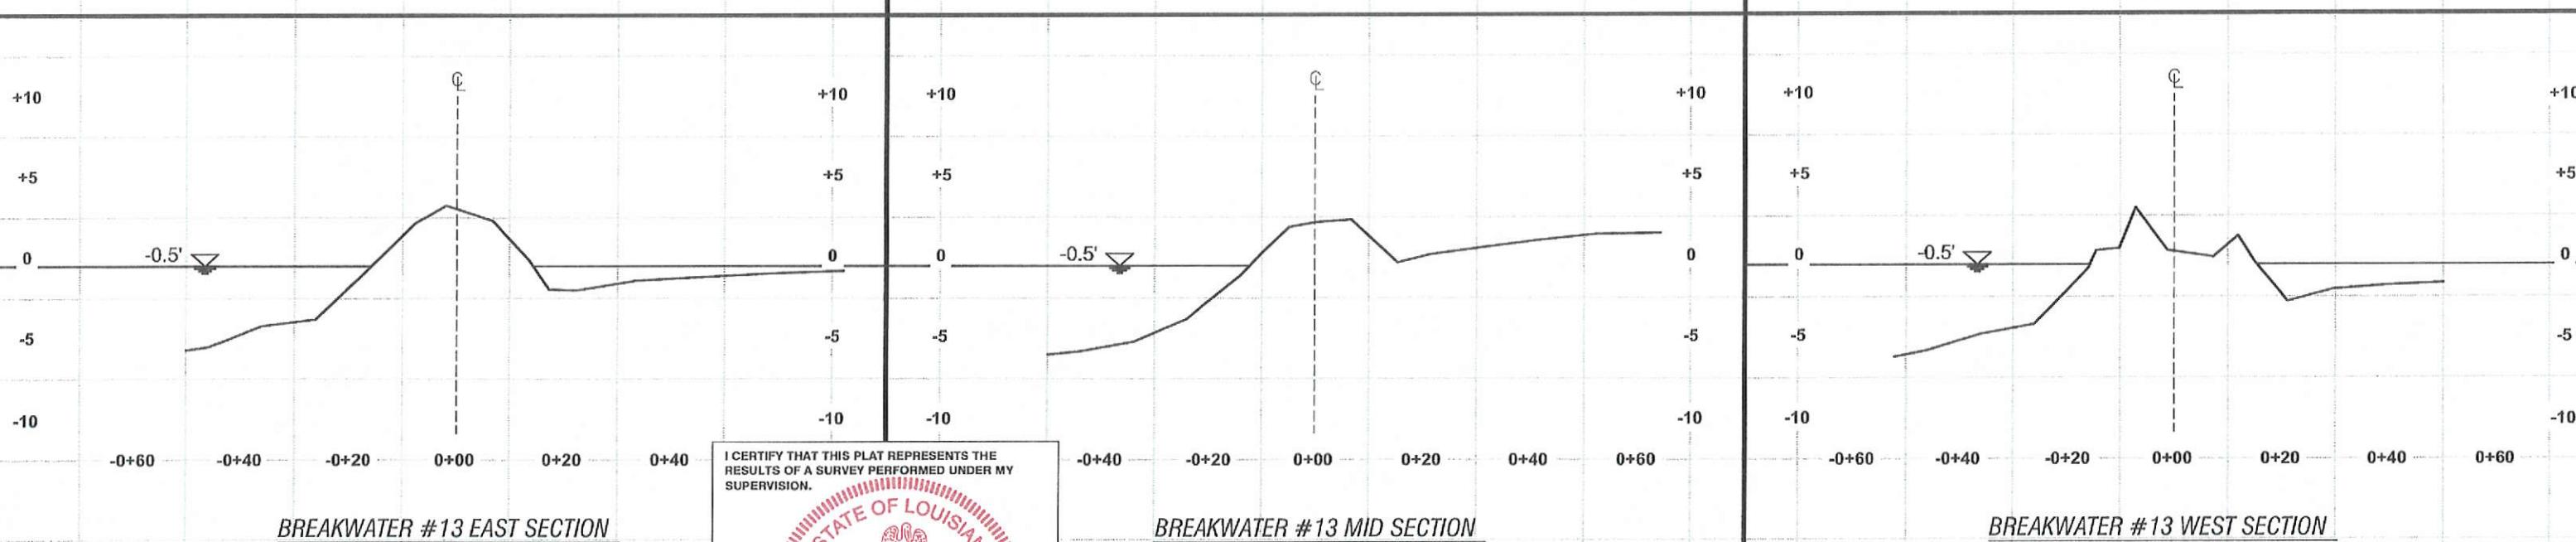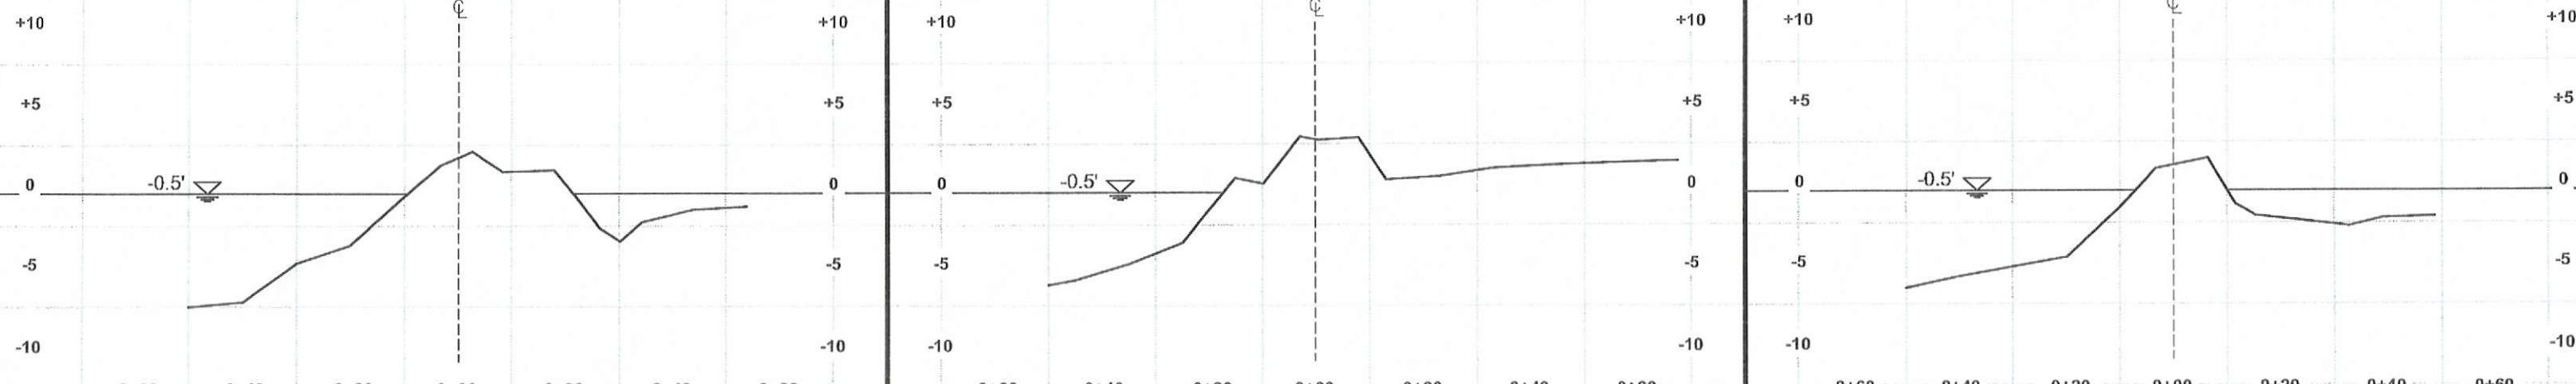

LEGEND

TBS TOPOGRAPHIC SURVEY
TAKEN FEBRUARY 2015
OBSERVED WATER SURFACE
ELEVATION -0.5'

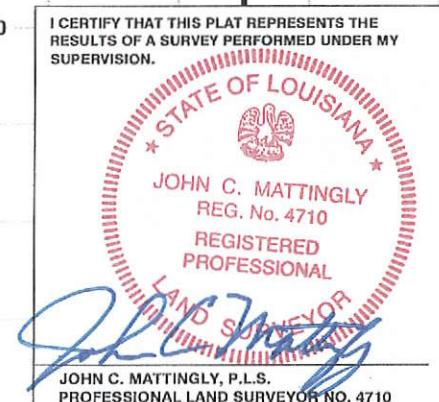

NOTES:



T. BAKER SMITH
SOLUTIONS START HERE
410 South Main St., Houma LA 70360
(337) 854-2440


HORIZONTAL SCALE: 1" = 30'
30' 15' 0' 30'
VERTICAL SCALE: 1" = 10'
10' 5' 0' 10'
REV. NO: 00 REV. DATE: / / REV. BY: / /
REVISION DESCRIPTION: / /

DRAWN BY: A.W.S. APPROVED BY: K.S.B.
DATE: 5/5/2015 JOB NO: 2015.0072
DRAWING NAME: 7-17_150072X-SEC01.DWG
PROJECTION: LA83-SF-MOD
GEO. DATUM: NAD83 | VERT. DATUM: NAVD88
GRID UNITS: US SURVEY FEET
SHEET NO: 16 OF 22

BREAKWATER TRANSECTS

COASTAL PROTECTION AND RESTORATION AUTHORITY
TETRA TECH, INC.
RACCOON ISLAND SHORELINE PROTECTION/
MARSH CREATION (TE-48) PROJECT
BREAKWATER SURVEY
TERREBONNE PARISH, LOUISIANA


NOTE: ALL PROFILES
SHOWN LOOKING WEST

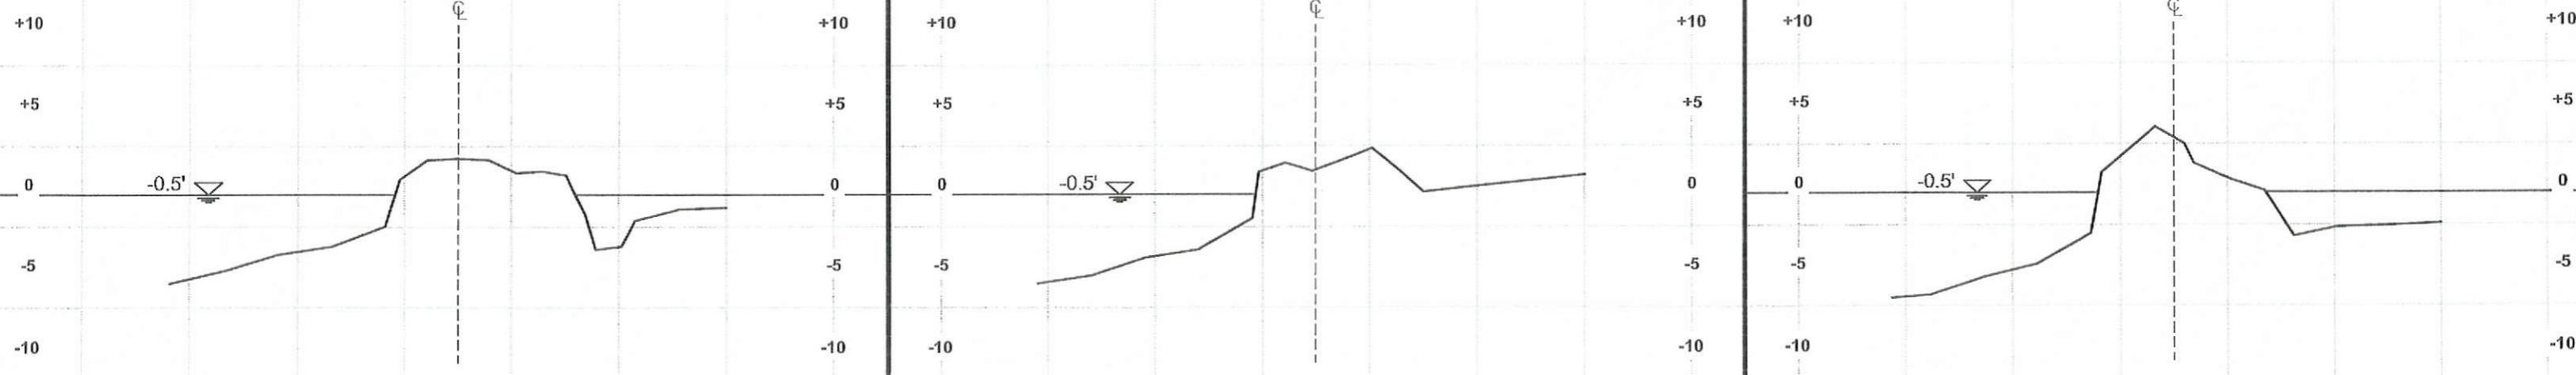

BREAKWATER #14 EAST SECTION

BREAKWATER #14 MID SECTION

BREAKWATER #14 WEST SECTION

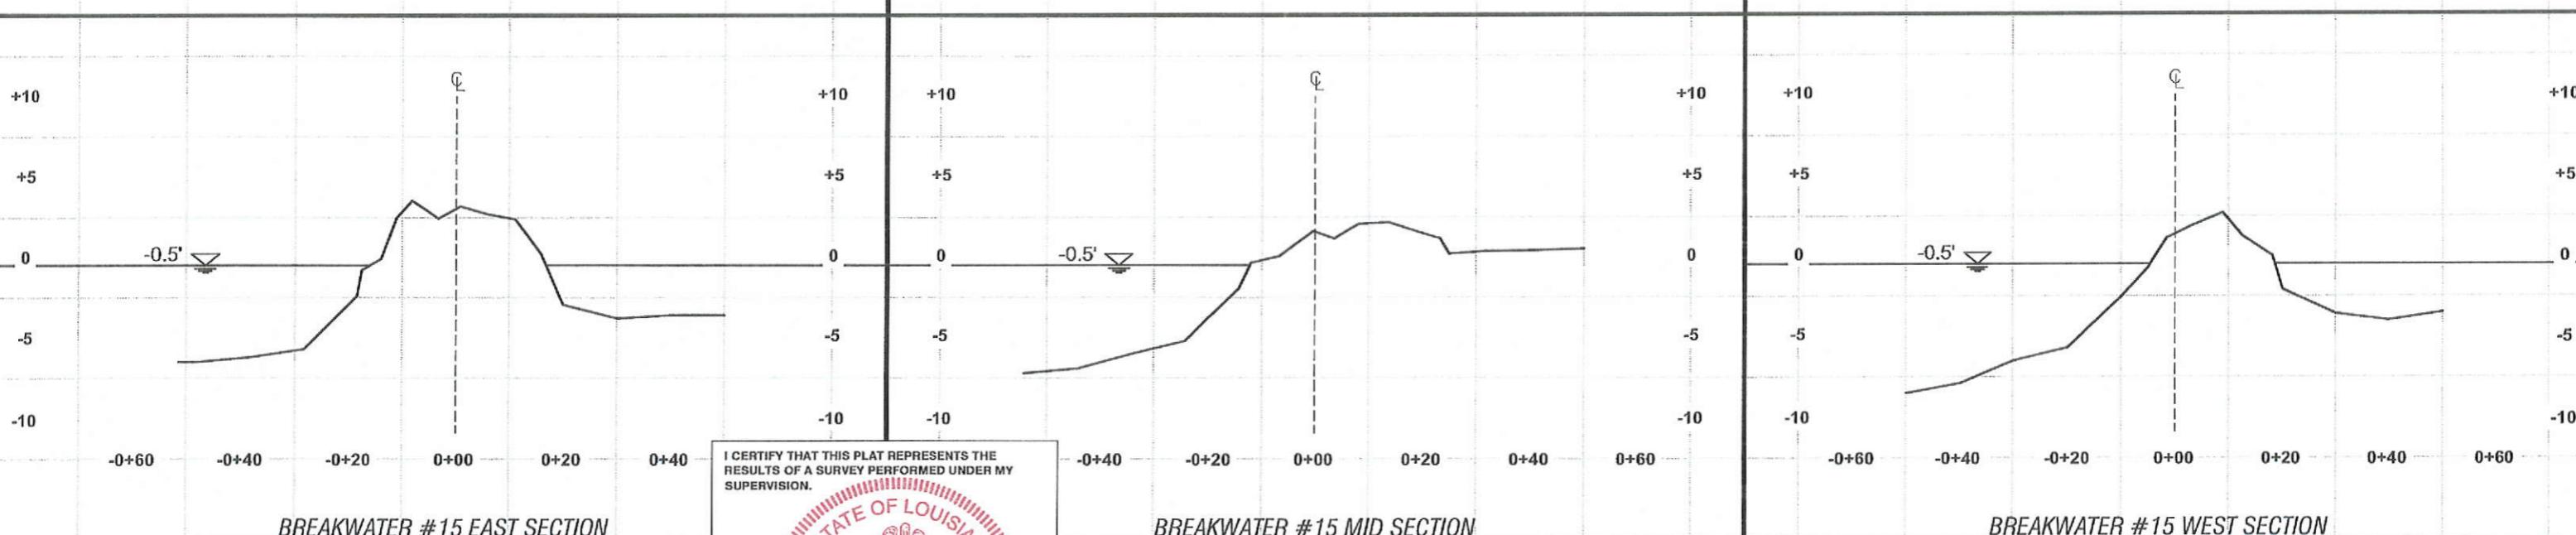

BREAKWATER #15 EAST SECTION

BREAKWATER #15 MID SECTION


BREAKWATER #15 WEST SECTION

LEGEND

TBS TOPOGRAPHIC SURVEY
TAKEN FEBRUARY 2015
OBSERVED WATER SURFACE
ELEVATION -0.5'



T. BAKER SMITH
SOLUTIONS START HERE
416 South Main Street, Houma, LA 70360
504-441-1100 | tbsolutions.com

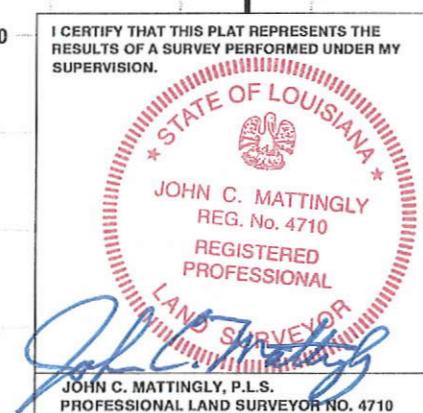

NOTES:

HORIZONTAL SCALE: 1" = 30'

30' 15' 0' 30'

VERTICAL SCALE: 1" = 10'

10' 5' 0' 10'

REV. NO: 00 REV. DATE: --- REV. BY: ---

REVISION DESCRIPTION: --

DRAWN BY: A.W.S. APPROVED BY: K.S.B.

DATE: 5/5/2015 JOB NO: 2015.0072

DRAWING NAME: 7-17_150072X-SEC01.DWG

PROJECTION: LA83-SF-MOD

GEO. DATUM: NAD83 | VERT. DATUM: NAVD88





GRID UNITS: US SURVEY FEET

SHEET NO: 17 OF 22

BREAKWATER TRANSECTS

COASTAL PROTECTION AND RESTORATION AUTHORITY
TETRA TECH, INC.
RACCOON ISLAND SHORELINE PROTECTION/
MARSH CREATION (TE-48) PROJECT
BREAKWATER SURVEY
TERREBONNE PARISH, LOUISIANA

NOTE: PROFILE SHOWN
LOOKING NORTH

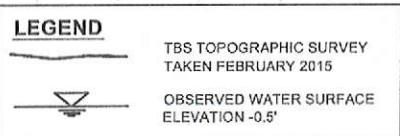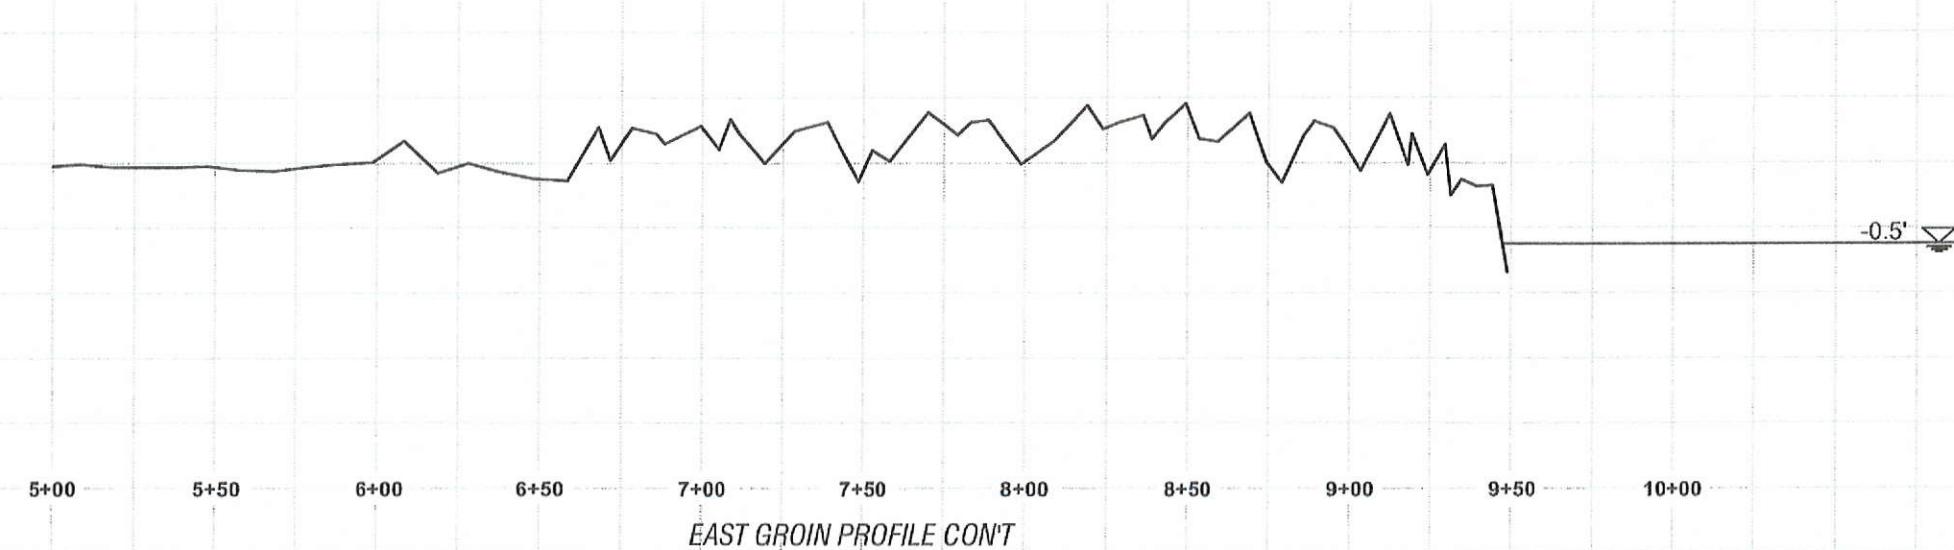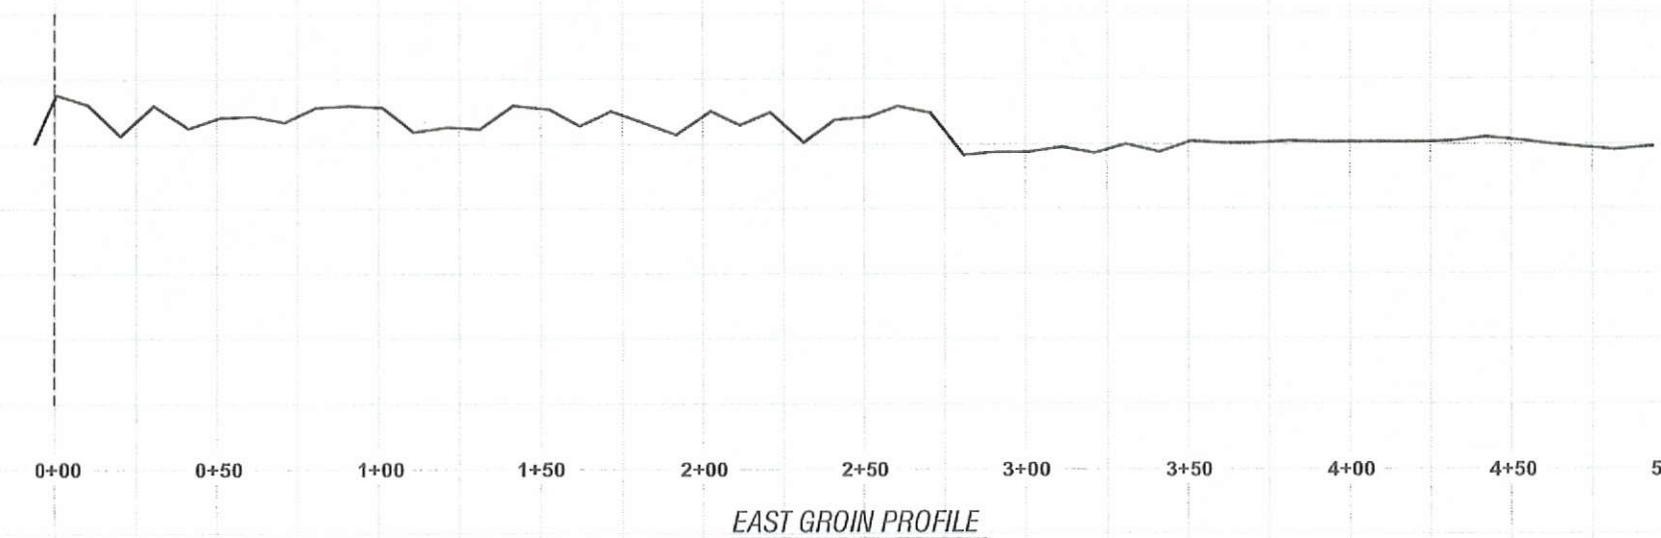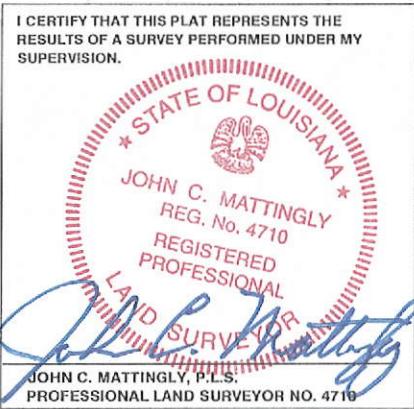

5/5/2015 - PIY-2015-0072/DWG18-22 PROFILES.DWG

NOTES:



T. BAKER SMITH

SOLUTIONS START HERE
Call 800.858.1000 or visit www.tbs.com

HORIZONTAL SCALE: 1" = 60'
60' 30' 0' 60'
VERTICAL SCALE: 1" = 6'
6' 3' 0' 6'







REV. NO: 00 REV. DATE: --- REV. BY: ---

REVISION DESCRIPTION:
--

DRAWN BY: JMC APPROVED BY: JCM
DATE: 5/5/2015 JOB NO: 2015.0072
DRAWING NAME: 18-22 PROFILES.DWG
PROJECTION: LA83-SF-MOD
GEO. DATUM: NAD83 | VERT. DATUM: NAVD88
GRID UNITS: US SURVEY FEET
SHEET NO: 18 OF 22

EAST GROIN PROFILE

COASTAL PROTECTION AND RESTORATION AUTHORITY
TETRA TECH, INC.
RACCOON ISLAND SHORELINE PROTECTION/
MARSH CREATION (TE-48) PROJECT
BREAKWATER SURVEY
TERREBONNE PARISH, LOUISIANA

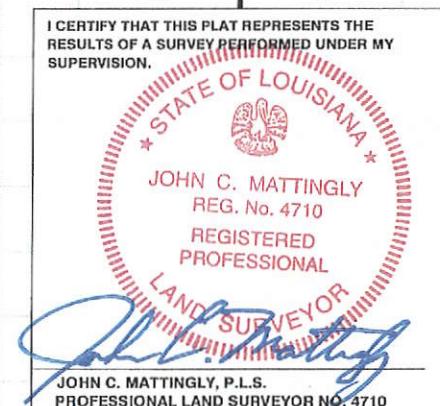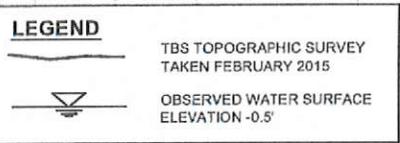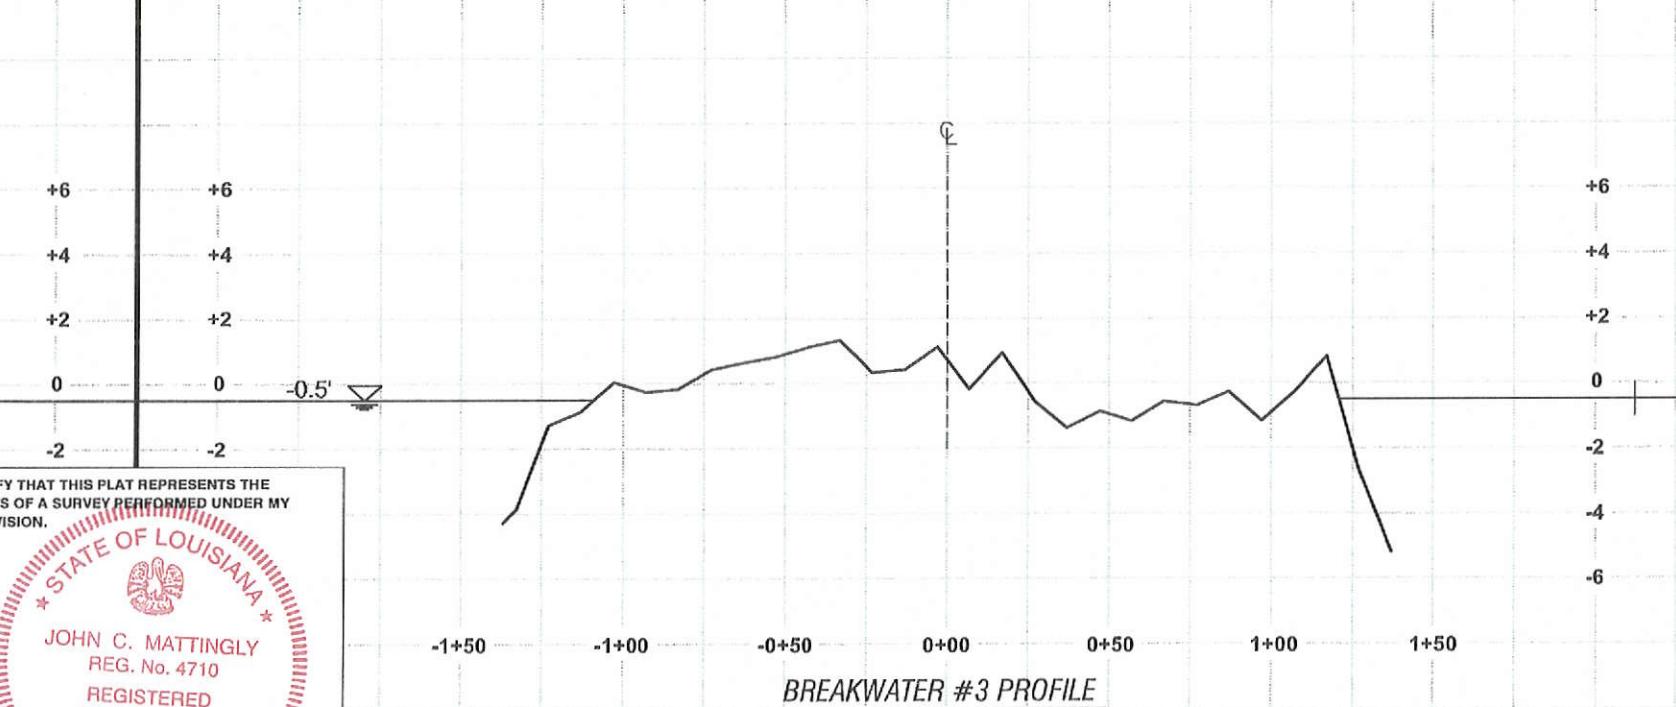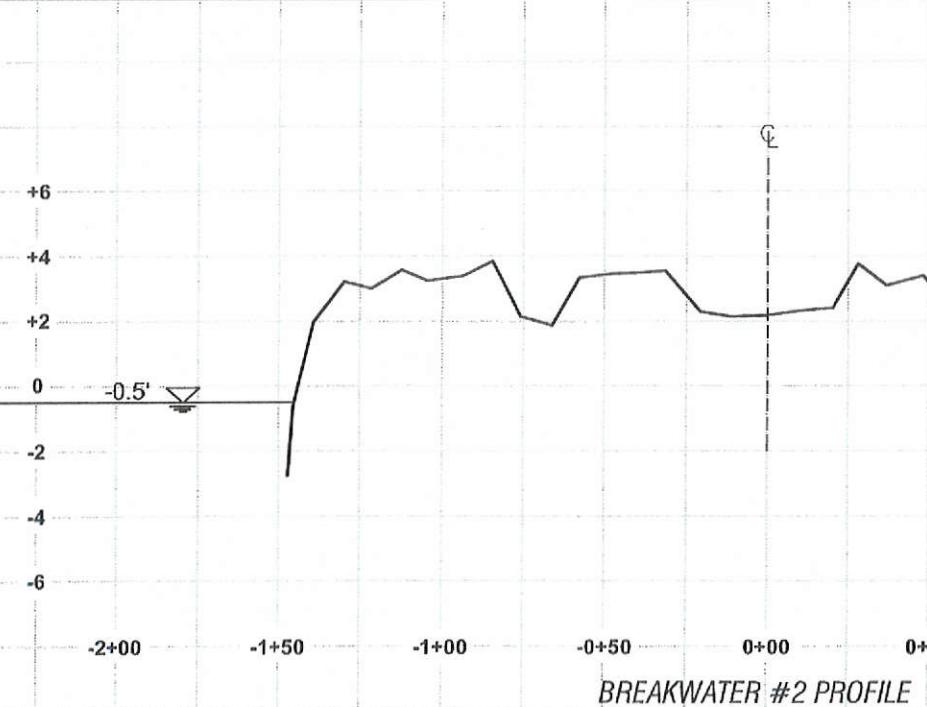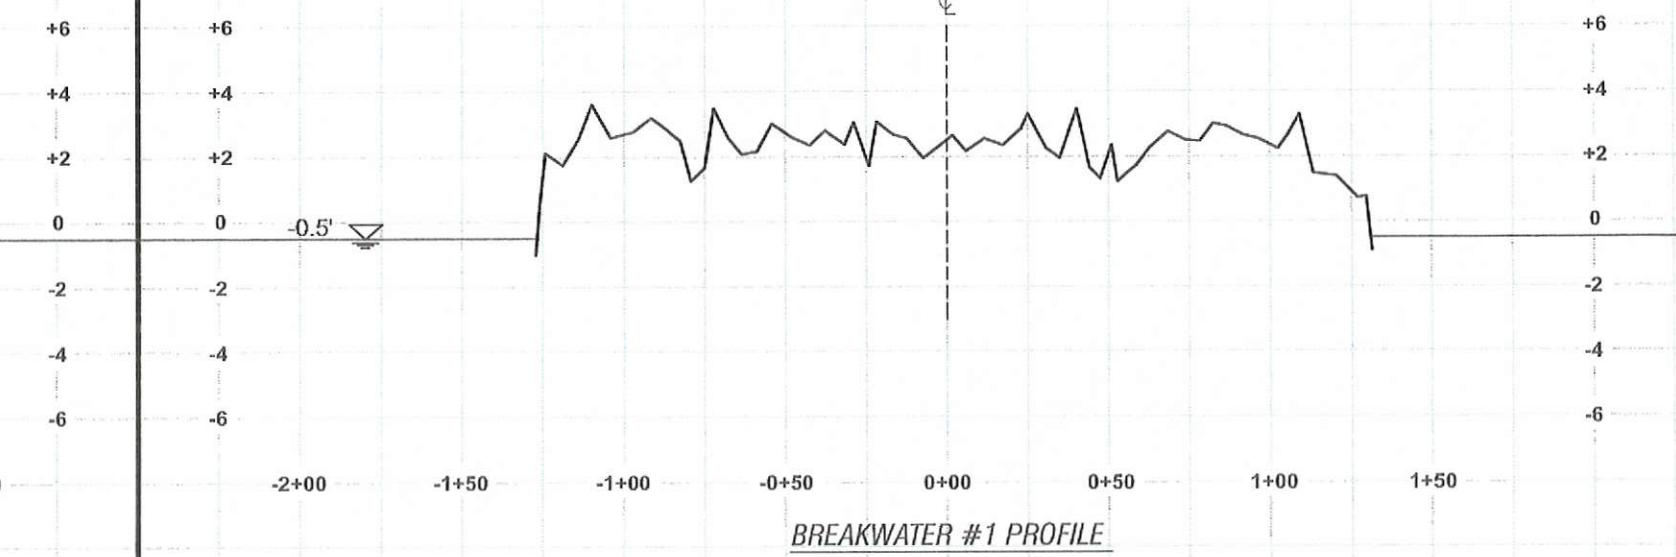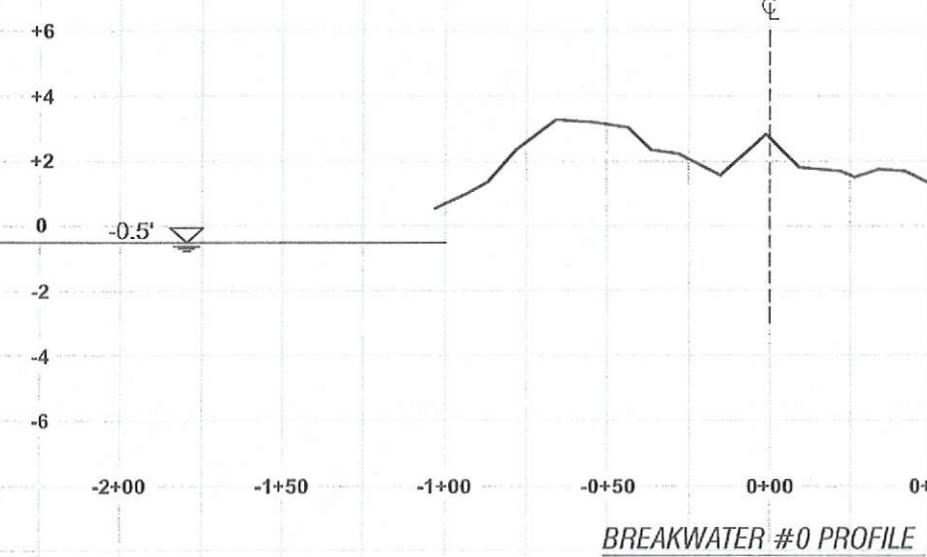


T. BAKER SMITH
SOLUTIONS START HERE
219 South 7th Street, Baton Rouge, LA 70801
(225) 342-1000 | tbs.tetra.com

HORIZONTAL SCALE: 1" = 60'
60' 30' 0' 60'
VERTICAL SCALE: 1" = 6'
6' 3' 0' 6'
REV. NO: 00 REV. DATE: -/-/- REV. BY: ---
REVISION DESCRIPTION:
--


DRAWN BY: JMC APPROVED BY: JCM
DATE: 5/5/2015 JOB NO: 2015.0072
DRAWING NAME: 18-22 PROFILES.DWG
PROJECTION: LA83-SF-MOD
GEO. DATUM: NAD83 | VERT. DATUM: NAVD88
GRID UNITS: US SURVEY FEET
SHEET NO: 19 OF 22

BREAKWATER PROFILES


COASTAL PROTECTION AND RESTORATION AUTHORITY
TETRA TECH, INC.
RACCOON ISLAND SHORELINE PROTECTION/
MARSH CREATION (TE-48) PROJECT
BREAKWATER SURVEY
TERREBONNE PARISH, LOUISIANA

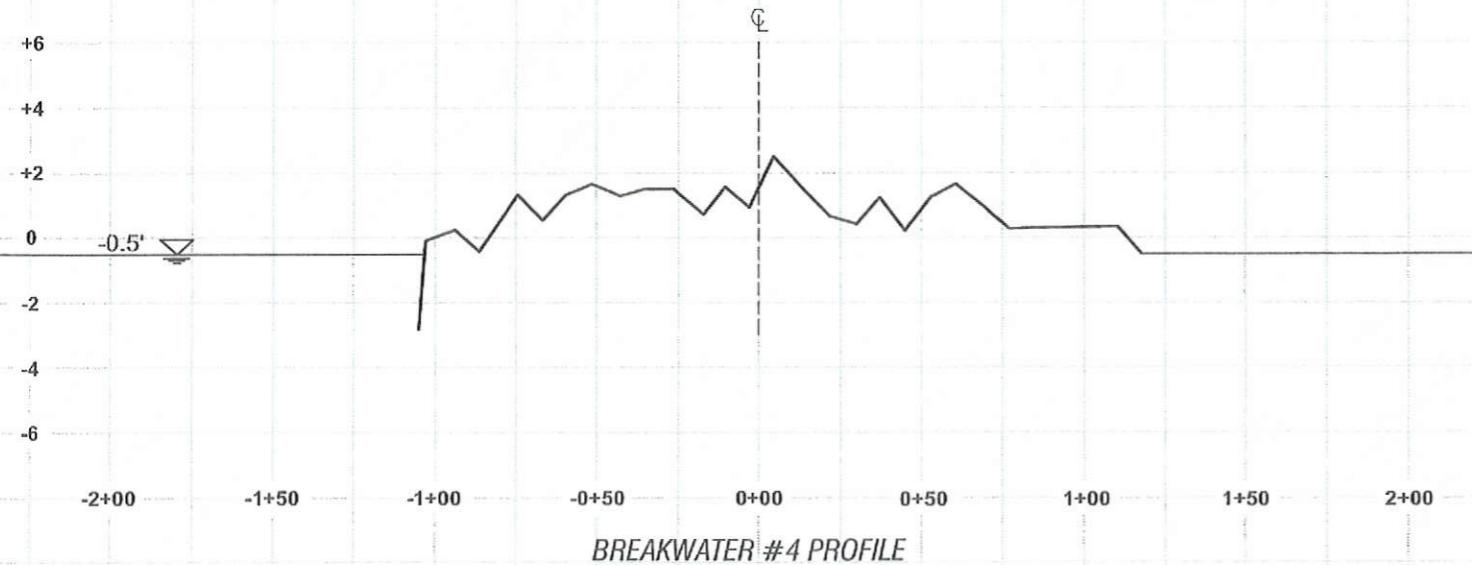


BREAKWATER #4 PROFILE

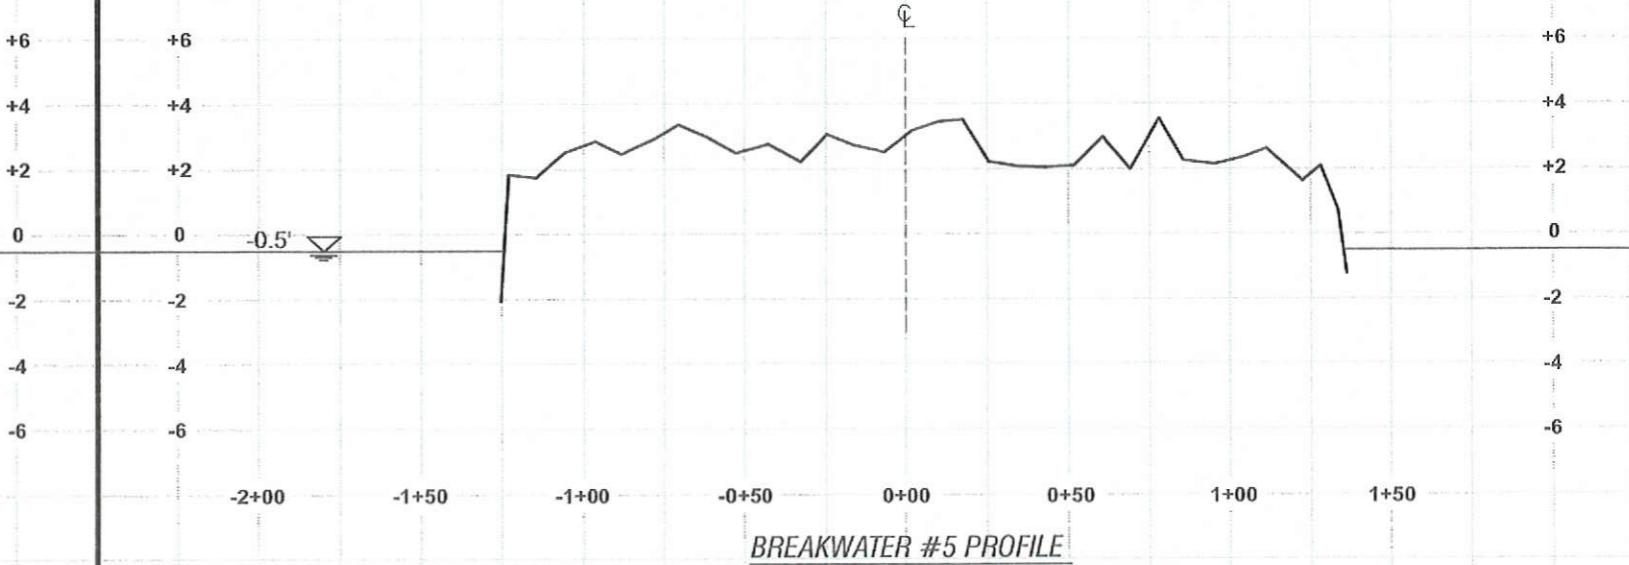

BREAKWATER #5 PROFILE

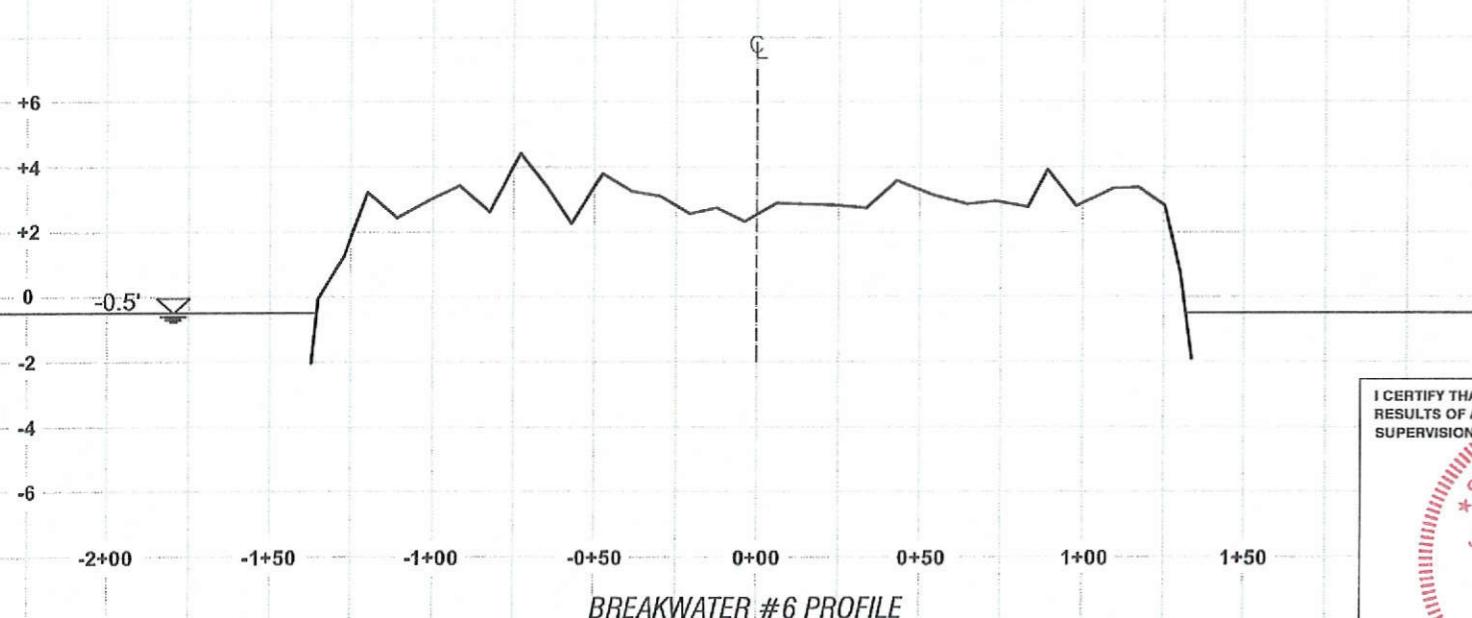

BREAKWATER #6 PROFILE

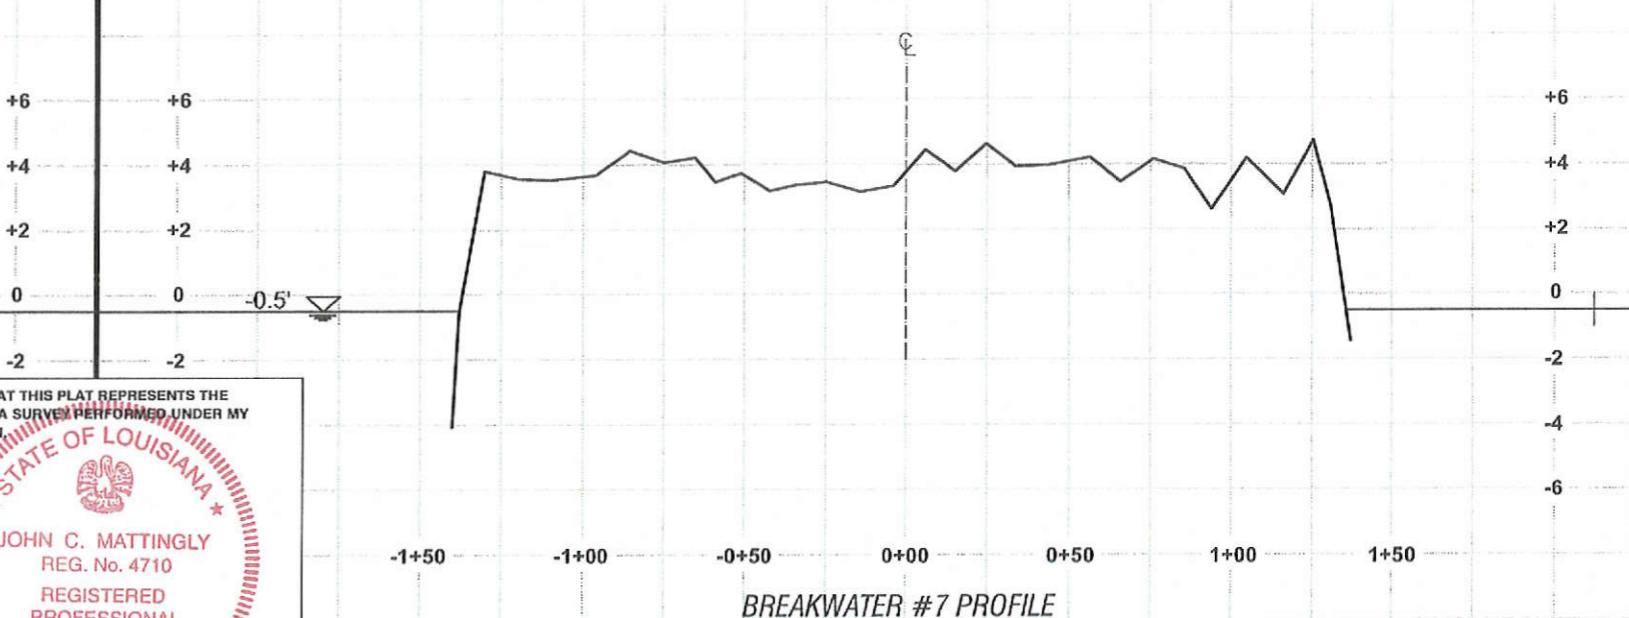

BREAKWATER #7 PROFILE

LEGEND

TBS TOPOGRAPHIC SURVEY
TAKEN FEBRUARY 2015

OBSERVED WATER SURFACE
ELEVATION -0.5'



T. BAKER SMITH
SOLUTIONS START HERE
11 South Main Ave., Monroe, LA 71201
(318) 384-2111

卷之三

NOTES

The stamp is circular with a red border containing the text "STATE OF LOUISIANA". Inside the border, at the top, is the phrase "I CERTIFY THAT THIS PLAT REPRESENTS THE RESULTS OF A SURVEY PERFORMED UNDER MY SUPERVISION." The center of the stamp features a detailed emblem of a pelican feeding its young. Below the emblem, the name "JOHN C. MATTINGLY" is printed in capital letters, followed by "REG. No. 4710". Underneath that, it says "REGISTERED PROFESSIONAL". At the bottom of the stamp, the words "LAND SURVEYOR" are written diagonally across the bottom right corner. A large, blue, handwritten signature of "John C. Mattingly" is overlaid on the bottom left of the stamp. Below the stamp, the text "JOHN C. MATTINGLY, P.L.S." and "PROFESSIONAL LAND SURVEYOR NO. 4710" is printed in capital letters.







HORIZONTAL SCALE: 1" = 60'
60' 30' 0' 60'
VERTICAL SCALE: 1" = 6'
6' 3' 0' 6'
O: 00 REV. DATE: ___/___/___ REV. BY: ___

DRAWN BY:	JMC	APPROVED BY:	JC
DATE:	5/5/2015	JOB NO:	2015.007
DRAWING NAME:	18-22 PROFILES.DWG		
PROJECTION:	LA83-SF-MOD		
E.O. DATUM:	NAD83 VERT. DATUM: NAVD88		
GRID UNITS:	US SURVEY FEET		
SHEET NO:	20	OF	22

BREAKWATER PROFILES

COASTAL PROTECTION AND RESTORATION AUTHORITY
TETRA TECH, INC.
RACCOON ISLAND SHORELINE PROTECTION/
MARSH CREATION (TE-48) PROJECT
BREAKWATER SURVEY
TERREBONNE PARISH, LOUISIANA

NOTE: ALL PROFILES
SHOWN LOOKING NORTH

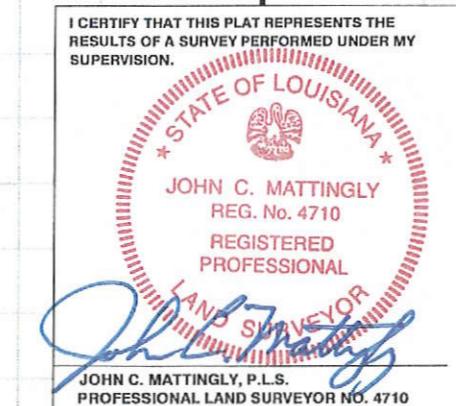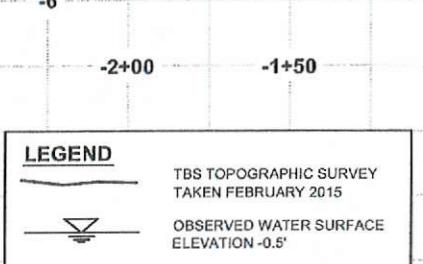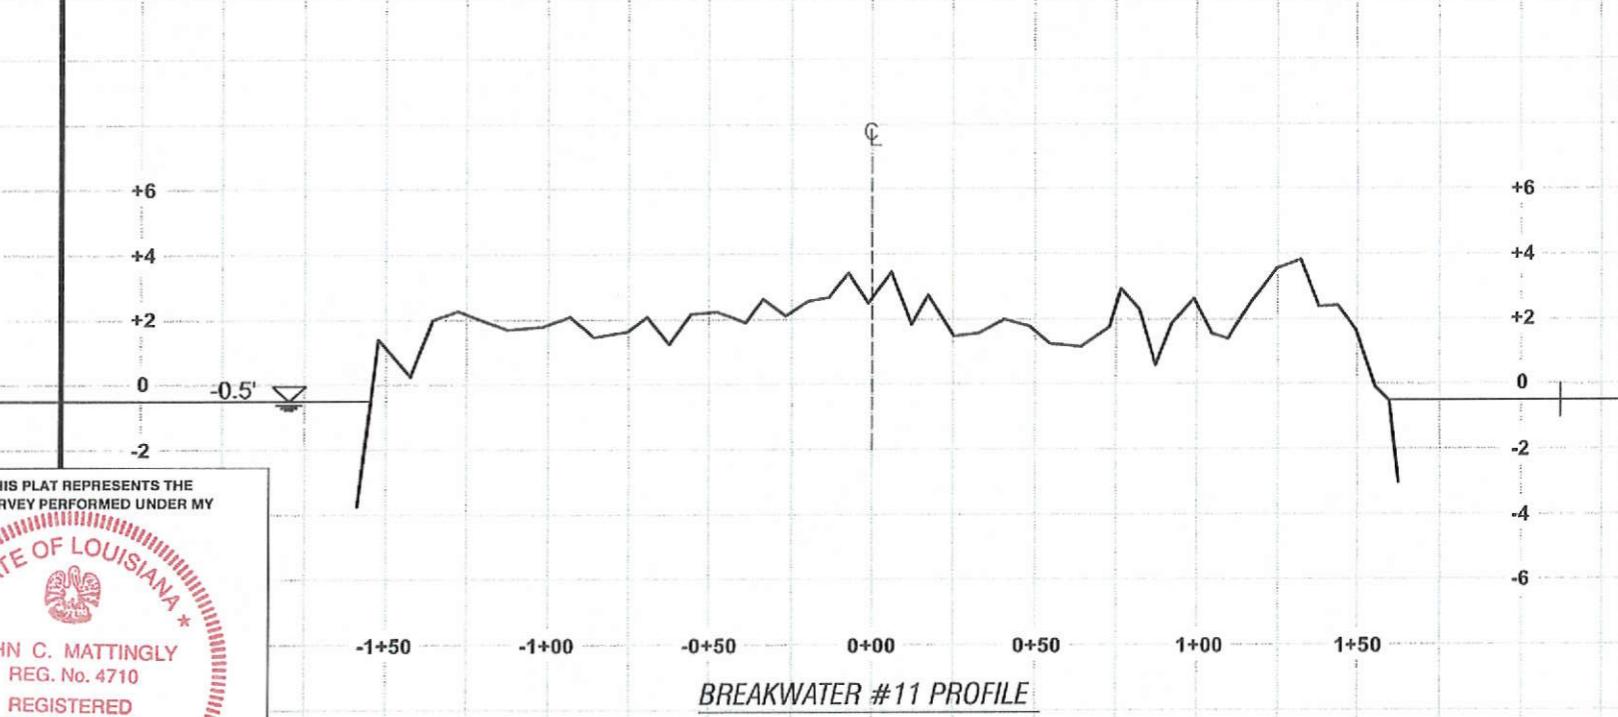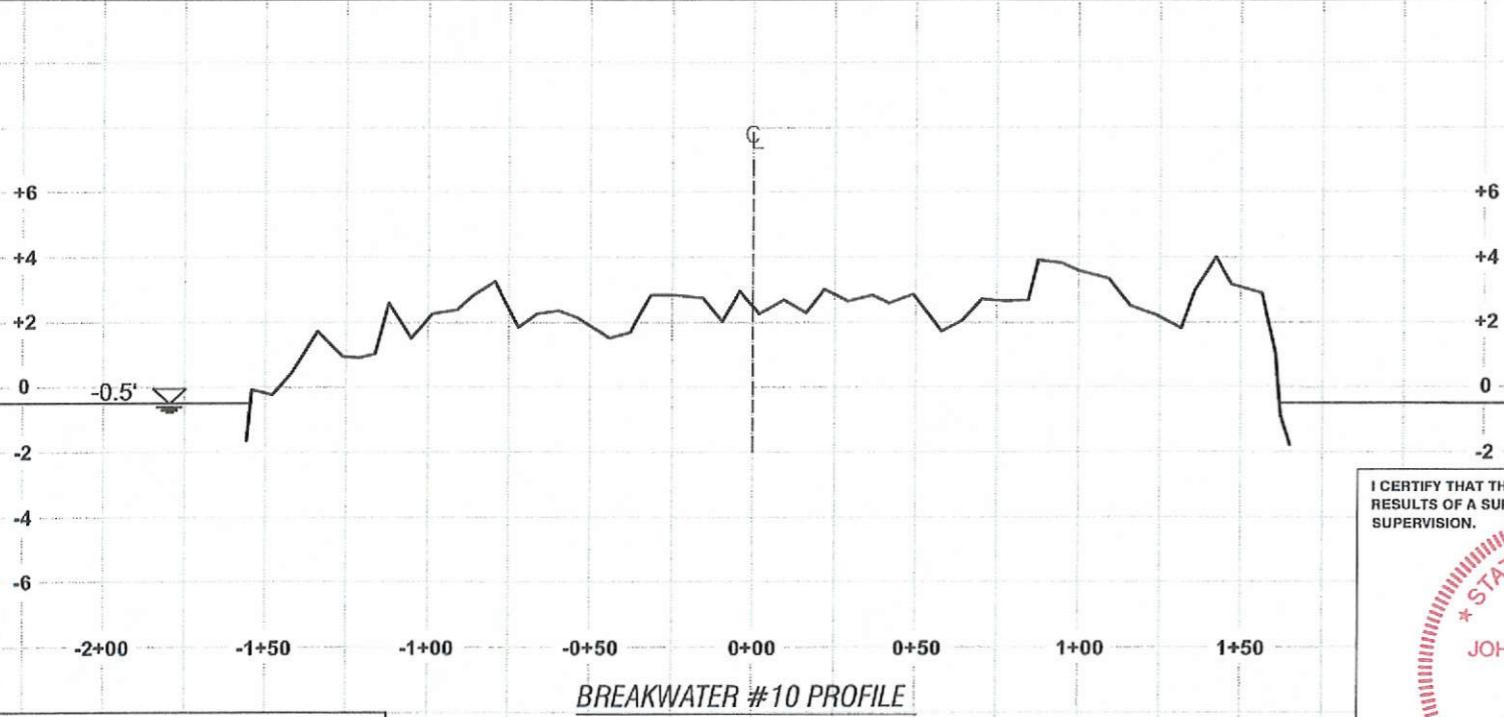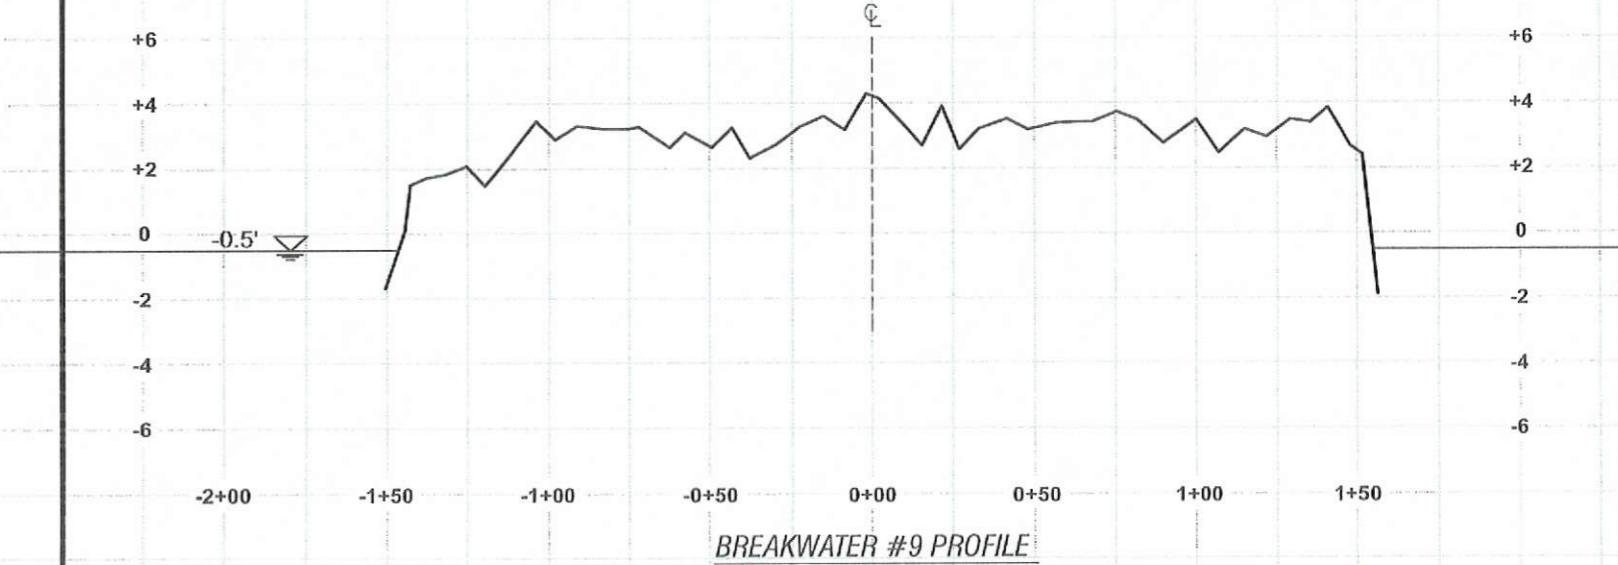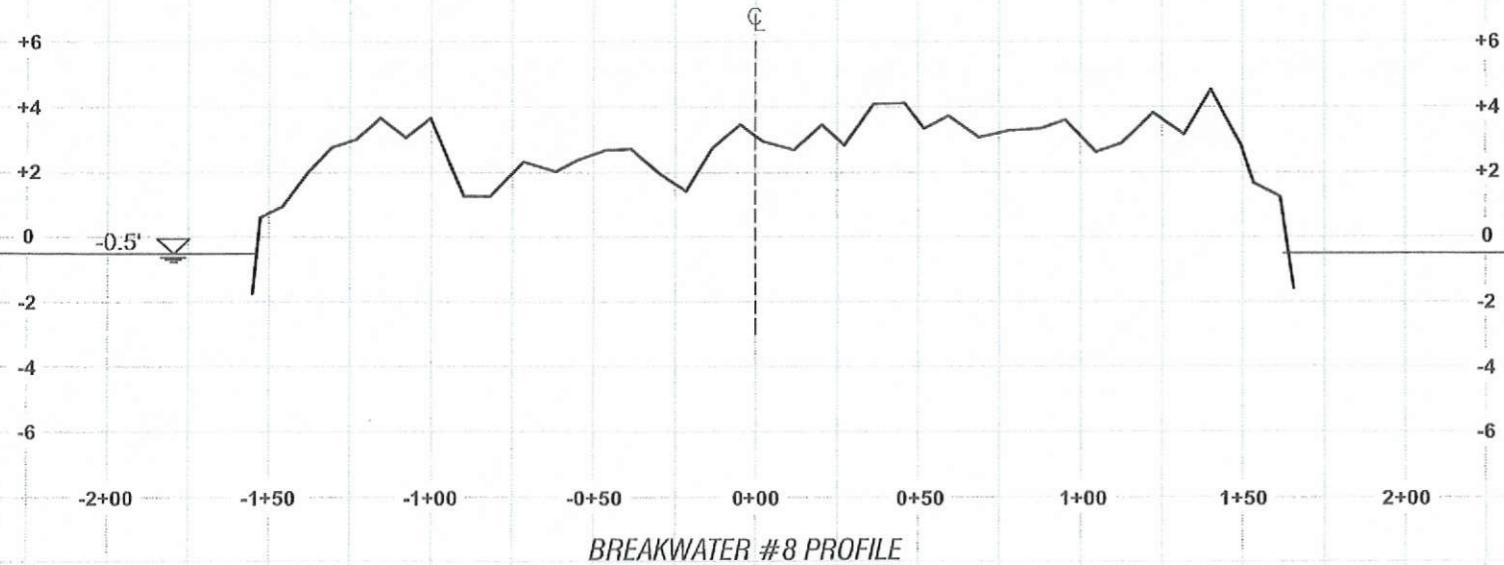

NOTES:



T. BAKER SMITH
SOLUTIONS START HERE
4125 40th Van Buren, Indiana, IN 47636
(800) 560-1050 • tbsmith.com


HORIZONTAL SCALE: 1" = 60'
60' 30' 0' 60'
VERTICAL SCALE: 1" = 6'
6' 3' 0' 6'
REV. NO: 00 REV. DATE: -/-/- REV. BY: ---
REVISION DESCRIPTION: ---

DRAWN BY: JMC APPROVED BY: JCM
DATE: 5/5/2015 JOB NO: 2015.0072
DRAWING NAME: 18-22 PROFILES.DWG
PROJECTION: LA83-SF-MOD
GEO. DATUM: NAD83 | VERT. DATUM: NAVD88
GRID UNITS: US SURVEY FEET
SHEET NO: 21 OF 22


BREAKWATER PROFILES

COASTAL PROTECTION AND RESTORATION AUTHORITY
TETRA TECH, INC.
RACCOON ISLAND SHORELINE PROTECTION/
MARSH CREATION (TE-48) PROJECT
BREAKWATER SURVEY
TERREBONNE PARISH, LOUISIANA


NOTE: ALL PROFILES
SHOWN LOOKING NORTH

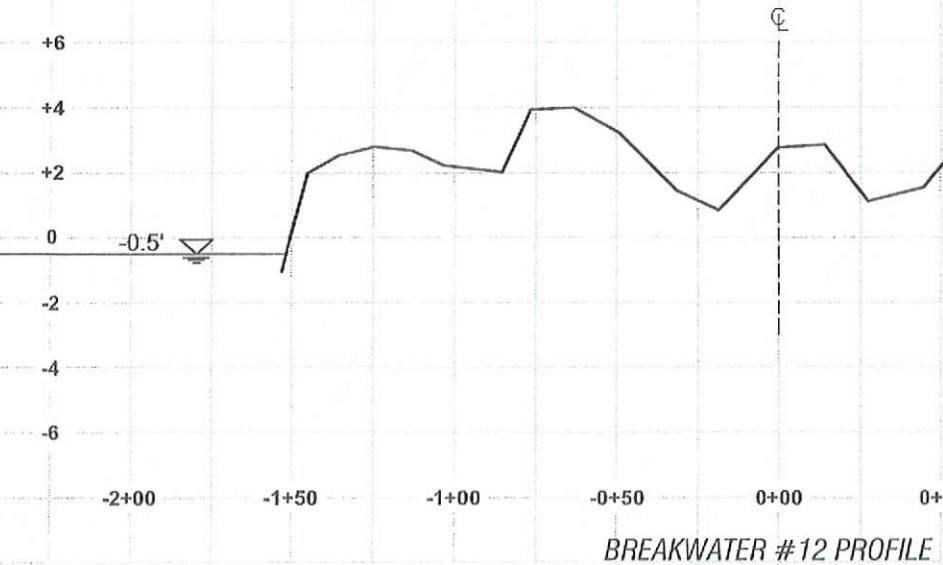


BREAKWATER #12 PROFILE

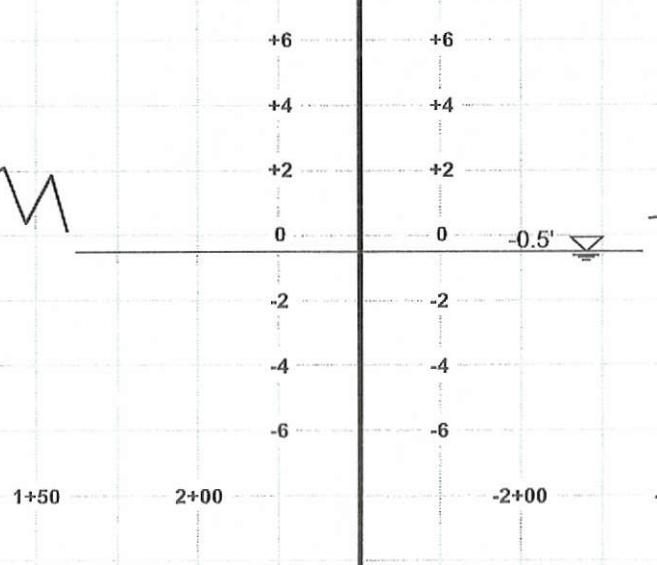


BREAKWATER #13 PROFILE

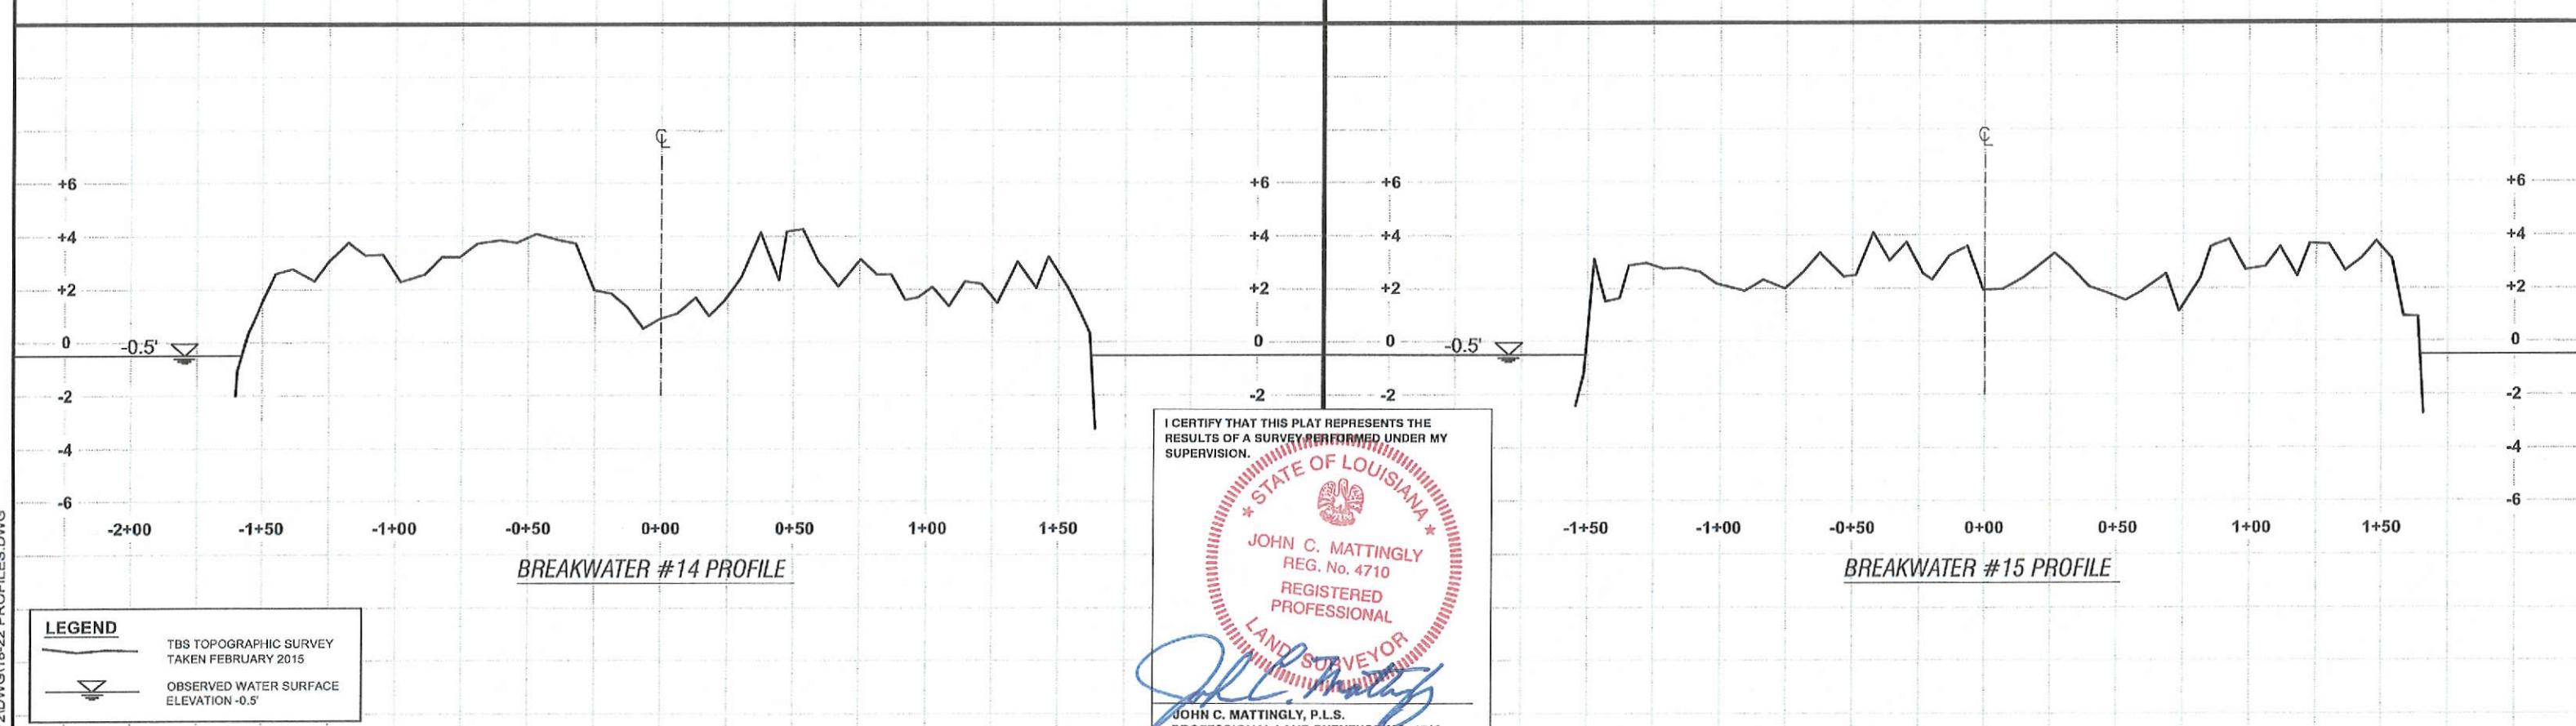

BREAKWATER #14 PROFILE

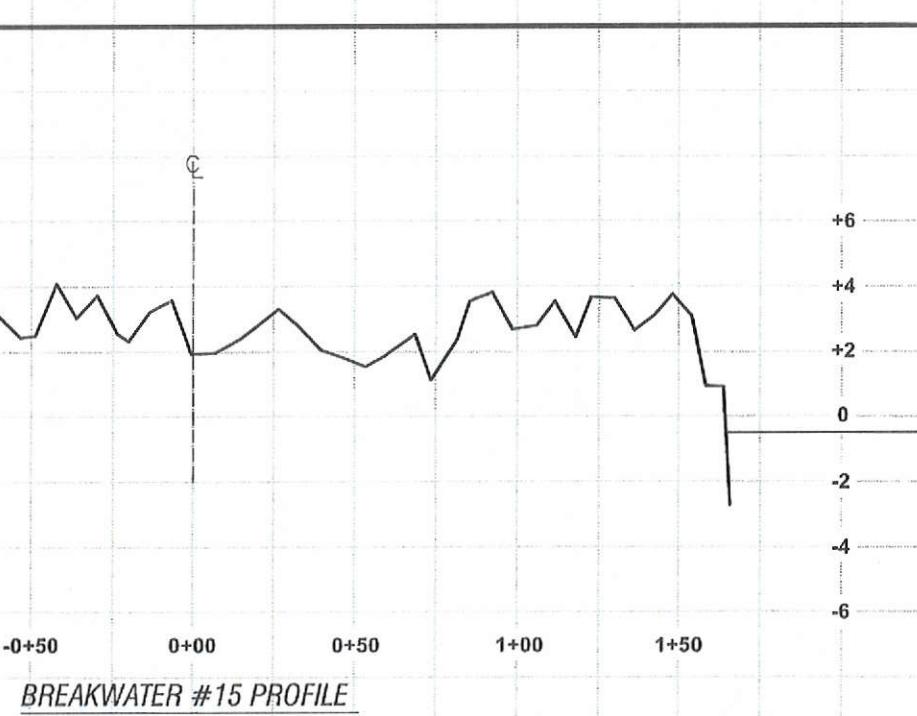


BREAKWATER #15 PROFILE

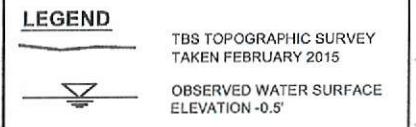

T. BAKER SMITH
SOLUTIONS START HERE
112 South Van Buren, Houma, LA 70363
985.566.1050 • tbsolutions.com

NOTES:

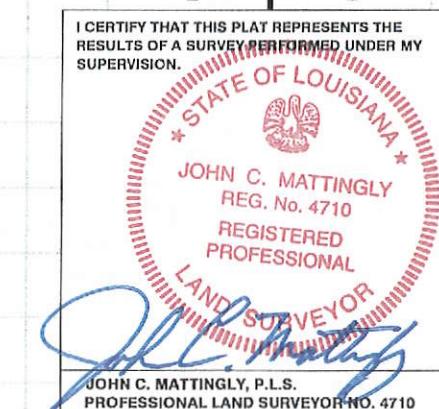

HORIZONTAL SCALE: 1" = 60'
60' 30' 0' 60'
VERTICAL SCALE: 1" = 6'
6' 3' 0' 6'
REV. NO: 00 REV. DATE: -/-/- REV. BY: ---
REVISION DESCRIPTION: --

DRAWN BY: JMC APPROVED BY: JCM
DATE: 5/5/2015 JOB NO: 2015.0072
DRAWING NAME: 18-22 PROFILES.DWG
PROJECTION: LA83-SF-MOD
GEO. DATUM: NAD83 | VERT. DATUM: NAVD88
GRID UNITS: US SURVEY FEET
SHEET NO: 22 OF 22

BREAKWATER PROFILES

COASTAL PROTECTION AND RESTORATION AUTHORITY
TETRA TECH, INC.
RACCOON ISLAND SHORELINE PROTECTION/
MARSH CREATION (TE-48) PROJECT
BREAKWATER SURVEY
TERREBONNE PARISH, LOUISIANA