INDEX TO SHEETS

SHEET NO.	DESCRIPTION
1	TITLE SHEET
2 - 8	PLAN AND PROFILE SHEETS
9 - 13	CROSS SECTION SHEETS

STATE OF LOUISIANA
DEPARTMENT OF NATURAL RESOURCES
COASTAL ENGINEERING DIVISION

ASBUILT

RESTORATION OF THE CAMERON CREOLE WATERSHED LEVEE - PHASE I
CWPPRA PROJECT NO. CS-04A-L
CAMERON PARISH, LOUISIANA

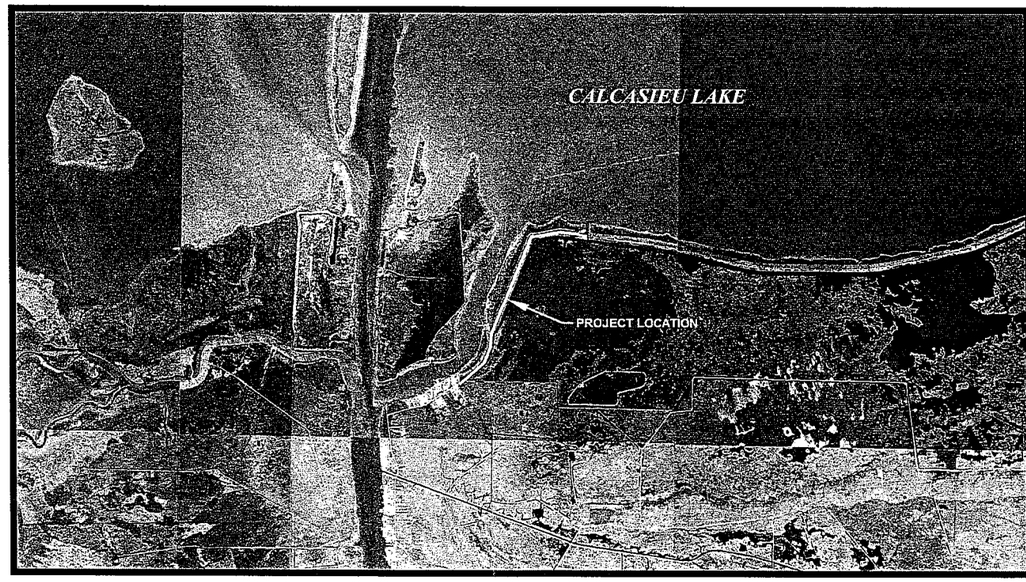

6000 0 6000 12000

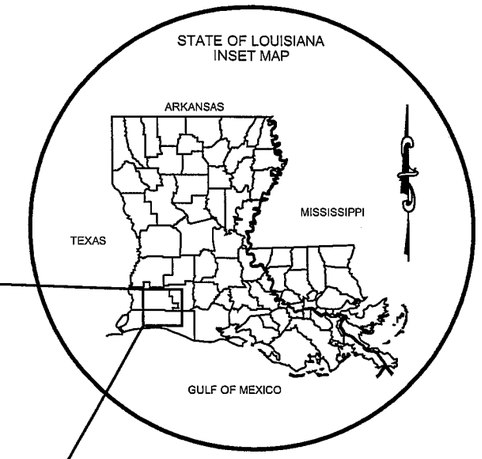

STATE PROJECT SPONSOR

FEDERAL PROJECT SPONSOR

STATE OF LOUISIANA
ANDRE' AUCOIN
REG. No. 22395
REGISTERED PROFESSIONAL ENGINEER
IN
CIVIL ENGINEERING

ANDRE' AUCOIN, P.E.

TYPE OF CONSTRUCTION
CLASSIFICATION III (HEAVY CONSTRUCTION)
CAMERON CREOLE WATERSHED PROJECT LEVEE RESTORATION

REV.	DATE	DESCRIPTION	BY

A E inc.
ACADIAN ENGINEERS & ENVIRONMENTAL CONSULTANTS INC.
1601 AMAZON ST.
EUNICE, LOUISIANA
337-457-1492

LOUISIANA DEPARTMENT OF NATURAL RESOURCES
COASTAL ENGINEERING DIVISION
617 NORTH 3RD STREET
BATON ROUGE, LOUISIANA 70802

DRAWN BY: LORI FUSELIER | DESIGNED BY: ANDRE' AUCOIN

RESTORATION OF THE CAMERON CREOLE WATERSHED LEVEE - PHASE I
STATE PROJECT NUMBER: CS-04A-L
FEDERAL PROJECT NUMBER: N/A
APPROVED BY:

ASBUILT
TITLE SHEET
DATE: FEBRUARY 2010
SHEET 1 OF 13

G:\07-ae-23G\acad\EaglePoint\Title Sheet.dwg, 2/15/2010 8:03:12 AM

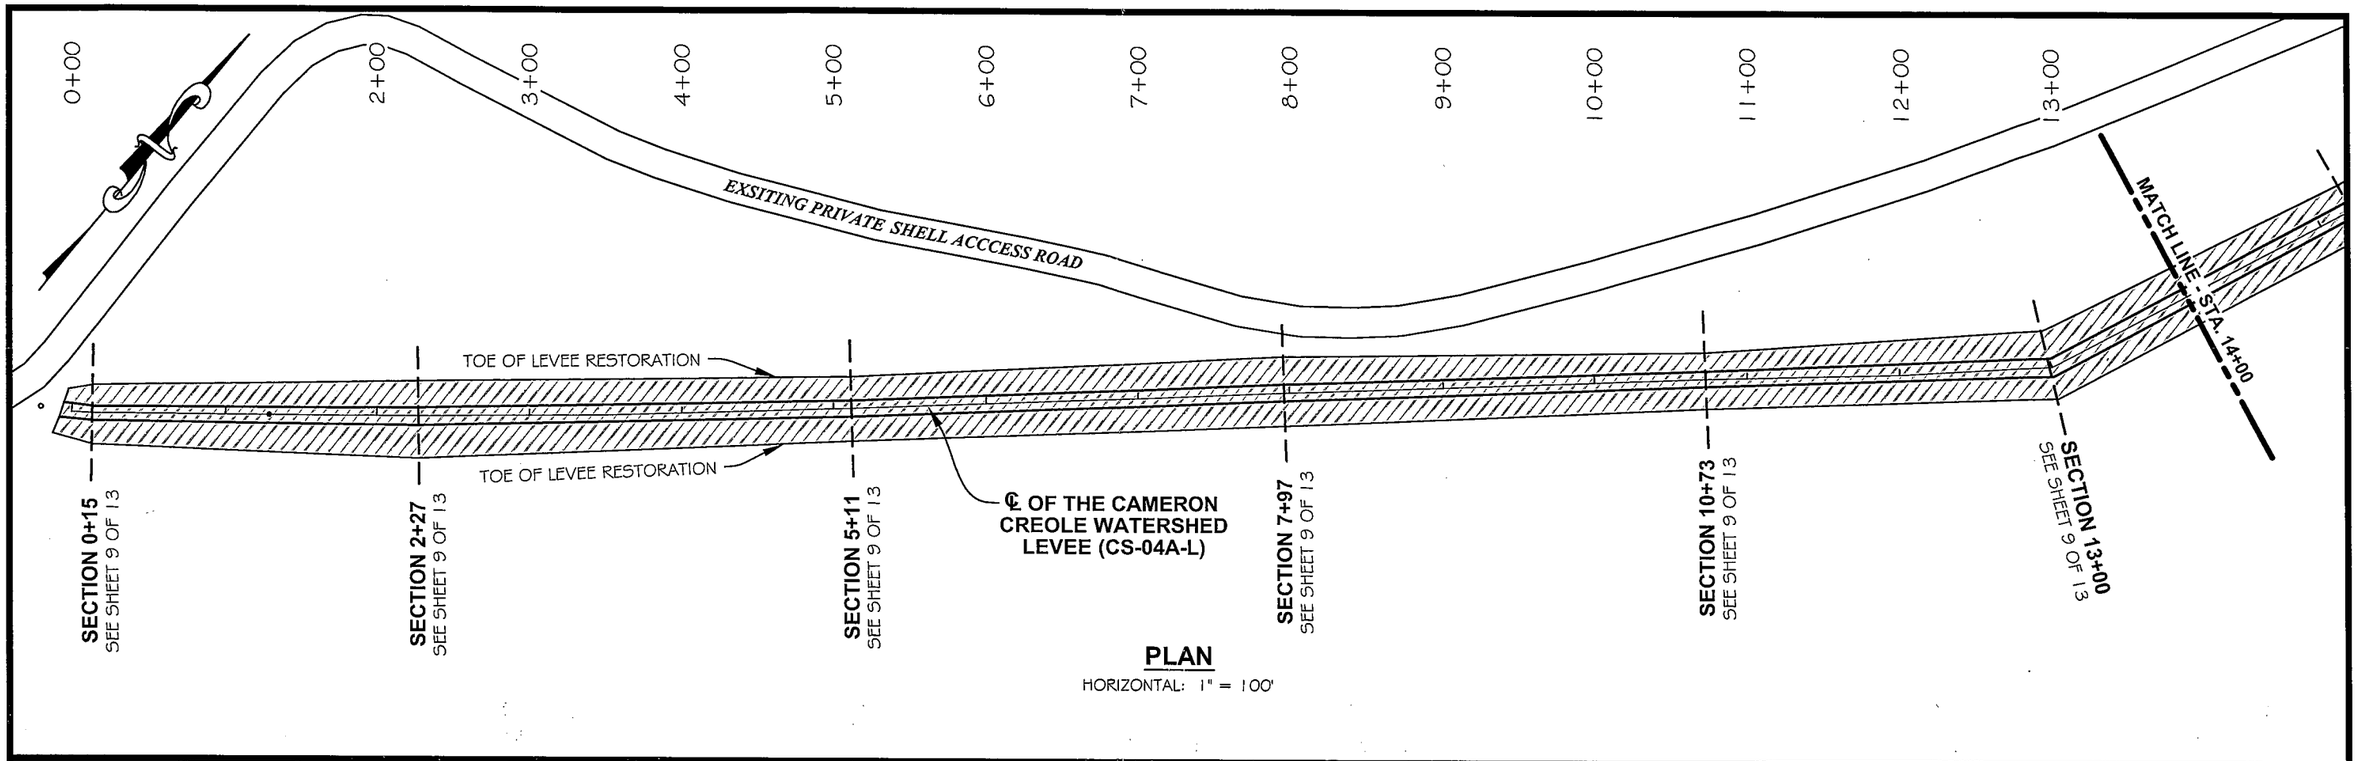

PLAN

HORIZONTAL: 1" = 100'

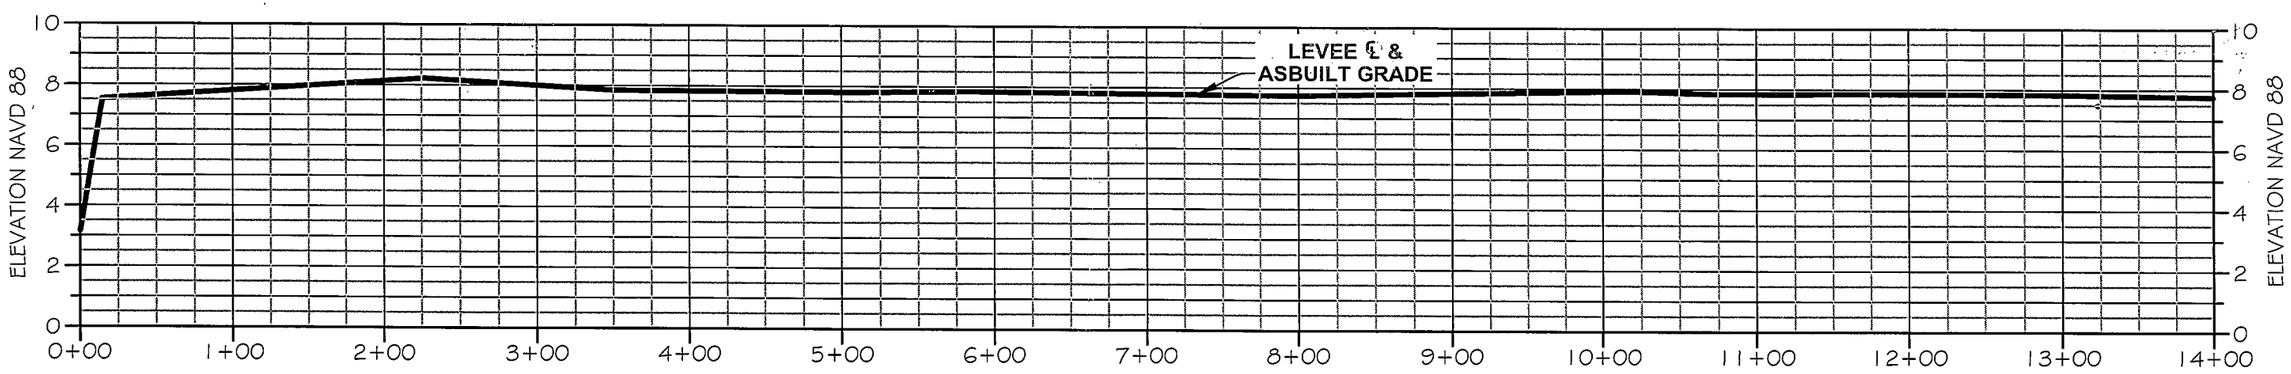

PROFILE

HORIZONTAL: 1" = 100'
VERTICAL: 1" = 5'

STATE OF LOUISIANA
ANDRE' AUCOIN
REG. No. 22395
REGISTERED PROFESSIONAL ENGINEER
IN
CIVIL ENGINEERING

REV.	DATE	DESCRIPTION	BY

A E inc.
ACADIAN ENGINEERS & ENVIRONMENTAL CONSULTANTS INC.
1601 AMAZON ST.
EUNICE, LOUISIANA
337-457-1492

LOUISIANA DEPARTMENT OF NATURAL RESOURCES
COASTAL ENGINEERING DIVISION
617 NORTH 3RD STREET
BATON ROUGE, LOUISIANA 70802

DRAWN BY: LORI FUSELIER
DESIGNED BY: ANDRE' AUCOIN

RESTORATION OF THE CAMERON CREOLE WATERSHED LEVEE - PHASE I

STATE PROJECT NUMBER: CS-04A-L

FEDERAL PROJECT NUMBER: N/A

APPROVED BY:

ASBUILT
CROSS SECTIONS

DATE: FEBRUARY 2010

SHEET 2 OF 13

G:\07-ae-23\acad\EaglePoint\Plan & Profile Sheets.dwg, 2/15/2010 8:28:30 AM

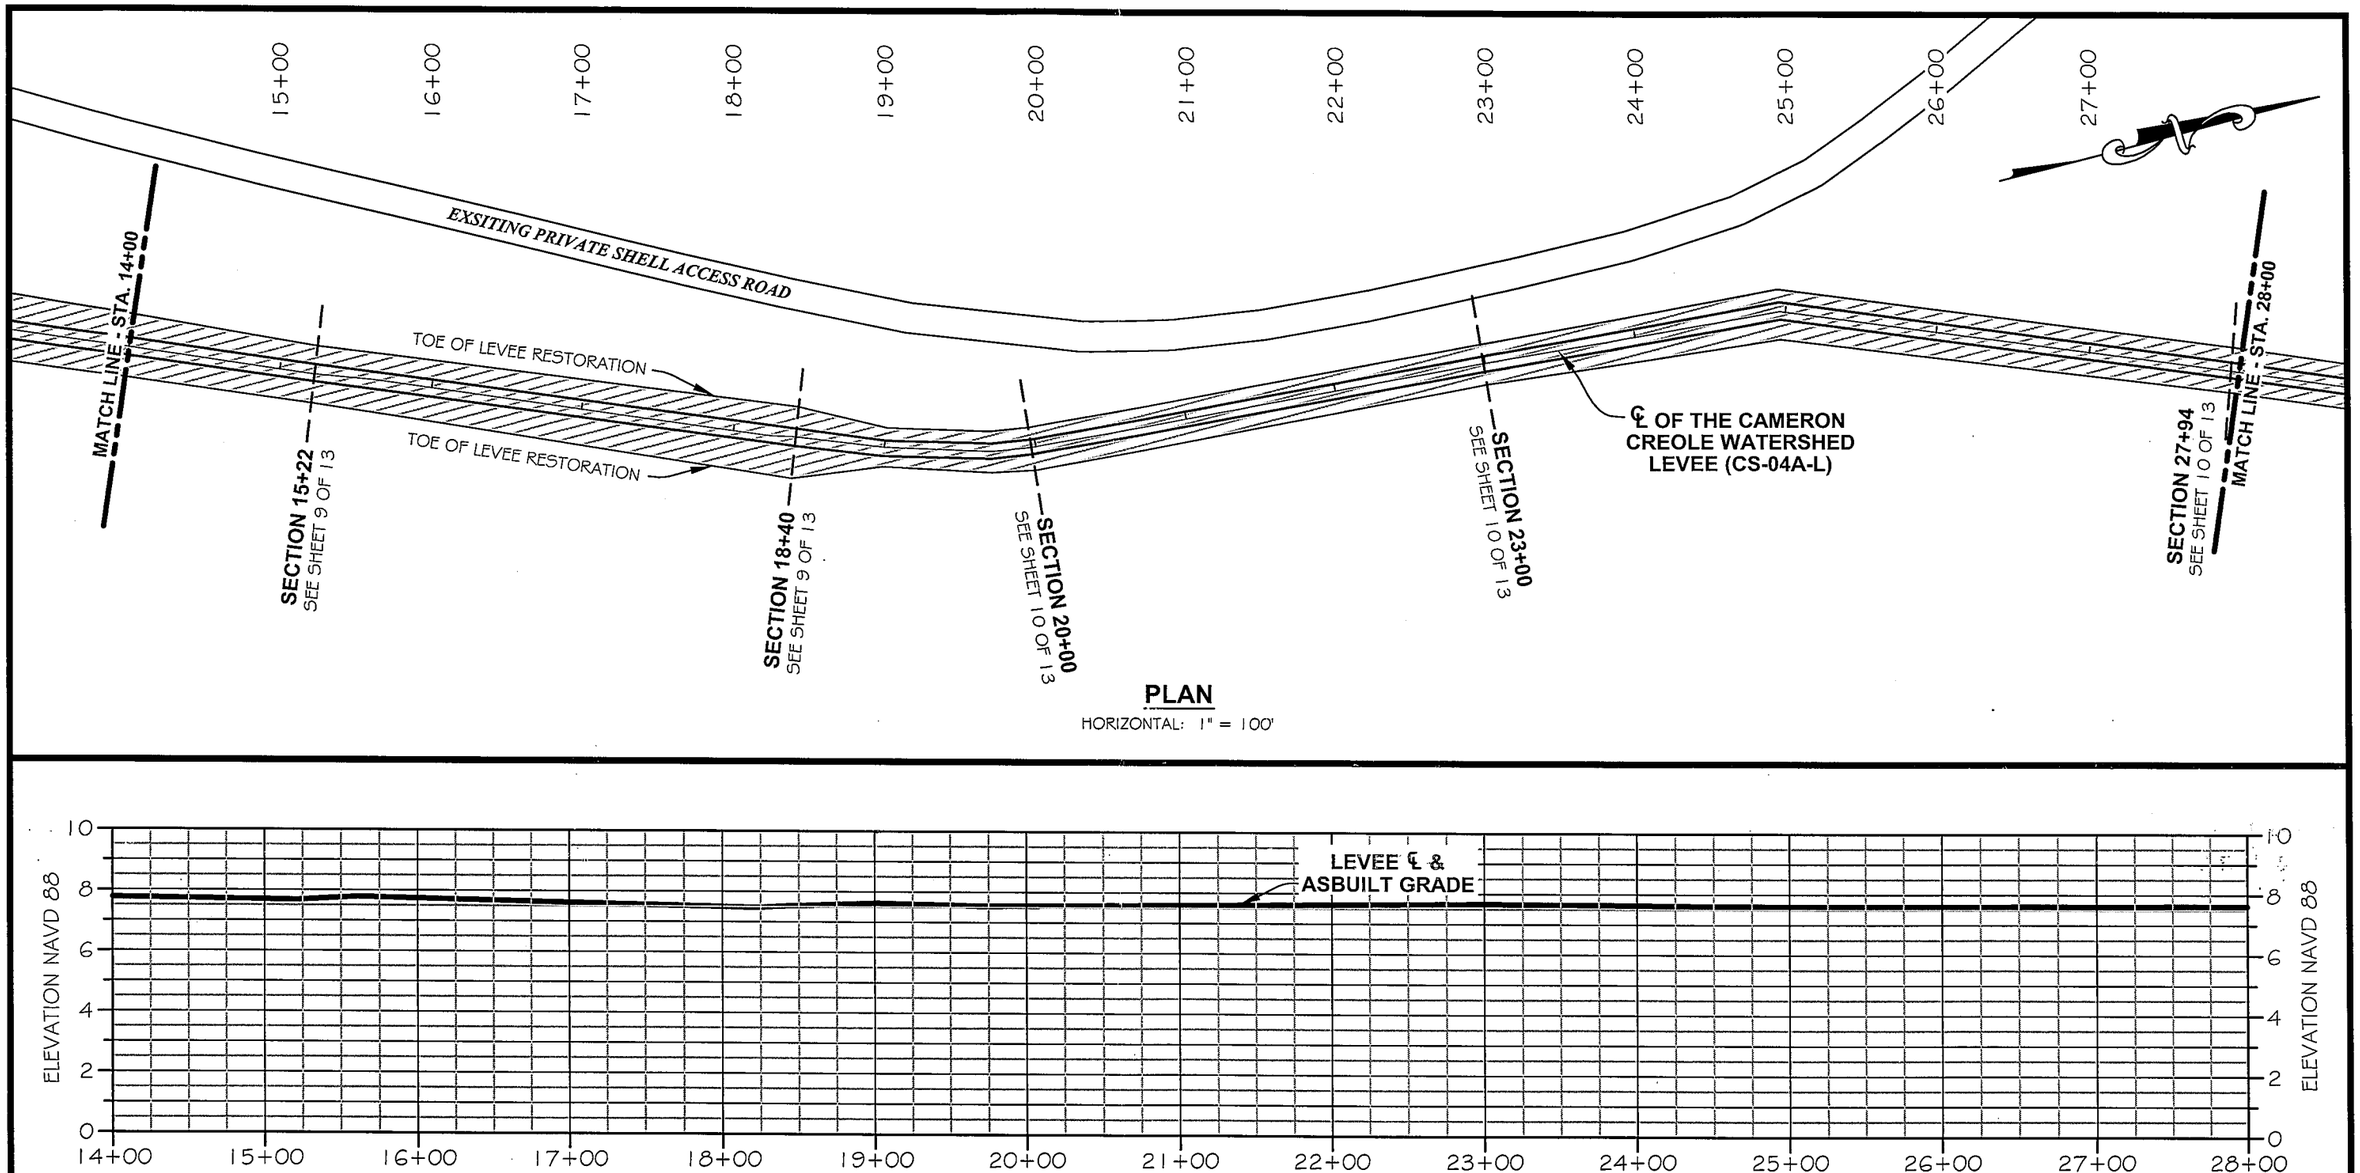

PROFILE

HORIZONTAL: 1" = 100'
VERTICAL: 1" = 5'

STATE OF LOUISIANA
ANDRE' AUCOIN
REG. No. 22395
REGISTERED PROFESSIONAL ENGINEER
IN
CIVIL ENGINEERING

REV.	DATE	DESCRIPTION	BY

A E inc.
ACADIAN ENGINEERS & ENVIRONMENTAL CONSULTANTS INC.
1601 AMAZON ST.
EUNICE, LOUISIANA
337-457-1492

LOUISIANA DEPARTMENT OF NATURAL RESOURCES
COASTAL ENGINEERING DIVISION
617 NORTH 3RD STREET
BATON ROUGE, LOUISIANA 70802

DRAWN BY: LORI FUSELIER
DESIGNED BY: ANDRE' AUCOIN

RESTORATION OF THE CAMERON CREOLE WATERSHED LEVEE - PHASE I

STATE PROJECT NUMBER: CS-04A-L

FEDERAL PROJECT NUMBER: N/A

APPROVED BY:

ASBUILT
CROSS SECTIONS

DATE: FEBRUARY 2010

SHEET 3 OF 13

G:\07-ae-23\Gacad\EaglePoint\Plan & Profile Sheets.dwg, 2/15/2010 8:49:15 AM

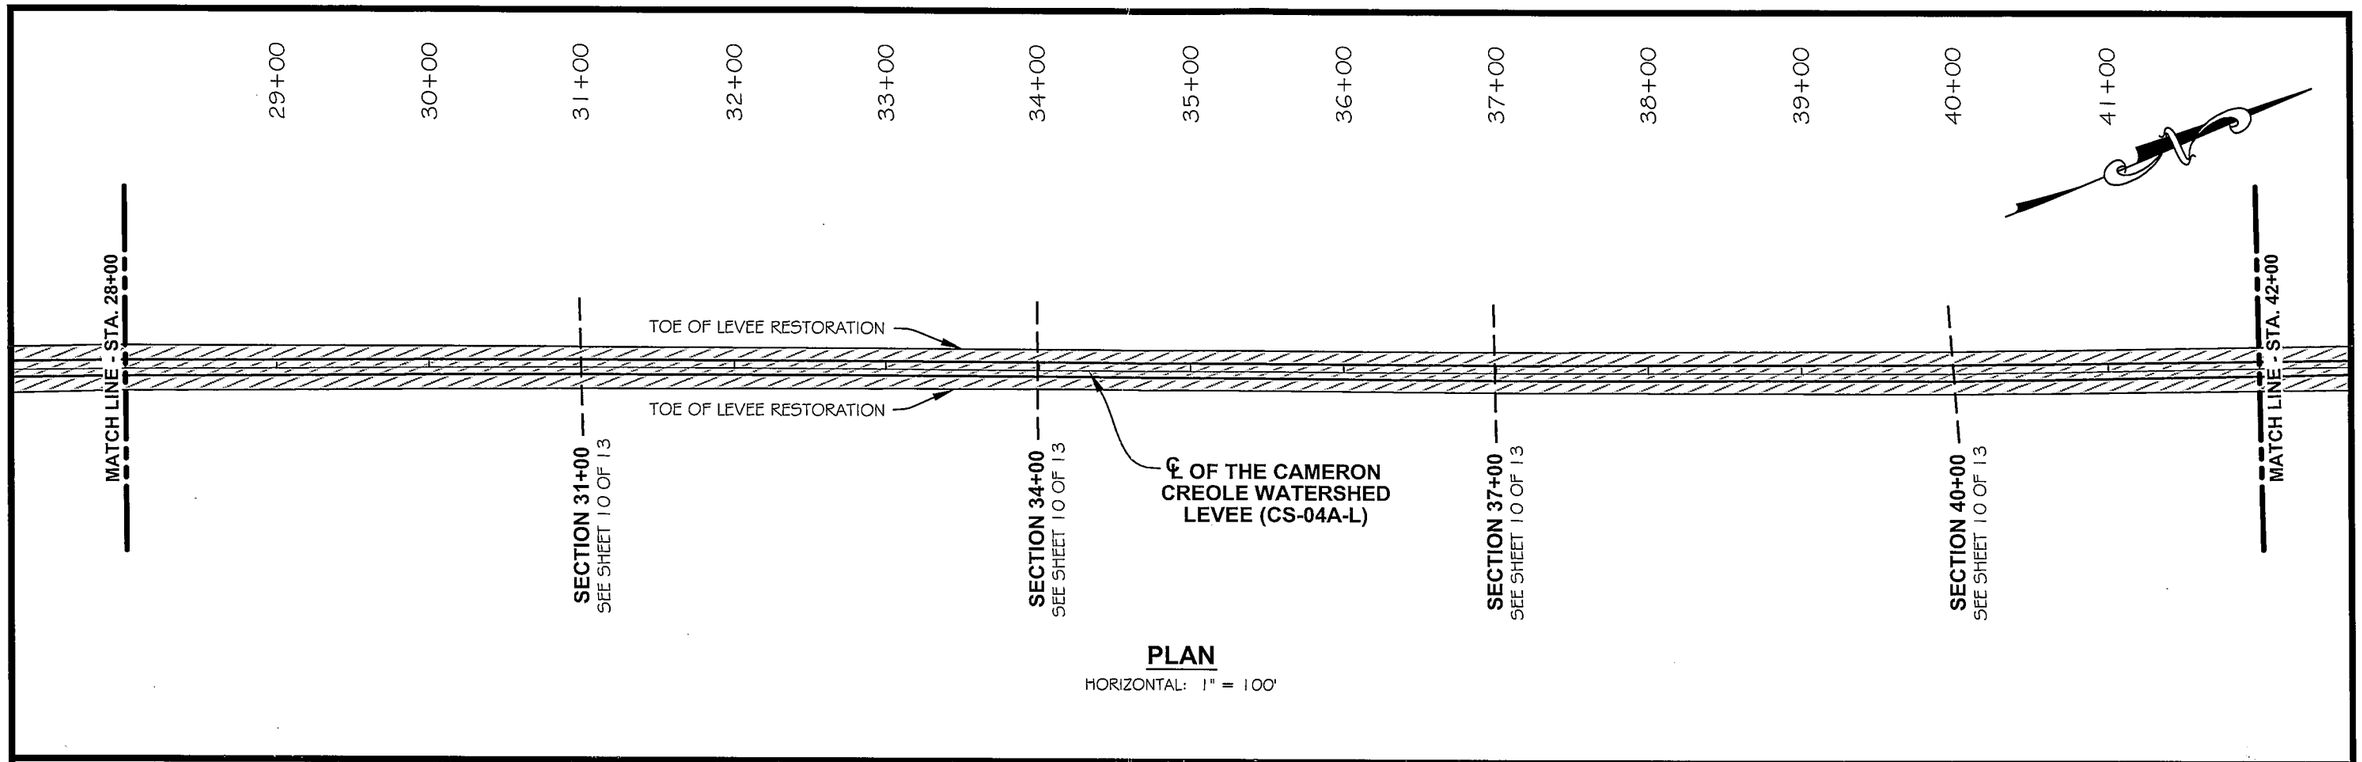

PLAN

HORIZONTAL: 1" = 100'

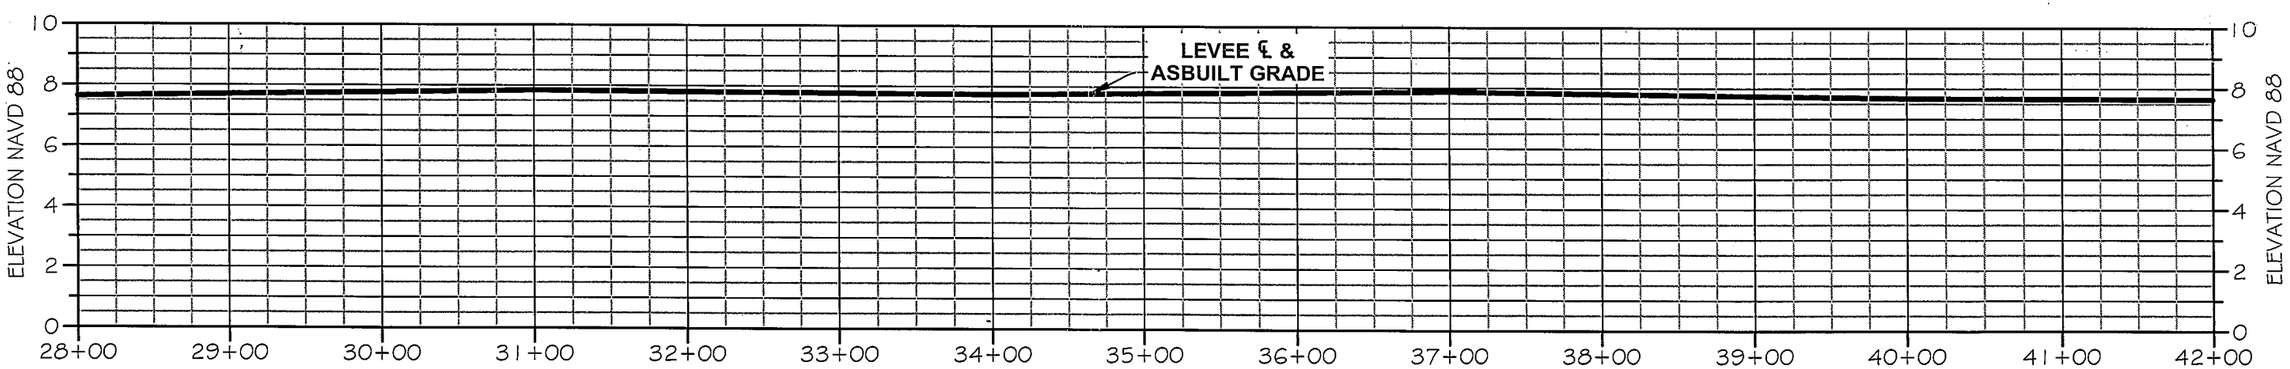

PROFILE

HORIZONTAL: 1" = 100'
VERTICAL: 1" = 5'

STATE OF LOUISIANA
ANDRE' AUCOIN
REG. No. 22395
REGISTERED
PROFESSIONAL ENGINEER
IN
CIVIL ENGINEERING

REV.	DATE	DESCRIPTION	BY

A E inc.
ACADIAN ENGINEERS & ENVIRONMENTAL CONSULTANTS INC.
1601 AMAZON ST.
EUNICE, LOUISIANA
337-457-1492

LOUISIANA DEPARTMENT OF NATURAL RESOURCES
COASTAL ENGINEERING DIVISION
617 NORTH 3RD STREET
BATON ROUGE, LOUISIANA 70802

DRAWN BY: LORI FUSELIER
DESIGNED BY: ANDRE' AUCOIN

RESTORATION OF THE CAMERON CREOLE WATERSHED LEVEE - PHASE I

STATE PROJECT NUMBER: CS-04A-L

FEDERAL PROJECT NUMBER: N/A

APPROVED BY:

ASBUILT
CROSS SECTIONS

DATE: FEBRUARY 2010

SHEET 4 OF 13

G:\07-ae-23\Gacad\EaglePoint\Plan & Profile Sheets.dwg, 2/15/2010 8:49:36 AM

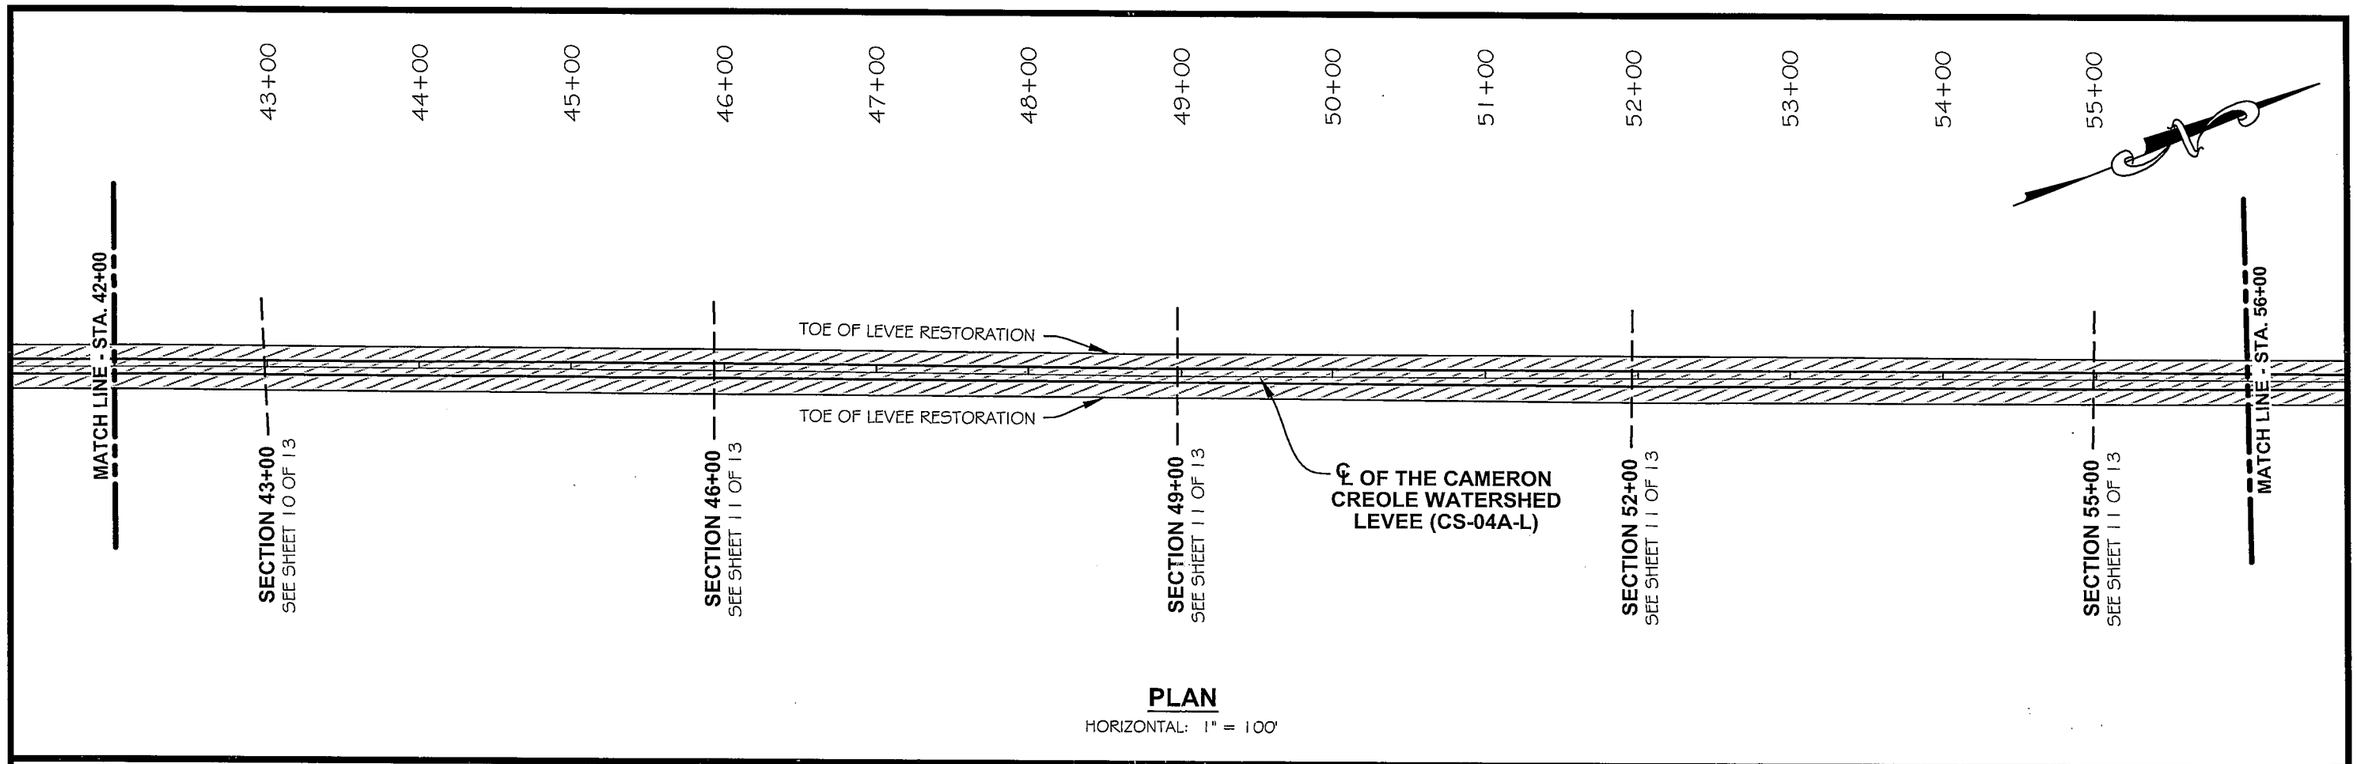

PLAN

HORIZONTAL: 1" = 100'

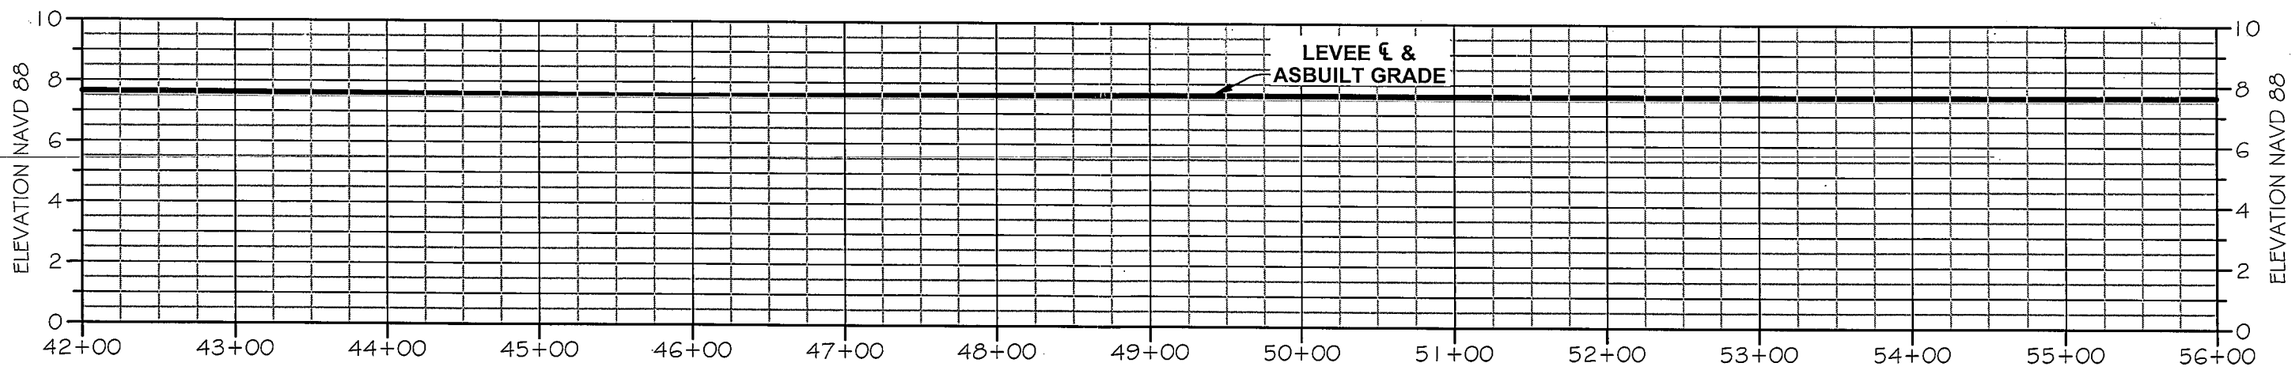

PROFILE

HORIZONTAL: 1" = 100'
VERTICAL: 1" = 5'

STATE OF LOUISIANA
ANDRE' AUCOIN
REG. No. 22395
REGISTERED
PROFESSIONAL ENGINEER
IN
CIVIL ENGINEERING

REV.	DATE	DESCRIPTION	BY

A E inc.
ACADIAN ENGINEERS & ENVIRONMENTAL CONSULTANTS INC.
1601 AMAZON ST.
EUNICE, LOUISIANA
337-457-1492

LOUISIANA DEPARTMENT OF NATURAL RESOURCES
COASTAL ENGINEERING DIVISION
617 NORTH 3RD STREET
BATON ROUGE, LOUISIANA 70802

DRAWN BY: LORI FUSELIER
DESIGNED BY: ANDRE' AUCOIN

RESTORATION OF THE CAMERON CREOLE WATERSHED LEVEE - PHASE I

STATE PROJECT NUMBER: CS-04A-L

FEDERAL PROJECT NUMBER: N/A

APPROVED BY:

ASBUILT
CROSS SECTIONS

DATE: FEBRUARY 2010

SHEET 5 OF 13

G:\07-ae-23G\acad\EaglePoint\Plan & Profile Sheets.dwg, 2/15/2010 8:50:02 AM

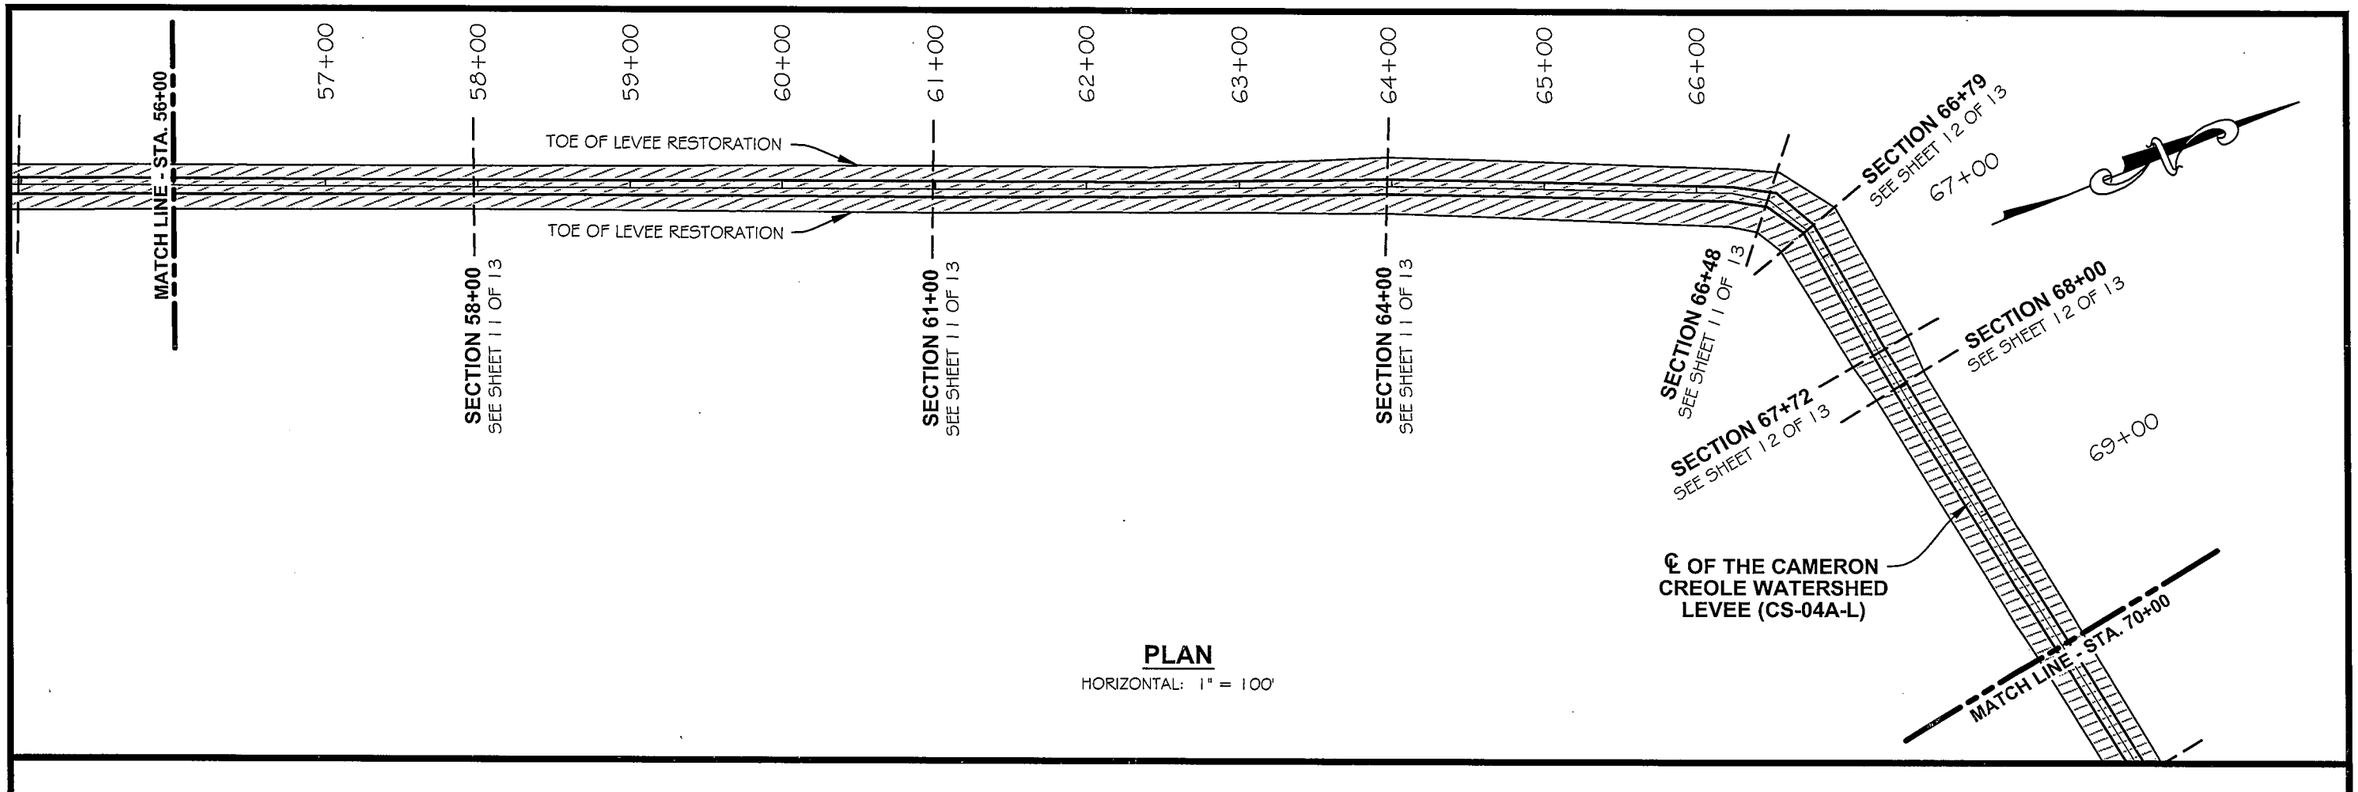

PLAN

HORIZONTAL: 1" = 100'

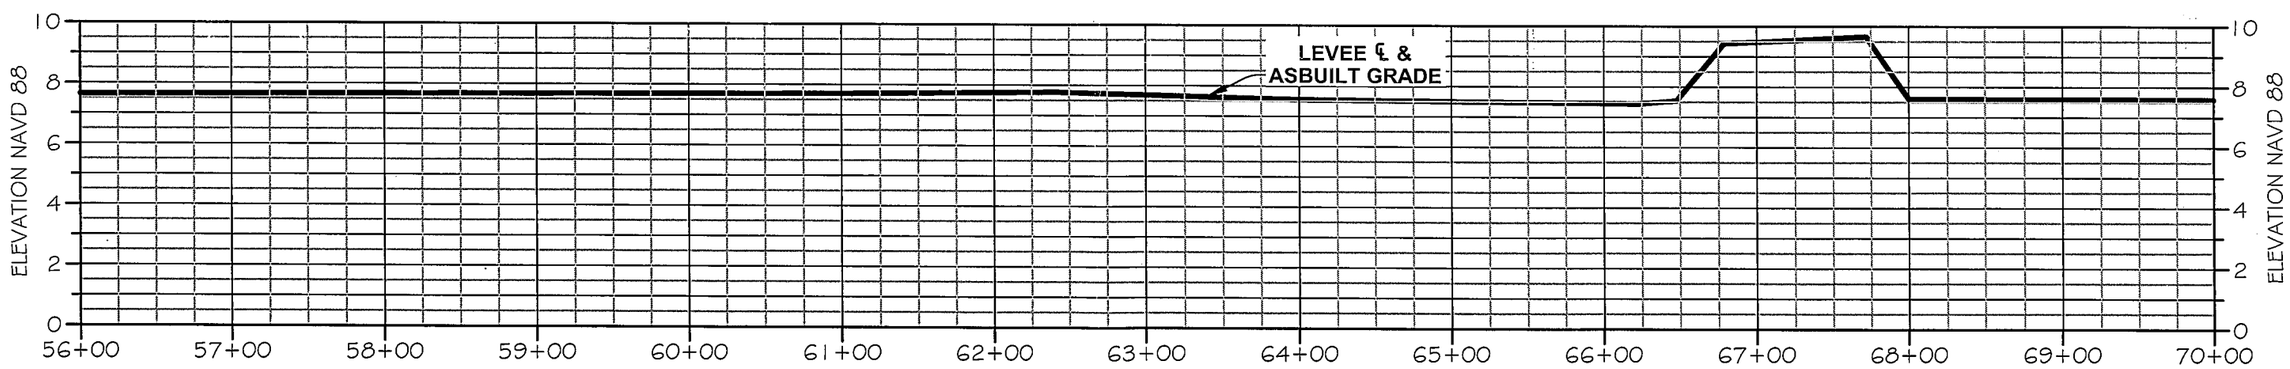

PROFILE

HORIZONTAL: 1" = 100'
VERTICAL: 1" = 5'

STATE OF LOUISIANA
ANDRE' AUCOIN
REG. No. 22395
REGISTERED PROFESSIONAL ENGINEER
IN
CIVIL ENGINEERING

REV.	DATE	DESCRIPTION	BY

A E inc.
ACADIAN ENGINEERS & ENVIRONMENTAL CONSULTANTS INC.
1601 AMAZON ST.
EUNICE, LOUISIANA
337-457-1492

LOUISIANA DEPARTMENT OF NATURAL RESOURCES
COASTAL ENGINEERING DIVISION
617 NORTH 3RD STREET
BATON ROUGE, LOUISIANA 70802

DRAWN BY: LORI FUSELIER
DESIGNED BY: ANDRE' AUCOIN

RESTORATION OF THE CAMERON CREOLE WATERSHED LEVEE - PHASE I

STATE PROJECT NUMBER: CS-04A-L

FEDERAL PROJECT NUMBER: N/A

APPROVED BY:

ASBUILT
CROSS SECTIONS

DATE: FEBRUARY 2010

SHEET 6 OF 13

G:\07-ae-23\acad\EaglePoint\Plan & Profile Sheets.dwg, 2/15/2010 8:50:24 AM

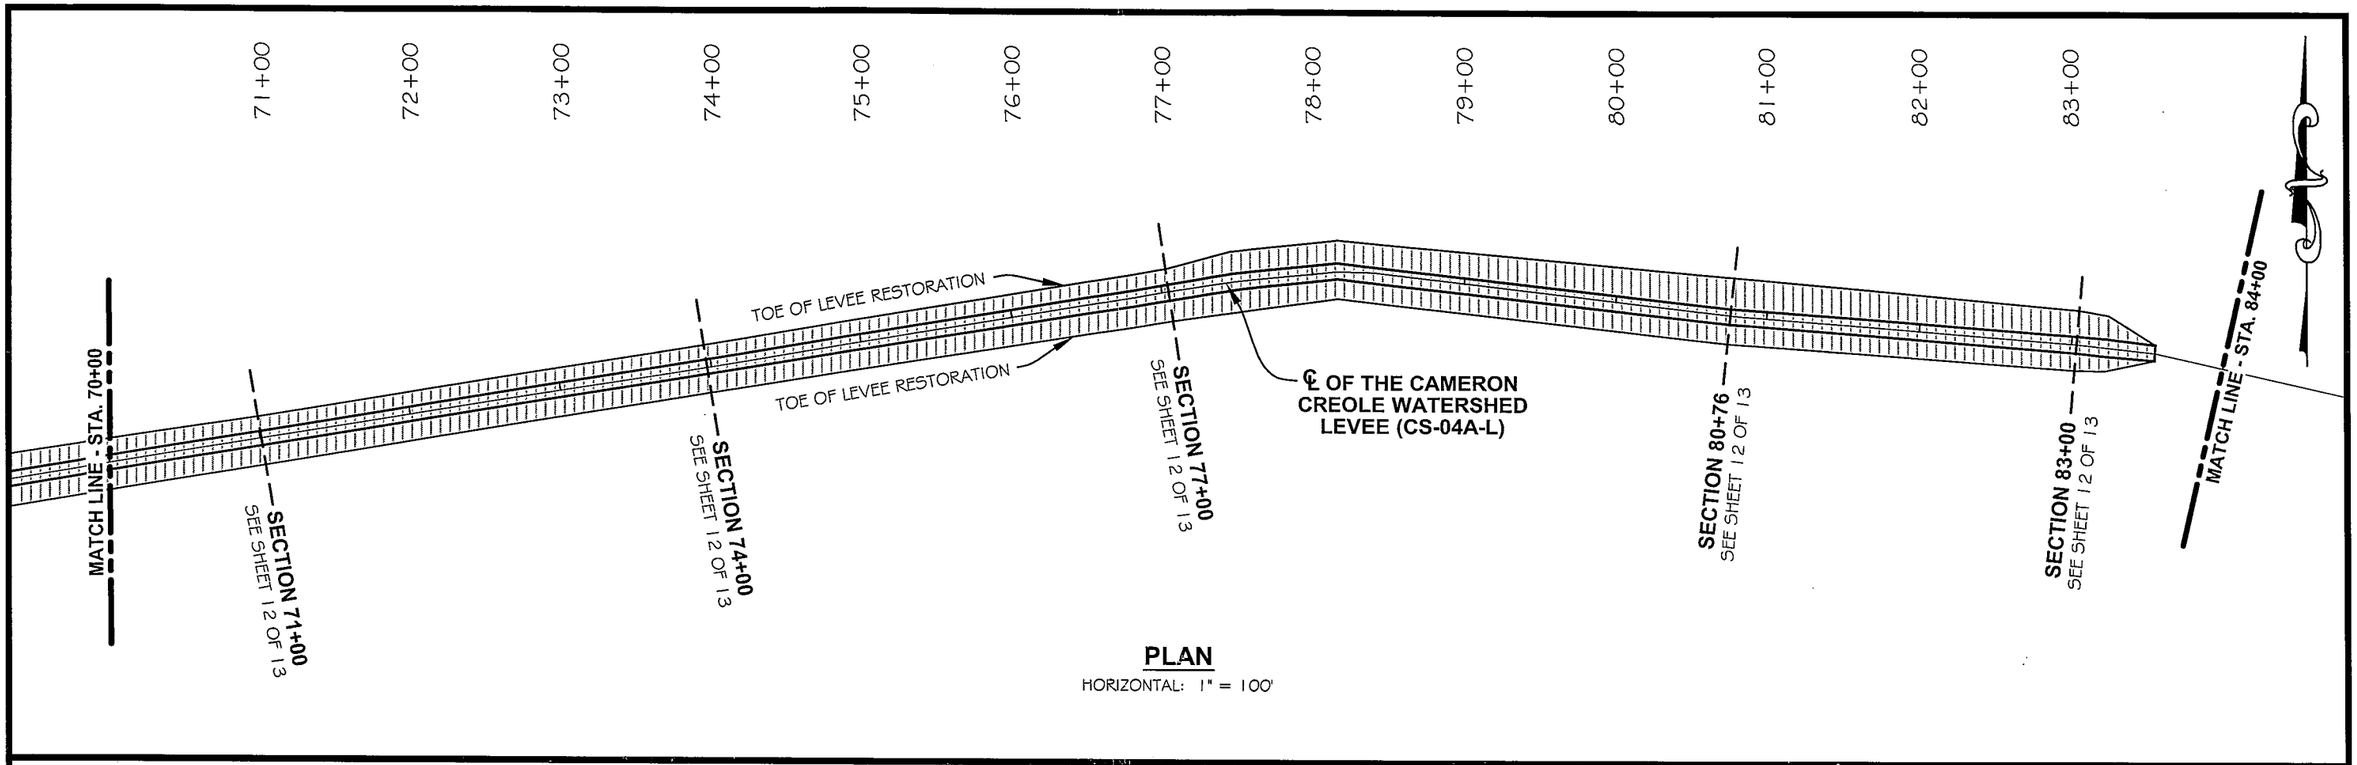

PLAN

HORIZONTAL: 1" = 100'

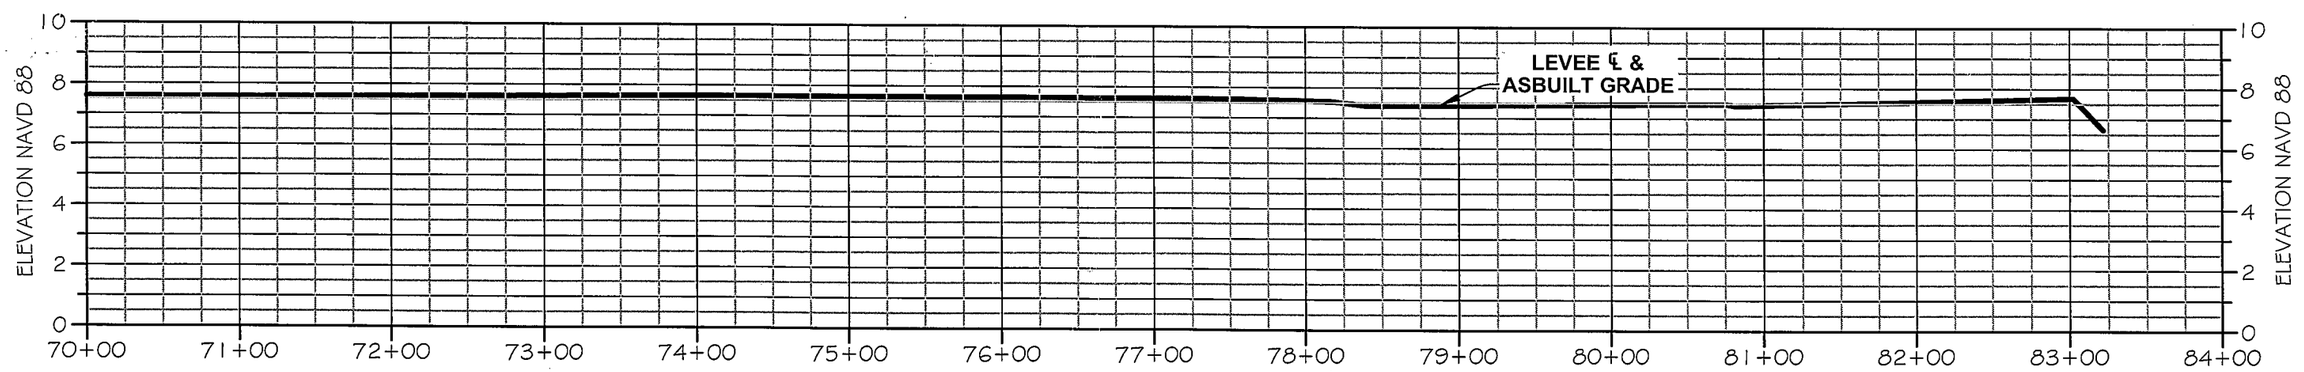

PROFILE

HORIZONTAL: 1" = 100'
VERTICAL: 1" = 5'

STATE OF LOUISIANA
ANDRE' AUCOIN
REG. No. 22395
REGISTERED
PROFESSIONAL ENGINEER
IN
CIVIL ENGINEERING

REV.	DATE	DESCRIPTION	BY

A E inc.
ACADIAN ENGINEERS & ENVIRONMENTAL CONSULTANTS INC.
1601 AMAZON ST.
EUNICE, LOUISIANA
337-457-1492

LOUISIANA DEPARTMENT OF NATURAL RESOURCES
COASTAL ENGINEERING DIVISION
617 NORTH 3RD STREET
BATON ROUGE, LOUISIANA 70802

DRAWN BY: LORI FUSELIER
DESIGNED BY: ANDRE' AUCOIN

RESTORATION OF THE CAMERON CREOLE WATERSHED LEVEE - PHASE I
STATE PROJECT NUMBER: CS-04A-L
FEDERAL PROJECT NUMBER: N/A
APPROVED BY:

ASBUILT
CROSS SECTIONS
DATE: FEBRUARY 2010
SHEET 7 OF 13

G:\07-ae-23\Gacad\EaglePoint\Plan + Profile Sheets.dwg, 2/15/2010 8:50:48 AM

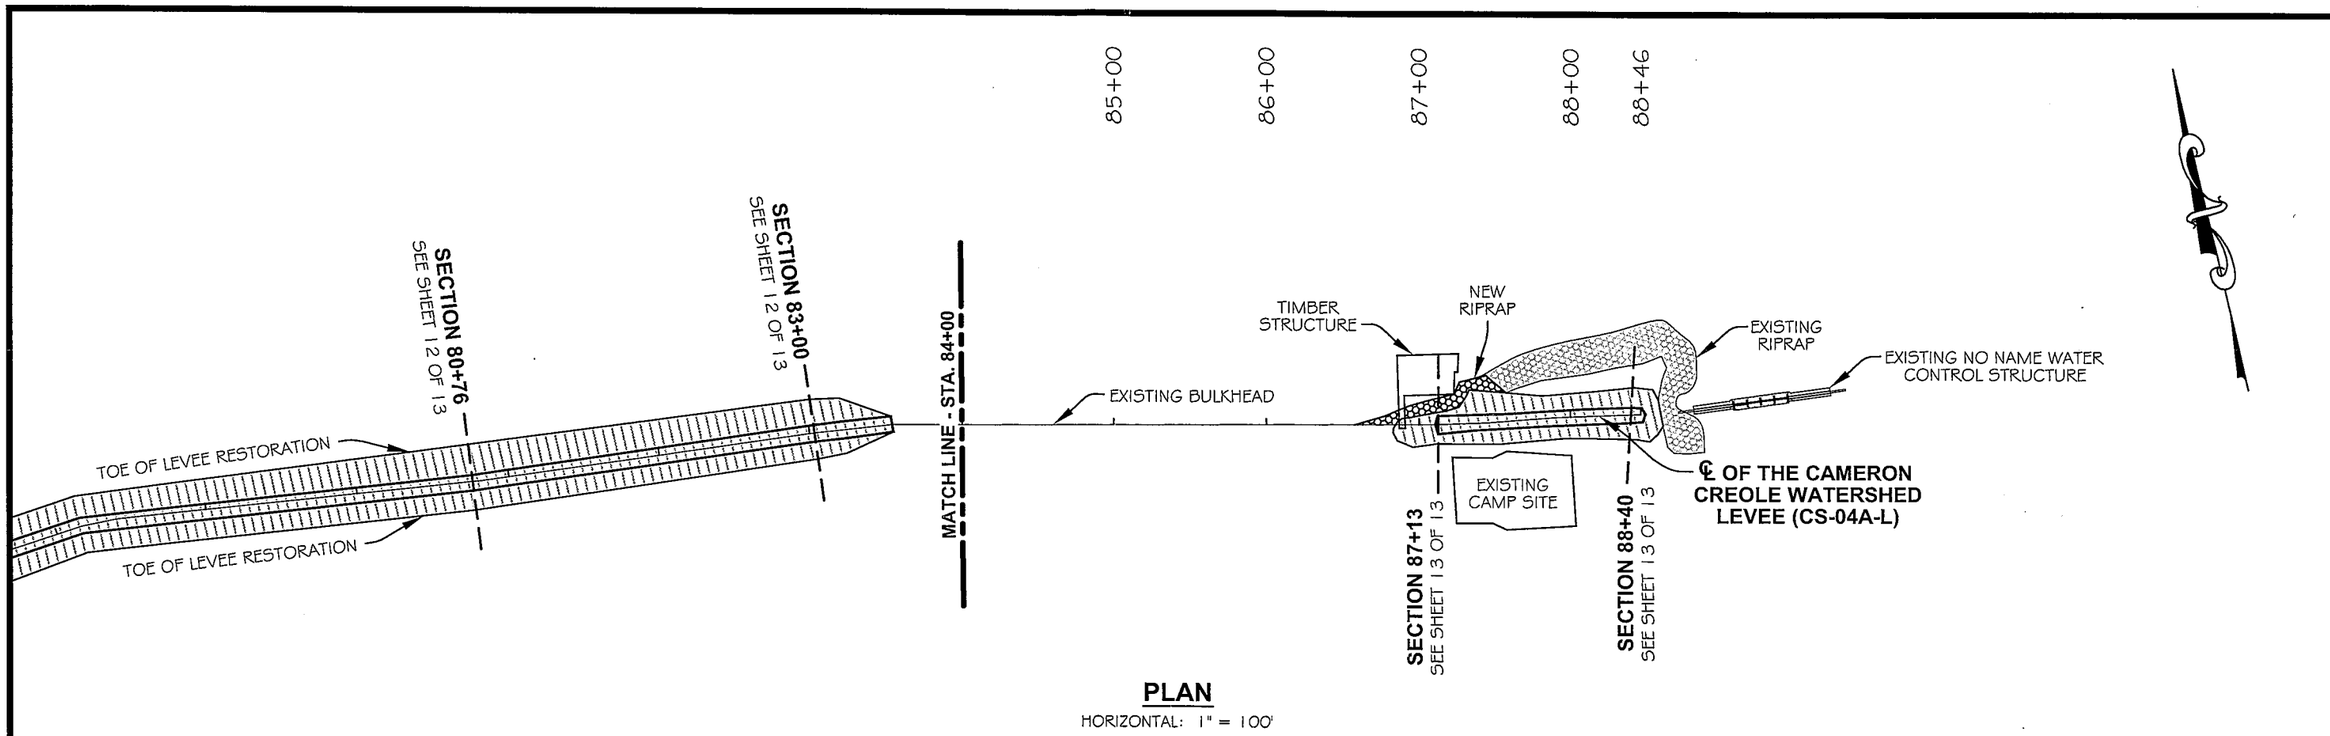

PLAN

HORIZONTAL: 1" = 100'

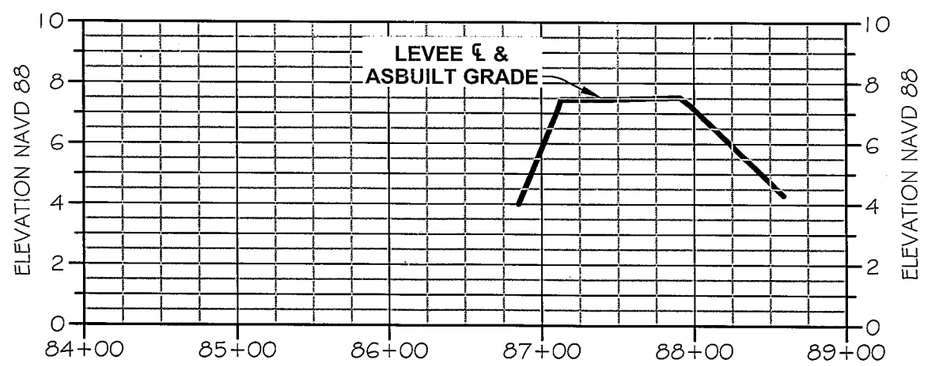

PROFILE

HORIZONTAL: 1" = 100'
VERTICAL: 1" = 5'

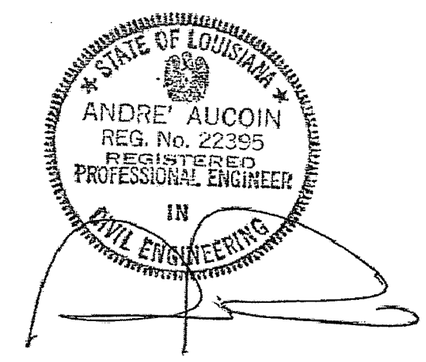

REV.	DATE	DESCRIPTION	BY

AE inc.
ACADIAN ENGINEERS & ENVIRONMENTAL CONSULTANTS INC.
1601 AMAZON ST.
EUNICE, LOUISIANA
337-457-1492

LOUISIANA DEPARTMENT OF NATURAL RESOURCES
COASTAL ENGINEERING DIVISION
617 NORTH 3RD STREET
BATON ROUGE, LOUISIANA 70802

DRAWN BY: LORI FUSELIER
DESIGNED BY: ANDRE' AUCOIN

RESTORATION OF THE CAMERON CREOLE WATERSHED LEVEE - PHASE I

STATE PROJECT NUMBER: CS-04A-L

FEDERAL PROJECT NUMBER: N/A

APPROVED BY:

ASBUILT
CROSS SECTIONS

DATE: FEBRUARY 2010

SHEET 8 OF 13

G:\07-ae-23\acad\EaglePoint\Plan & Profile Sheets.dwg, 2/15/2010 8:51:08 AM

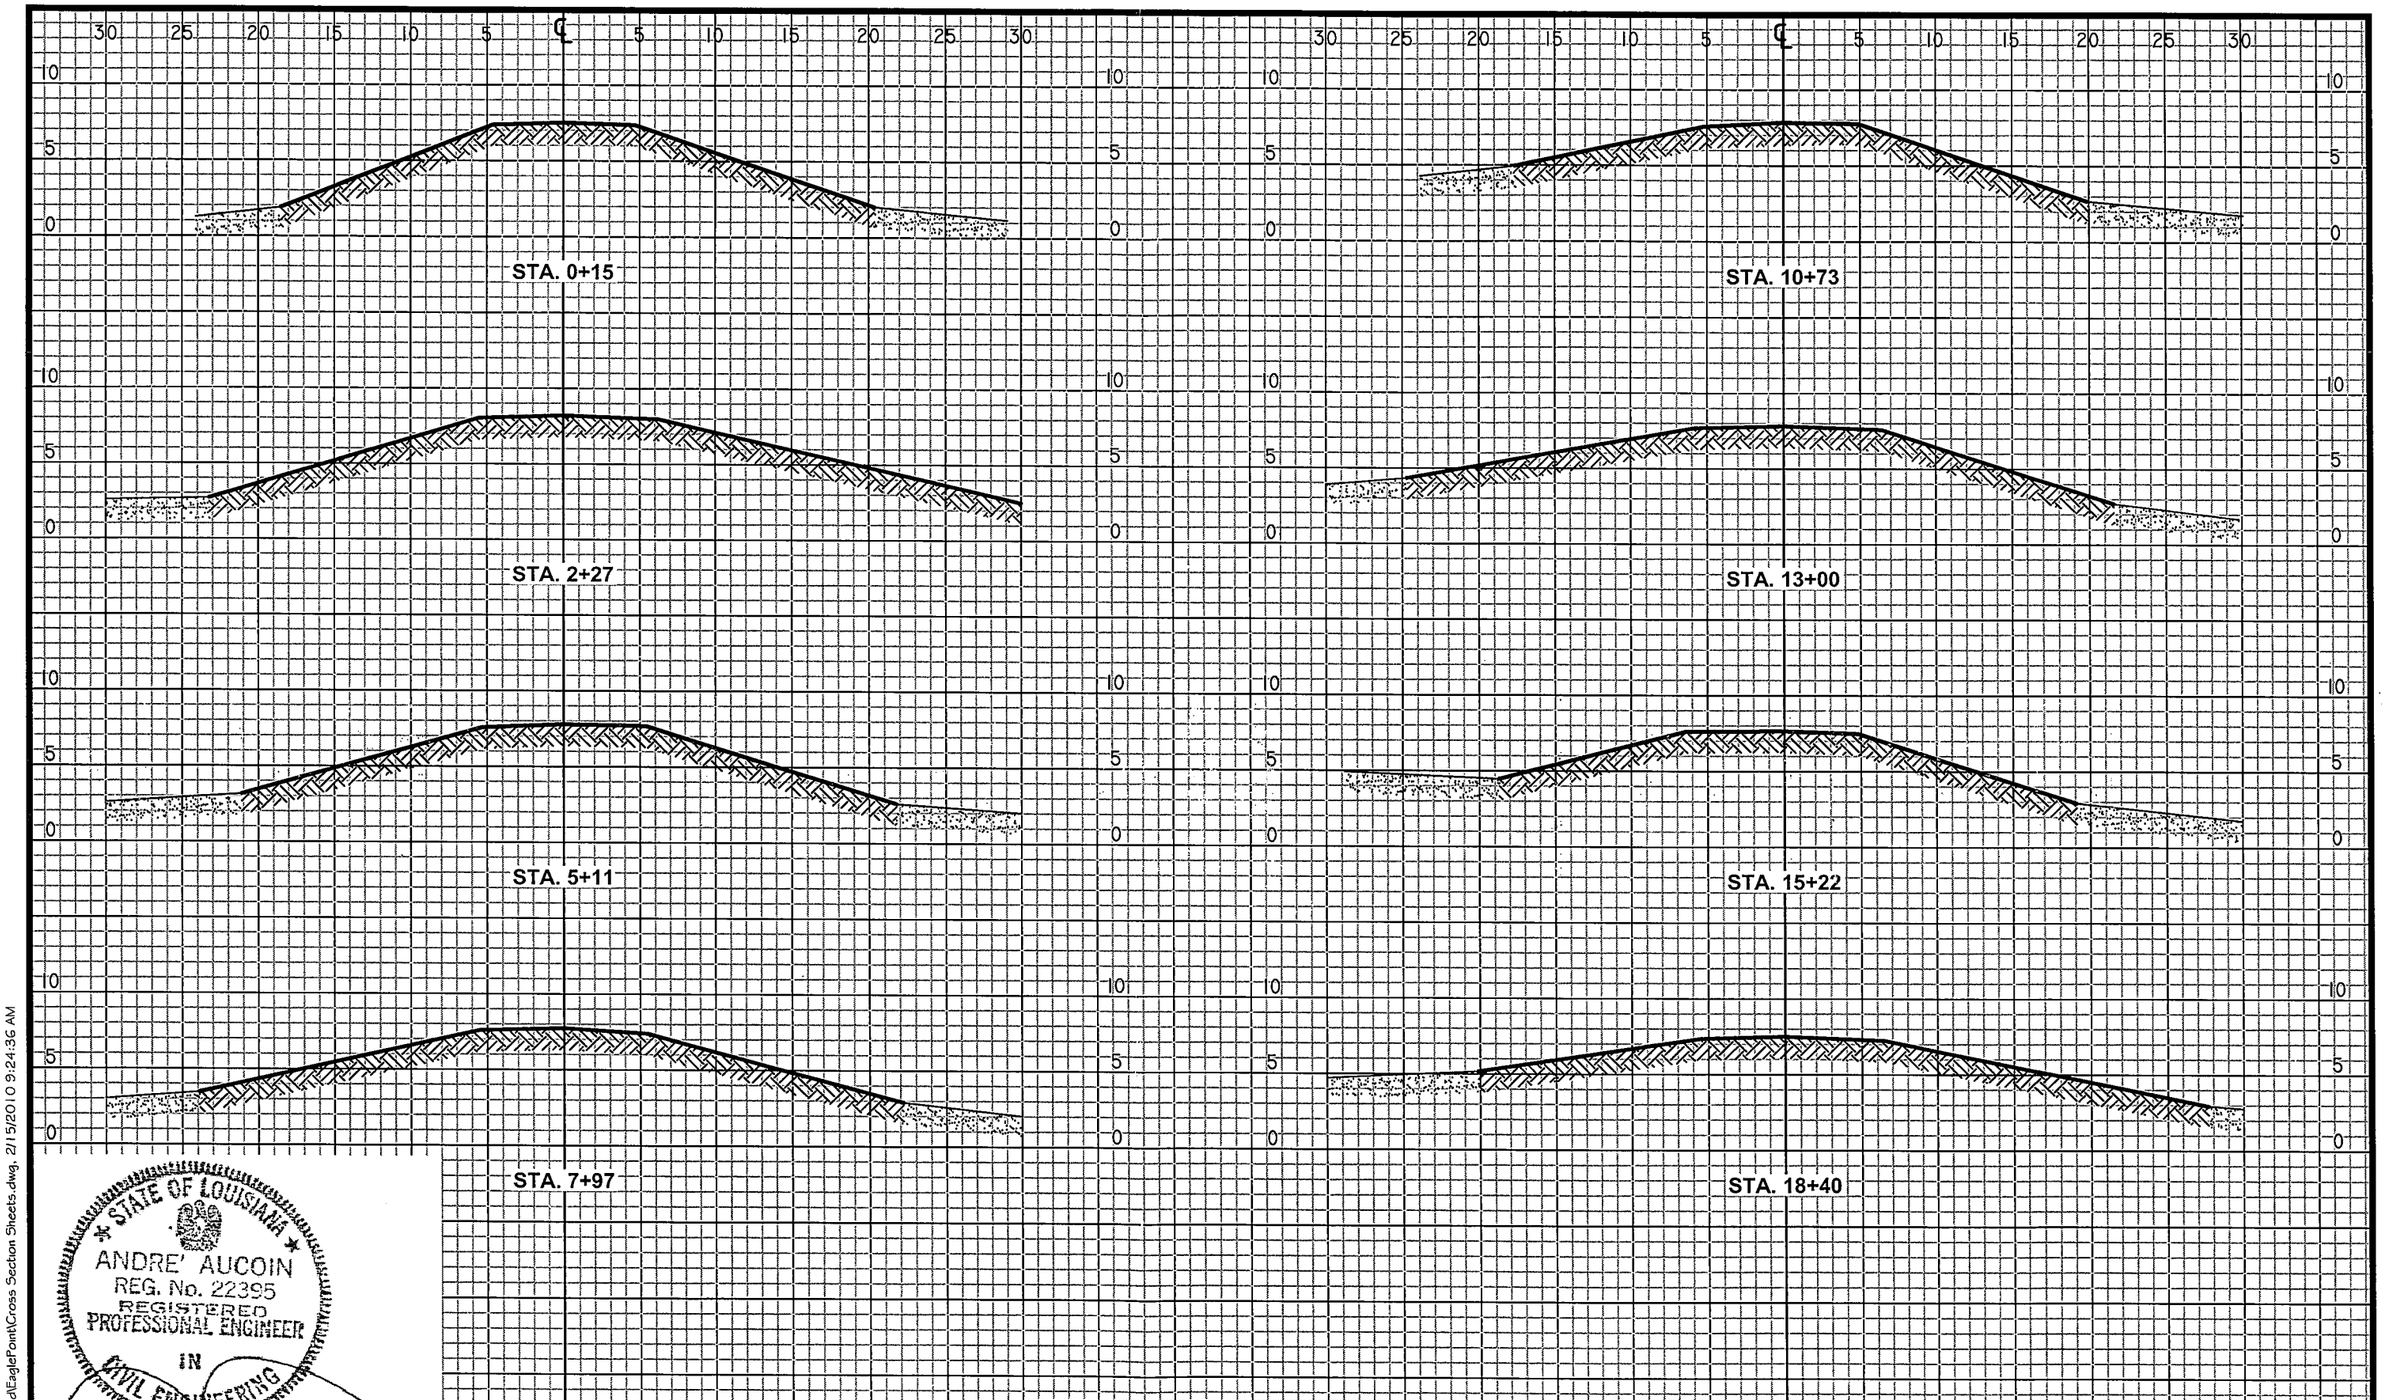

STATE OF LOUISIANA
ANDRE' AUCOIN
REG. No. 22395
REGISTERED
PROFESSIONAL ENGINEER
IN
CIVIL ENGINEERING

HORIZONTAL: 1" = 10'
VERTICAL: 1" = 10'

REV.	DATE	DESCRIPTION	BY

A E inc.
ACADIAN ENGINEERS
ENVIRONMENTAL CONSULTANTS INC.
1601 AMAZON ST.
EUNICE, LOUISIANA
337-457-1493

LOUISIANA DEPARTMENT OF NATURAL RESOURCES
COASTAL ENGINEERING DIVISION
617 NORTH 3RD STREET
BATON ROUGE, LOUISIANA 70802

DRAWN BY: LORI FUSELIER | DESIGNED BY: ANDRE' AUCOIN

RESTORATION OF THE CAMERON CREOLE WATERSHED LEVEE - PHASE I

STATE PROJECT NUMBER: CS-04A-L

FEDERAL PROJECT NUMBER: N/A

APPROVED BY:

ASBUILT
CROSS SECTIONS

DATE: FEBRUARY 2010

SHEET 9 OF 13

G:\07-ae-23G\acad\EaglePoint\Cross Section Sheets.dwg, 2/15/2010 9:24:36 AM

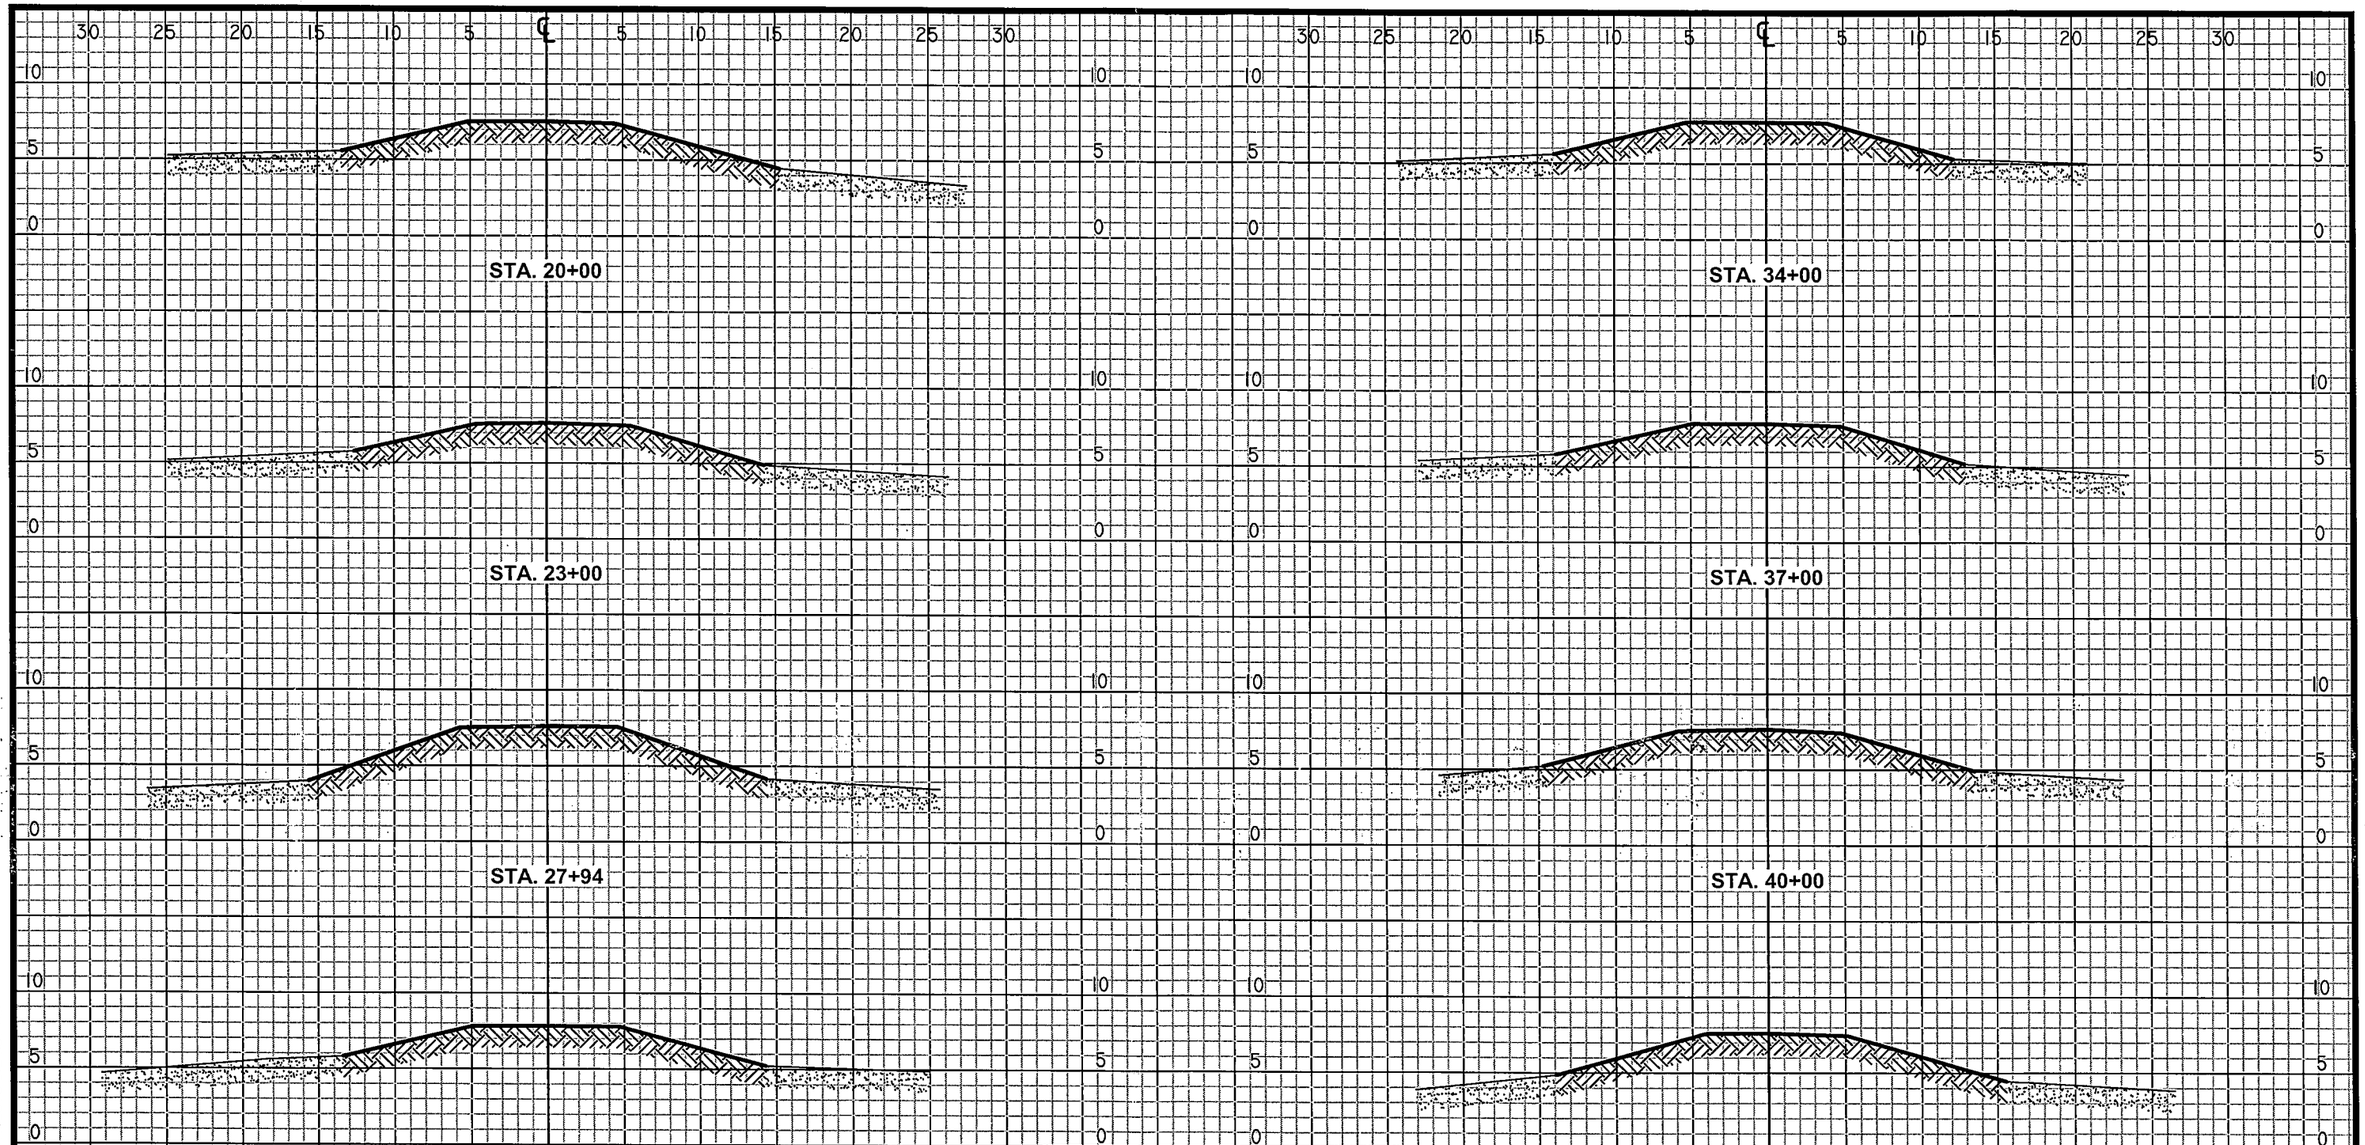

STATE OF LOUISIANA
ANDRE' AUCOIN
REG. No. 22395
REGISTERED
PROFESSIONAL ENGINEER
IN
CIVIL ENGINEERING

HORIZONTAL: 1" = 10'
VERTICAL: 1" = 10'

REV.	DATE	DESCRIPTION	BY

A E inc.
ACADIAN ENGINEERS
&
ENVIRONMENTAL CONSULTANTS INC.
1601 AMAZON ST.
EUNICE, LOUISIANA
337-457-1492

LOUISIANA DEPARTMENT OF NATURAL RESOURCES
COASTAL ENGINEERING DIVISION
617 NORTH 3RD STREET
BATON ROUGE, LOUISIANA 70802

DRAWN BY: LORI FUSELIER
DESIGNED BY: ANDRE' AUCOIN

RESTORATION OF THE CAMERON CREOLE WATERSHED LEVEE - PHASE I

STATE PROJECT NUMBER: CS-04A-L
FEDERAL PROJECT NUMBER: N/A
APPROVED BY:

ASBUILT
CROSS SECTIONS

DATE: FEBRUARY 2010
SHEET 10 OF 13

G:\07-ae-23\Gacad\EaglePoint\Cross Section Sheets.dwg, 2/15/2010 9:24:57 AM

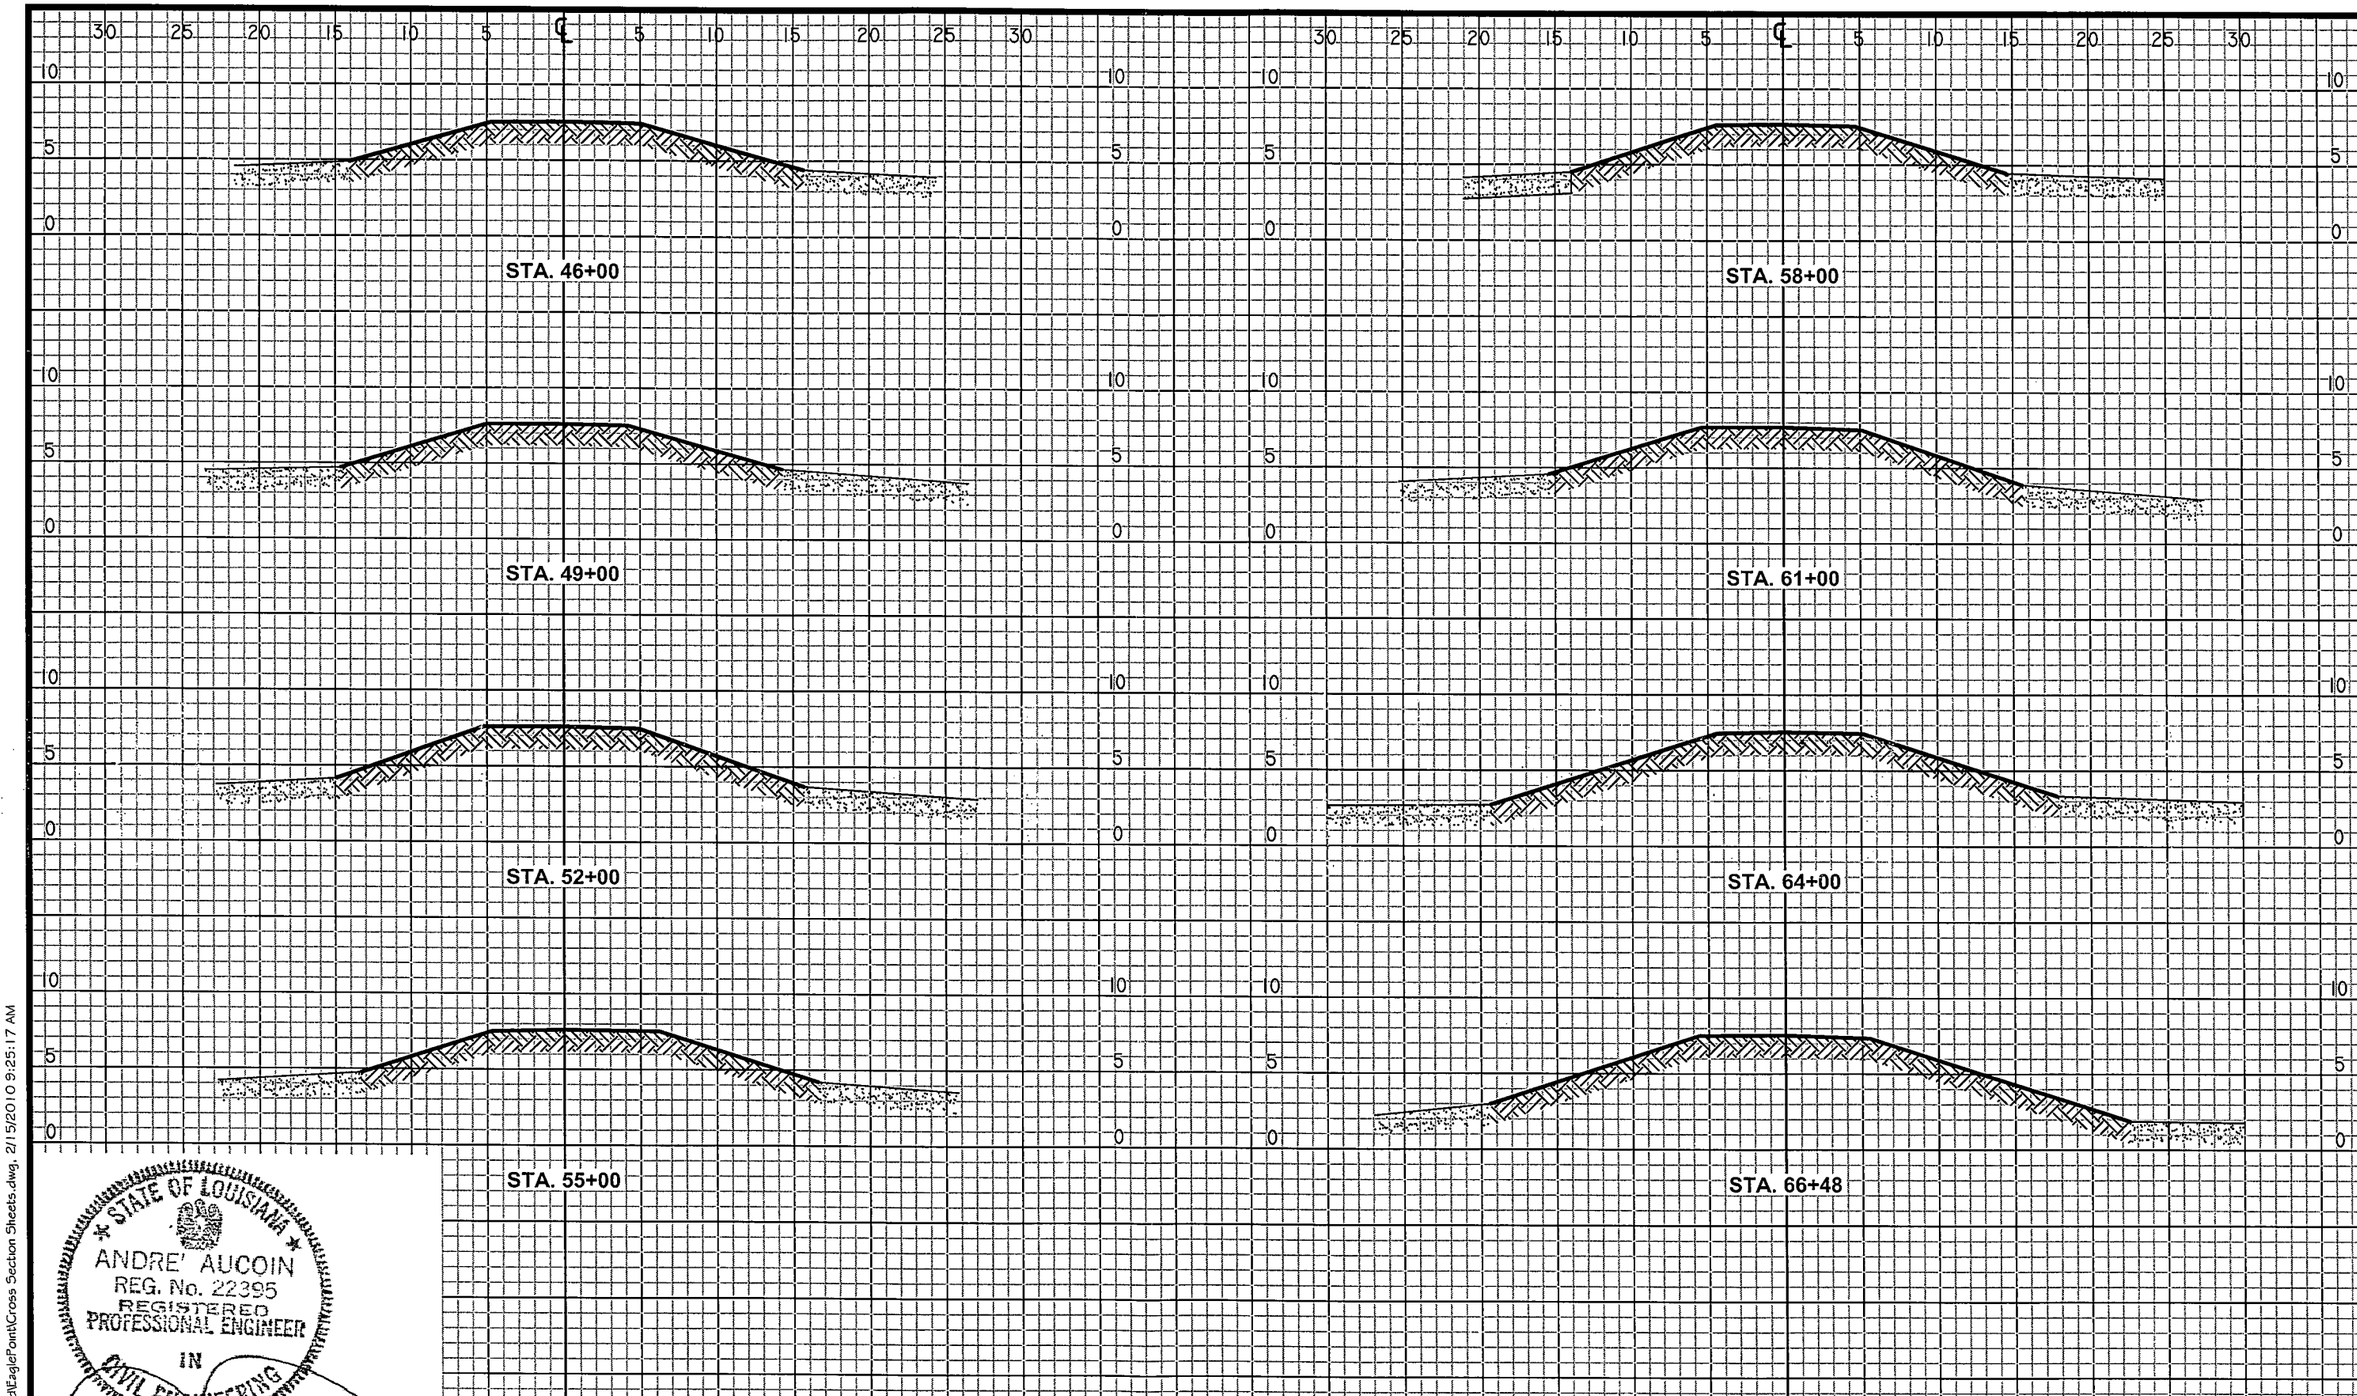

STATE OF LOUISIANA
ANDRE' AUCOIN
REG. No. 22395
REGISTERED
PROFESSIONAL ENGINEER
IN
CIVIL ENGINEERING

HORIZONTAL: 1" = 10'
VERTICAL: 1" = 10'

REV.	DATE	DESCRIPTION	BY

A E inc.
ACADIAN ENGINEERS & ENVIRONMENTAL CONSULTANTS INC.
1601 AMAZON ST.
EUNICE, LOUISIANA
337-457-1492

LOUISIANA DEPARTMENT OF NATURAL RESOURCES
COASTAL ENGINEERING DIVISION
617 NORTH 3RD STREET
BATON ROUGE, LOUISIANA 70802

DRAWN BY: LORI FUSELIER
DESIGNED BY: ANDRE' AUCOIN

RESTORATION OF THE CAMERON CREOLE WATERSHED LEVEE - PHASE I

STATE PROJECT NUMBER: CS-04A-L
FEDERAL PROJECT NUMBER: N/A
APPROVED BY:

ASBUILT
CROSS SECTIONS

DATE: FEBRUARY 2010
SHEET 11 OF 13

G:\07-ae-23\Gacad\EaglePoint\Cross Section Sheets.dwg, 2/15/2010 9:25:17 AM

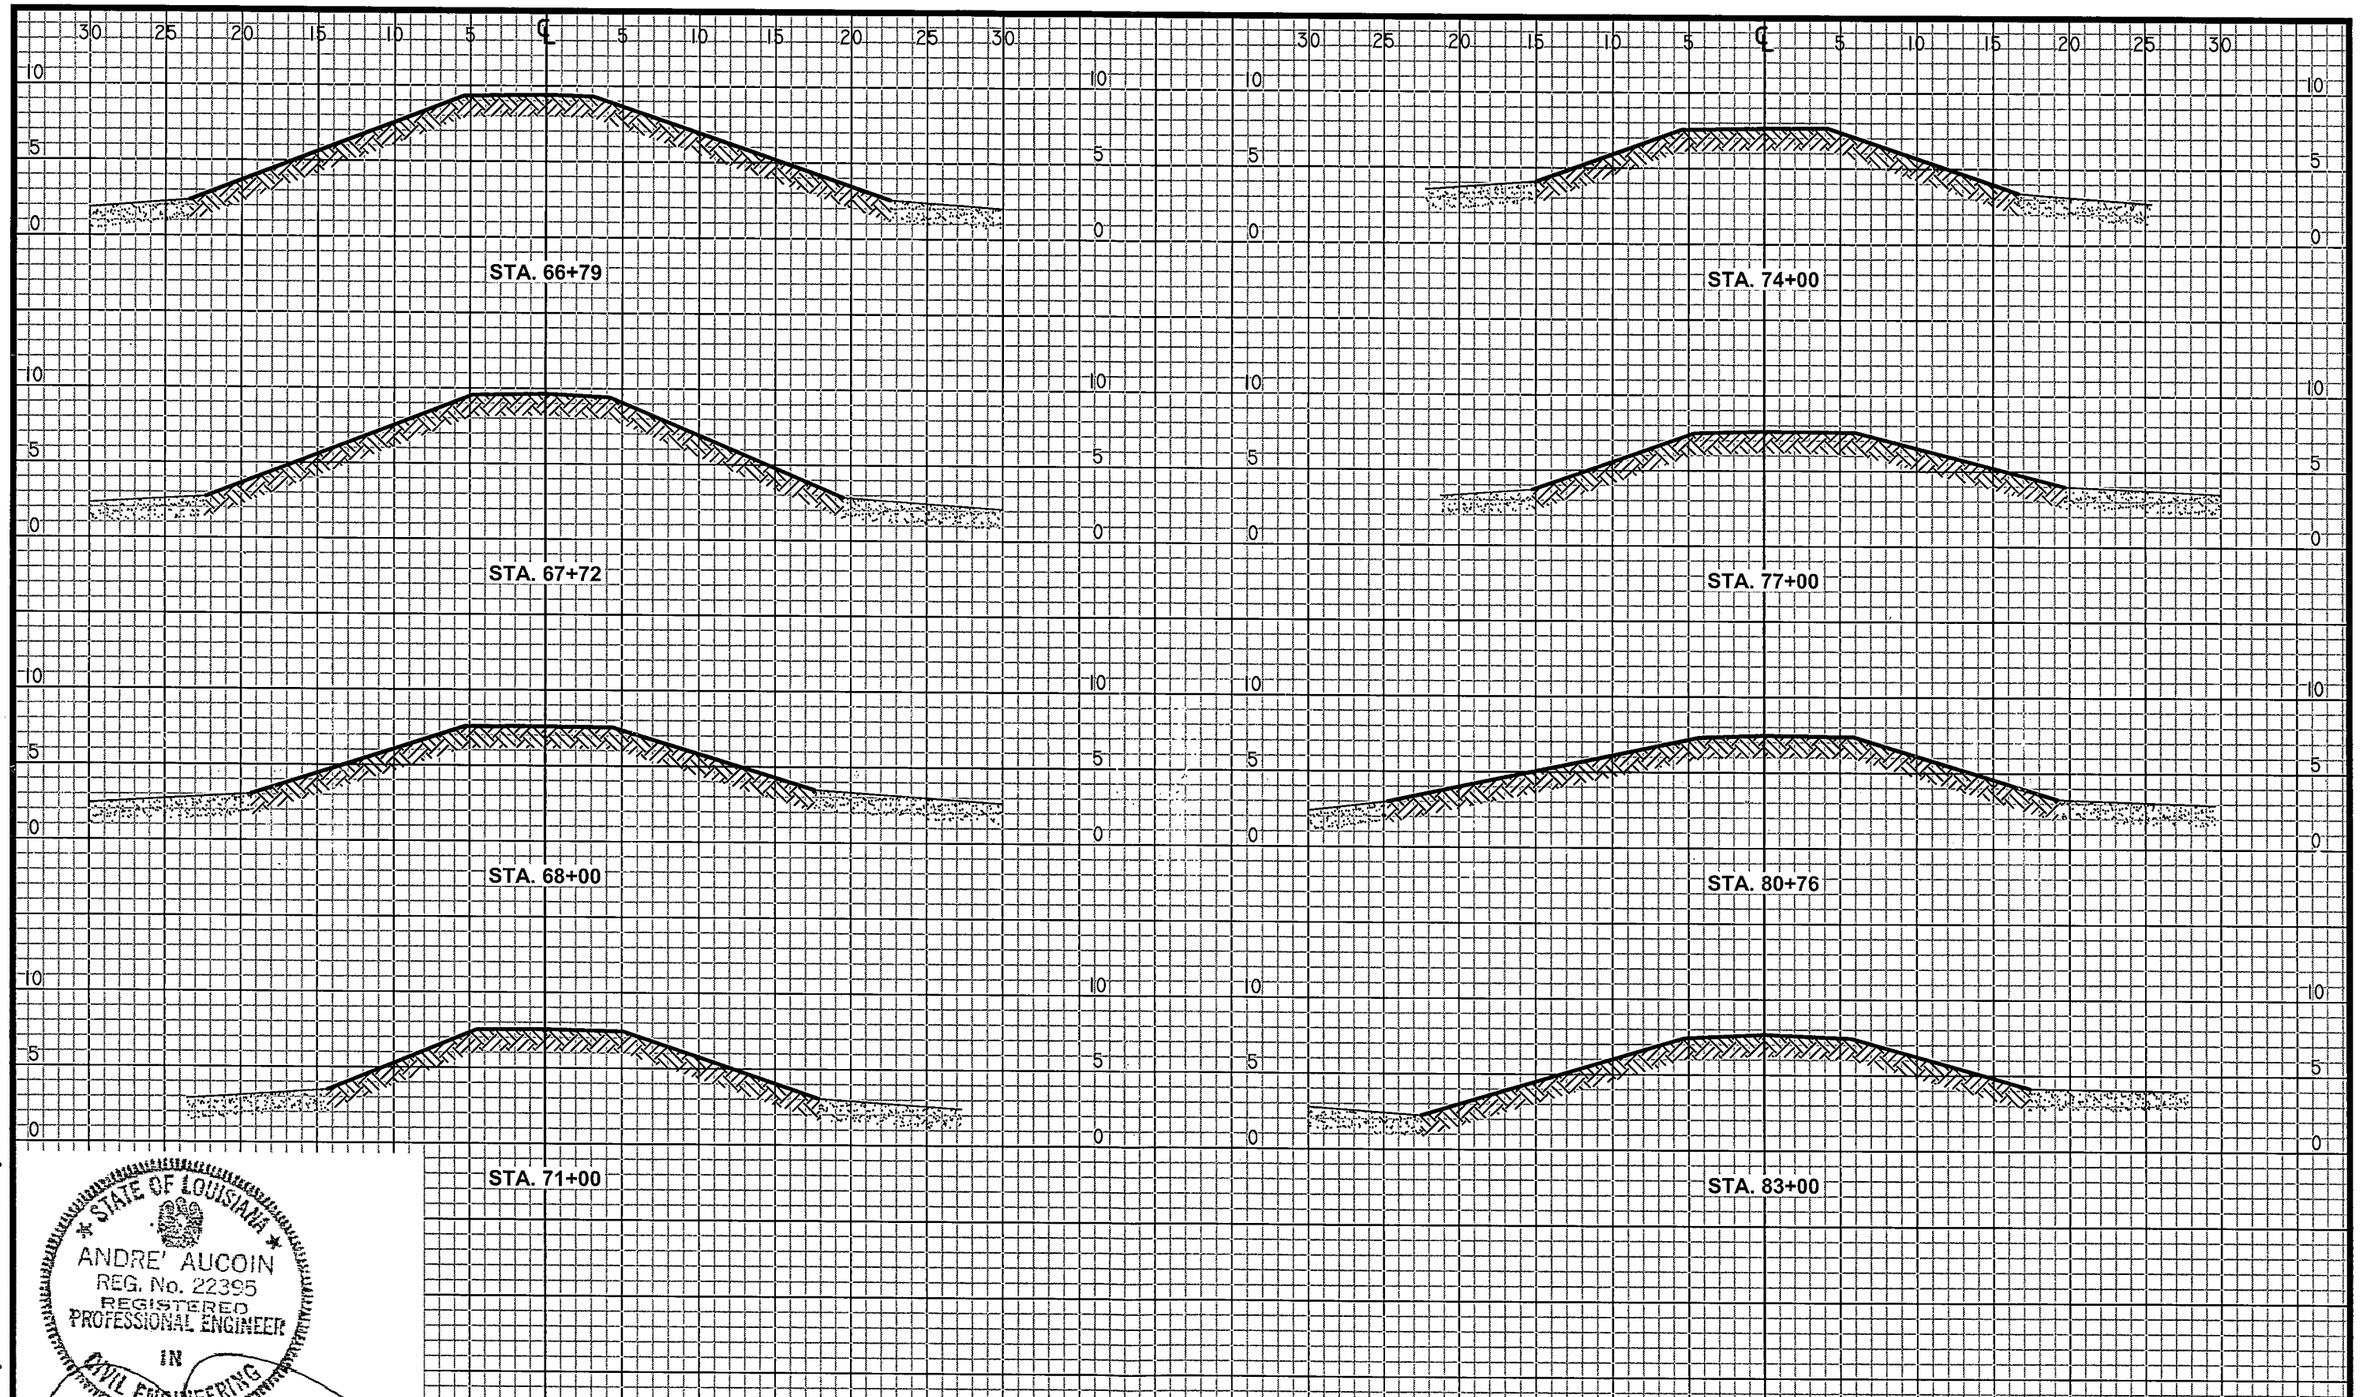

STATE OF LOUISIANA
ANDRE' AUCOIN
REG. No. 22395
REGISTERED
PROFESSIONAL ENGINEER
IN
CIVIL ENGINEERING

HORIZONTAL: 1" = 10'
VERTICAL: 1" = 10'

REV.	DATE	DESCRIPTION	BY

A E inc.
ACADIAN ENGINEERS & ENVIRONMENTAL CONSULTANTS INC.
1601 AMAZON ST.
EUNICE, LOUISIANA
337-457-1492

LOUISIANA DEPARTMENT OF NATURAL RESOURCES
COASTAL ENGINEERING DIVISION
617 NORTH 3RD STREET
BATON ROUGE, LOUISIANA 70802

DRAWN BY: LORI FUSELIER
DESIGNED BY: ANDRE' AUCOIN

RESTORATION OF THE CAMERON CREOLE WATERSHED LEVEE - PHASE I

STATE PROJECT NUMBER: CS-04A-L
FEDERAL PROJECT NUMBER: N/A
APPROVED BY:

ASBUILT
CROSS SECTIONS

DATE: FEBRUARY 2010
SHEET 12 OF 13

G:\07-ae-23\acad\EaglePoint\Cross Section Sheets.dwg, 2/15/2010 9:25:42 AM